

STEVENS
GLEN ALDEN COAL CO.
FEE

PRICE-PANCOAST COAL CO.

PENNA. COAL CO.
JOS. HORSEFIELD

LUZERNE COAL CO.

DOLPH & PORTER

PENNA. COAL CO.
GILBERT DUNNING


BOWMAN

SCRANTON COAL CO.

H.B. ROCKWELL

CAYUGA
AND
SUSQUEHANNA
GLEN ALDEN COAL CO.

POSTING DATES				DATE OF SURVEY			
FIRST MINING		ROBBING		FIRST MINING		ROBBING	
Date	By Whom	Date	By Whom	Leggitts Creek	Marvine		
1-18-23	M. O.	1-18-23	M. O.	2-17-21	2-21	5-23-21	5-21
5-10-23	K. B.	5-10-23	K. B.	3-5-37	2-37	12-1-32	12-32
12-3-23	K. B.	12-3-23	K. B.	3-8-38	2-38	1-22-32	1-32
4-21-25	W. G.	4-21-25	W. G.	2-18-39	2-39	5-21-35	5-35
12-18-24	K. B.	12-18-24	K. B.	2-21-40	2-40	2-18-36	2-36
10-11-26	H. M. D.	10-11-26	H. M. D.	2-22-41	2-41	3-8-38	2-38
4-28-27	E. S.	4-28-27	E. S.	2-22-42	2-42		2-42
10-1-27	E. S.	10-1-27	E. S.	11-25-42	12-42		2-42
5-26-28	E. S.	5-26-28	E. S.	11-25-42	12-42	11-25-42	12-42
5-1-29	E. J. S.	5-1-29	E. J. S.	12-20-44	12-44	2-44	2-44
5-8-30	E. J. S.	5-8-30	E. J. S.		2-48	12-48	12-48

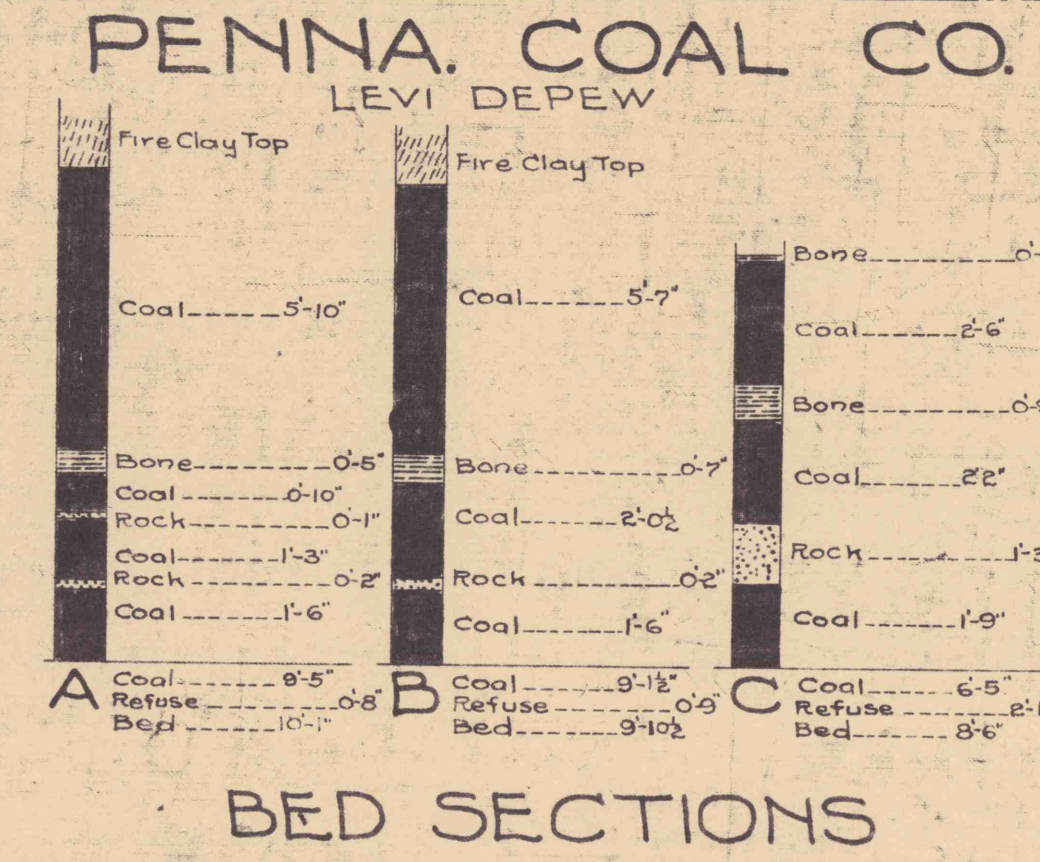

THE HUDSON COAL CO.
MARVINE COLLIERY
WORKINGS IN THE
DIAMOND BED
SCALE 1"=400'

OFFICE OF
FORECAST DEPT.
SCRANTON, PA.
APRIL, 19