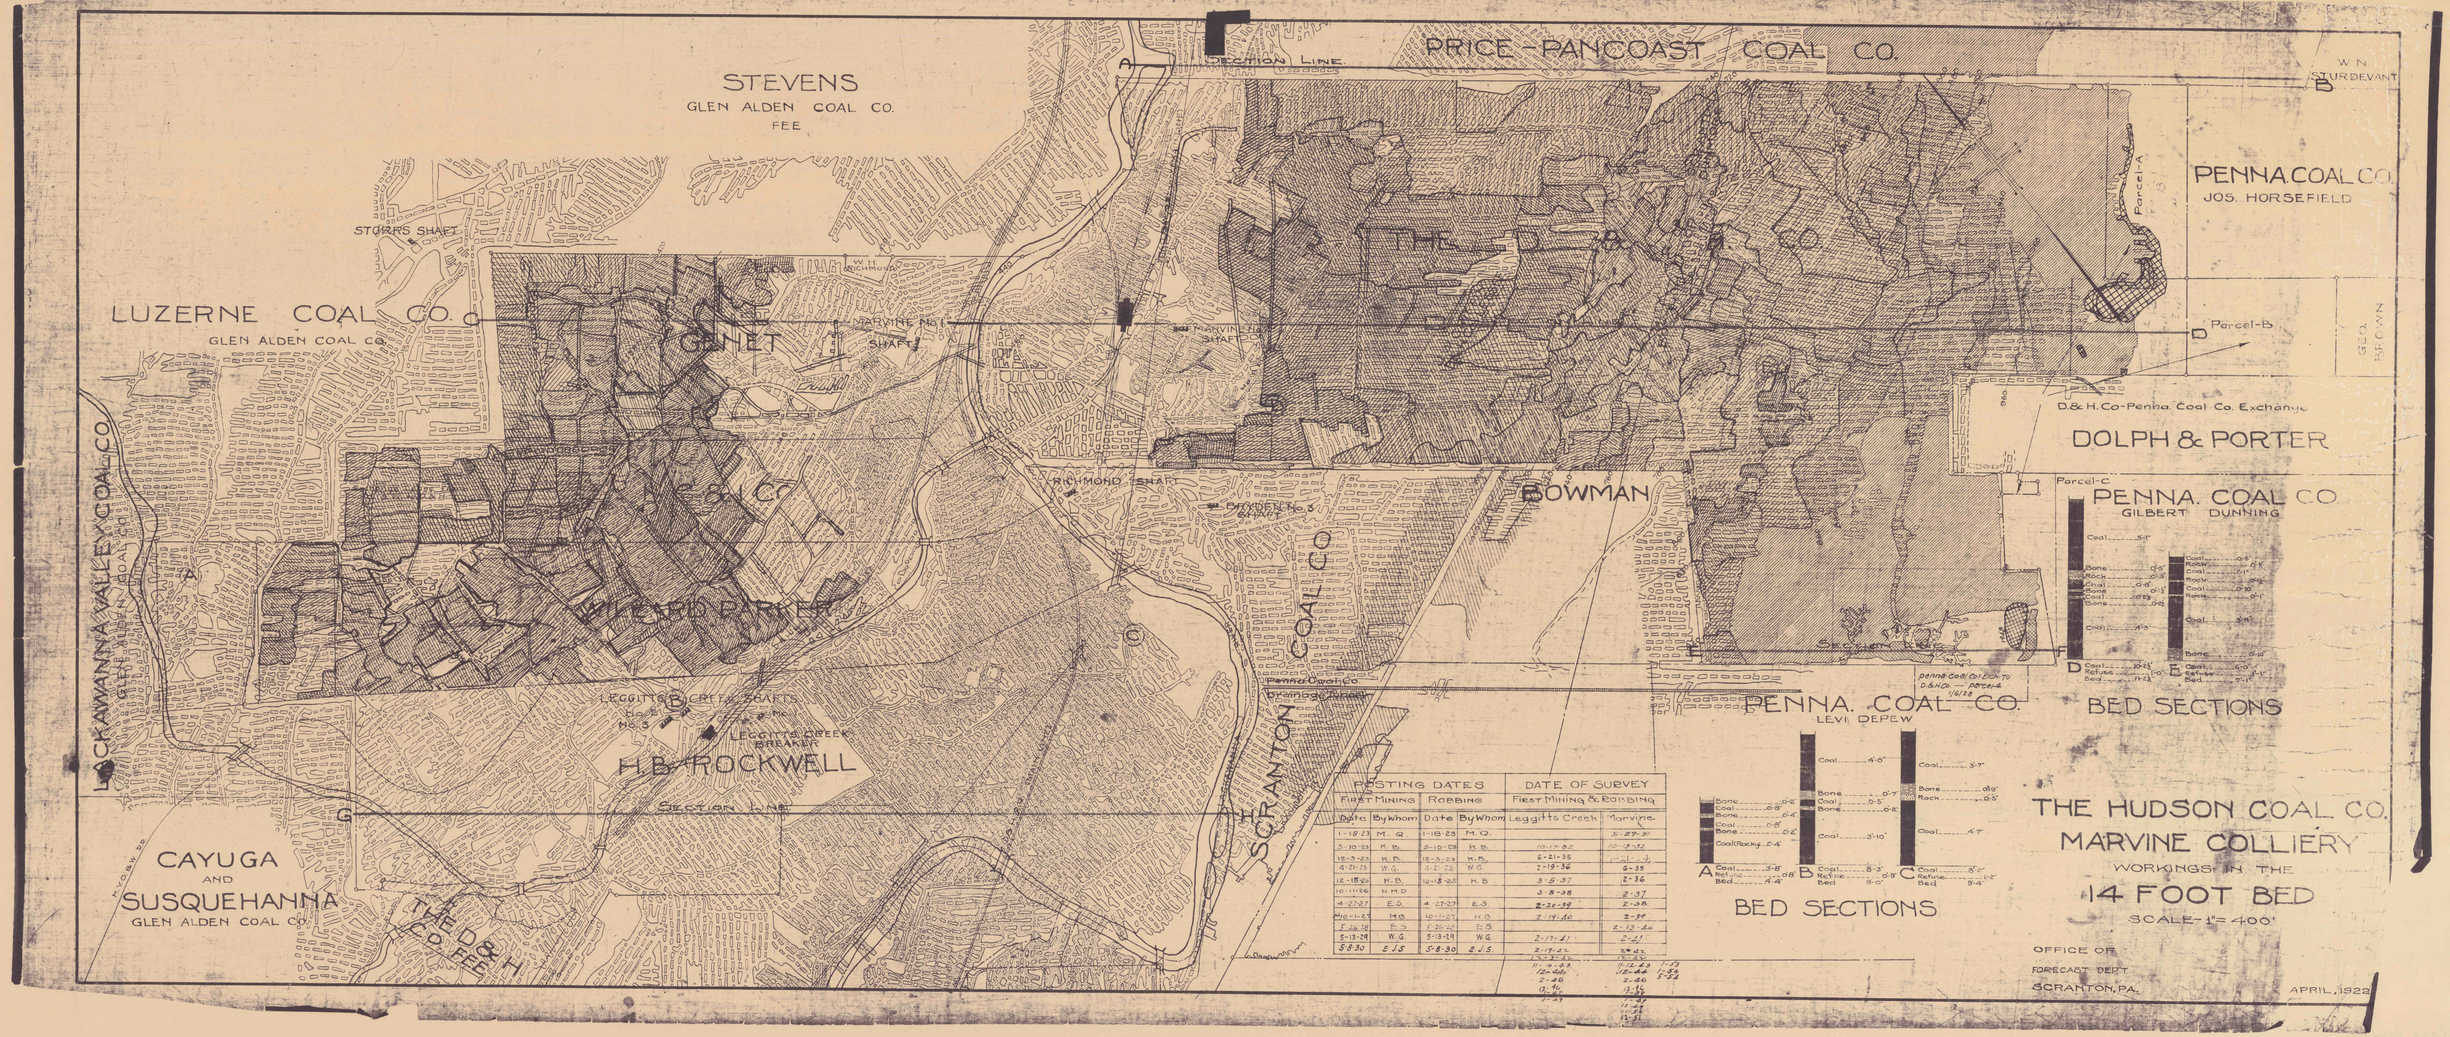

POSTING DATES				DATE OF SURVEY	
First Mining		Robbins		First Mining & Robbing	
Date	By Whom	Date	By Whom	Leggitts Creek	Marvine
1-18-23	M. Q.	1-18-23	M. Q.		3-27-31
5-10-23	K. B.	5-10-23	K. B.	10-17-32	10-9-32
12-3-23	K. B.	12-3-23	K. B.	6-21-35	[illegible]
4-21-25	W. G.	5-2-25	W. G.	2-18-32	6-35
12-15-25	H. B.	12-15-25	H. B.	3-5-31	2-36
10-11-26	N. M. D.			3-8-28	2-37
4-27-27	E. S.	4-27-27	E. S.	2-20-38	2-38
10-1-27	H. Q.	10-1-27	H. Q.	2-19-40	2-39
6-26-28	E. S.	6-26-28	E. S.		2-13-40
5-13-29	W. G.	5-13-29	W. G.	2-17-41	2-41
5-8-30	E. J. S.	5-8-30	E. J. S.	2-19-42	2-42
				10-3-43	10-3-43
				11-12-43	11-12-43
				12-4-46	12-4-46
				2-46	2-46
				8-46	1-55
				7-47	5-55
					11-47
					11-51
					11-52
					12-52