

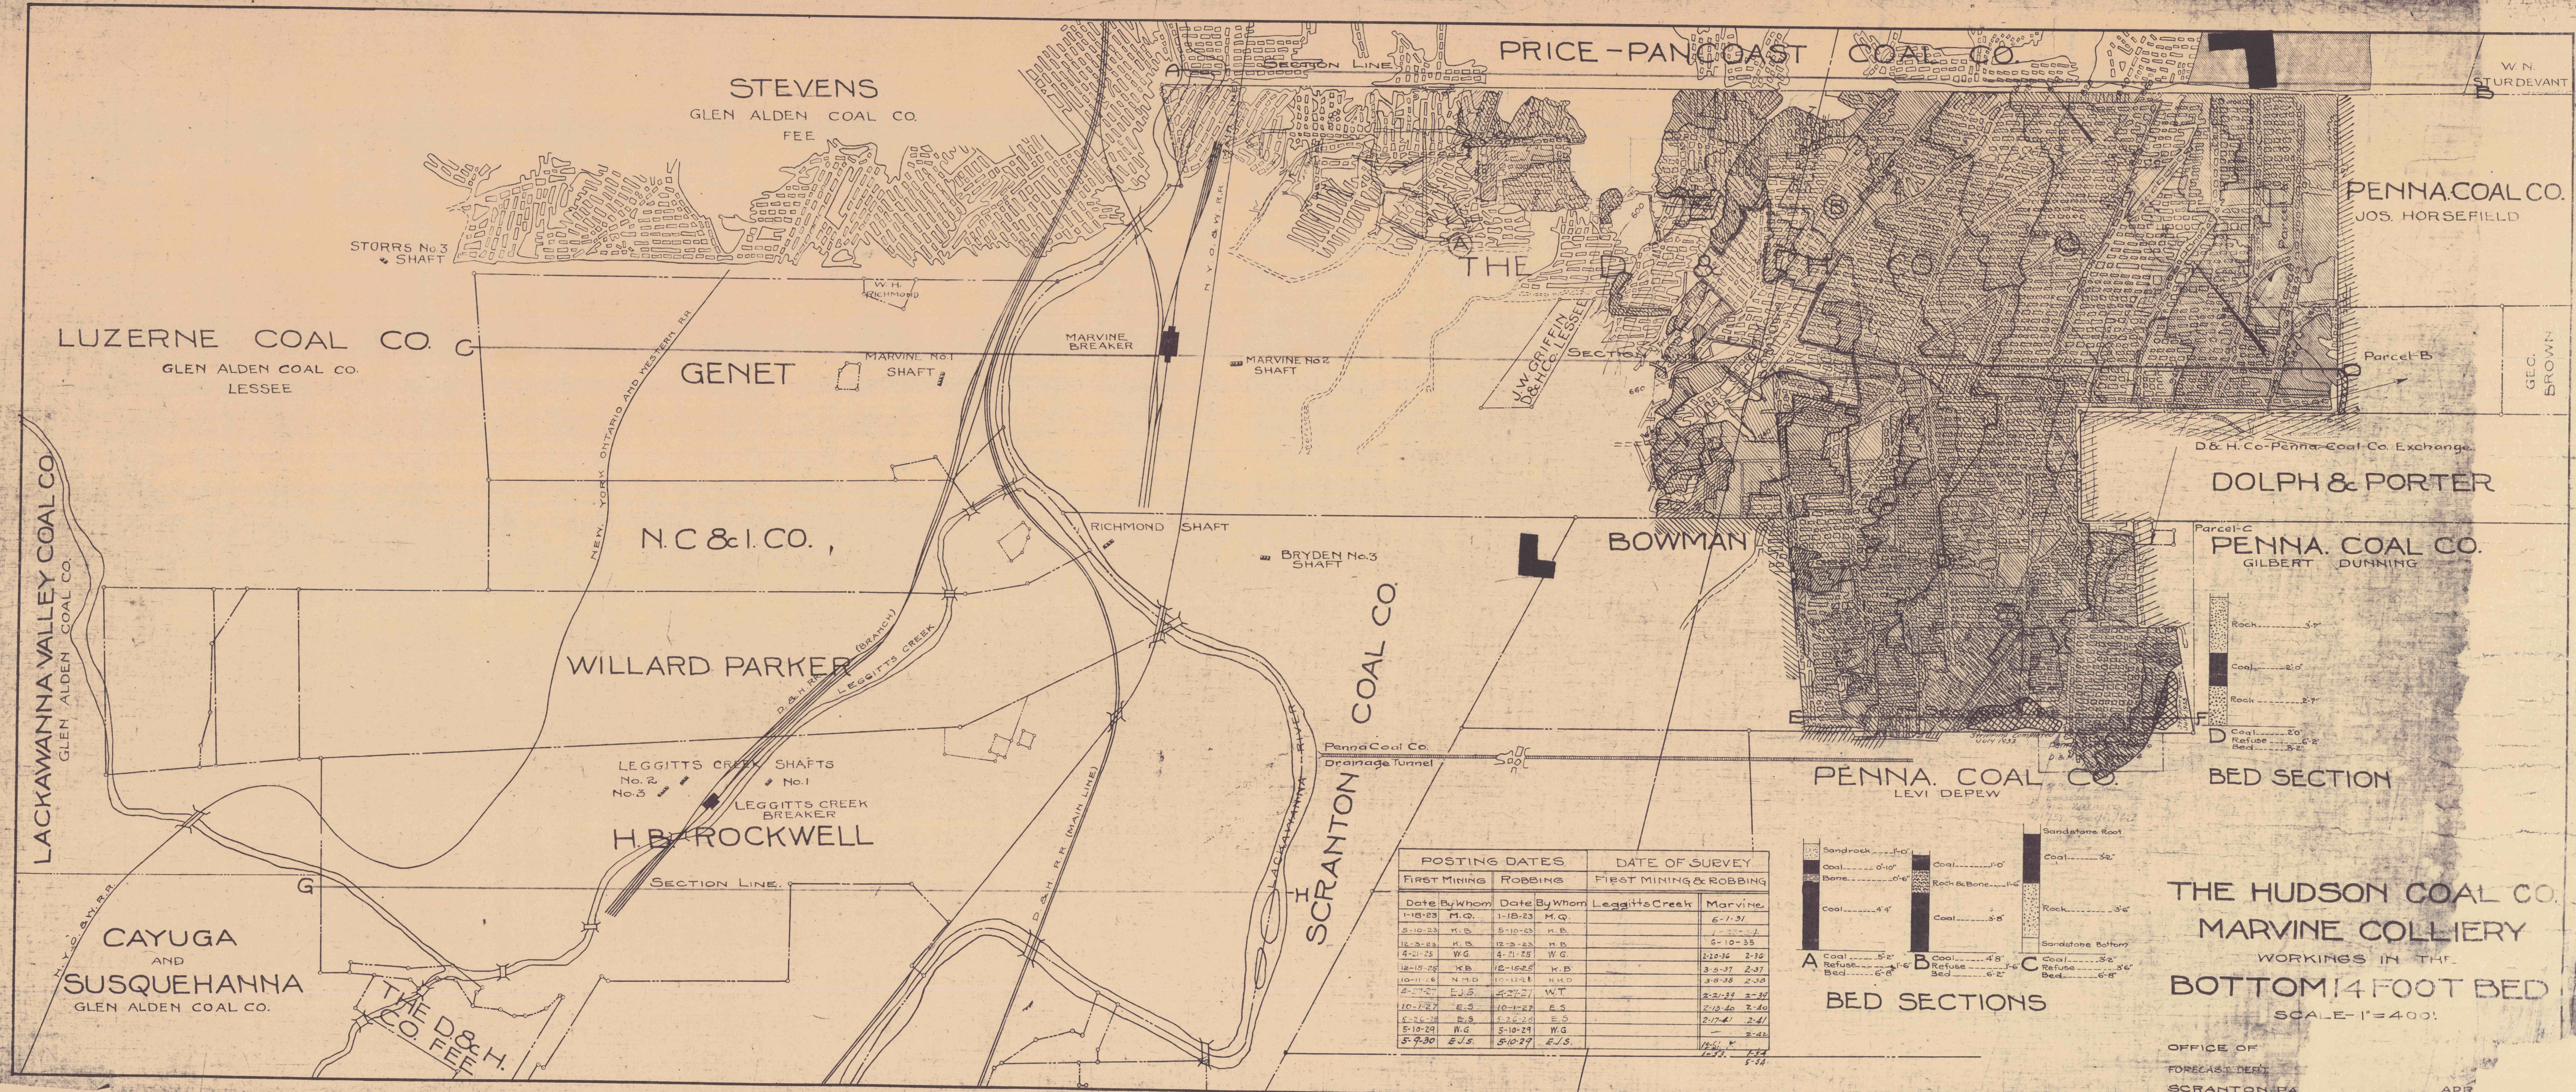


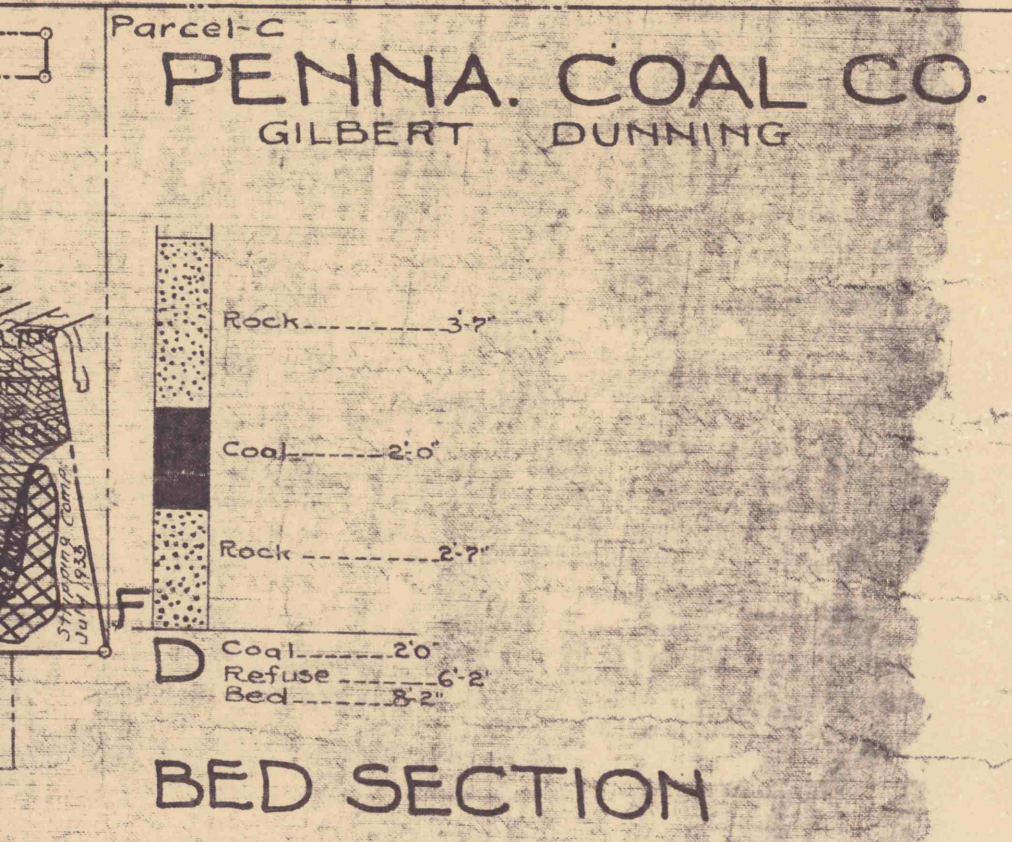

POSTING DATES		DATE OF SURVEY	
FIRST MINING	ROBBING	FIRST MINING	ROBBING
Date By Whom	Date By Whom	Leggitts Creek	Marvine
1-18-23 M.G.	1-18-23 M.G.		6-1-31
5-10-23 M.B.	5-10-23 M.B.		1-1-35
12-3-23 M.B.	12-3-23 M.B.		5-10-35
4-1-23 W.G.	4-1-23 W.G.		2-20-36
12-15-23 W.B.	12-15-23 W.B.		3-5-37
10-11-24 N.H.D.	10-11-24 N.H.D.		9-9-38
4-27-27 E.J.S.	4-27-27 W.T.		2-21-39
10-12-27 E.S.	10-12-27 E.S.		2-18-40
5-26-28 E.S.	5-26-28 E.S.		2-17-41
5-10-29 W.G.	5-10-29 W.G.		2-4-42
5-9-30 E.J.S.	5-10-29 E.J.S.		1-5-44

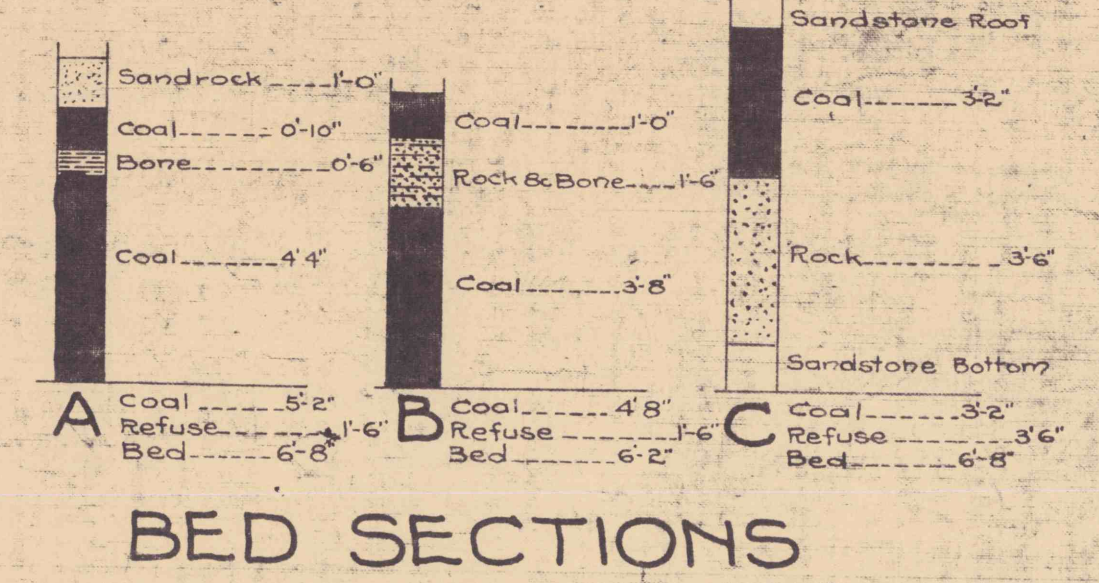

THE HUDSON COAL CO.
MARVINE COLLIERY
WORKINGS IN THE
BOTTOM 4 FOOT BED
SCALE-1"=400'

OFFICE OF
FORECAST DEPT.
SCRANTON, PA.
APR