


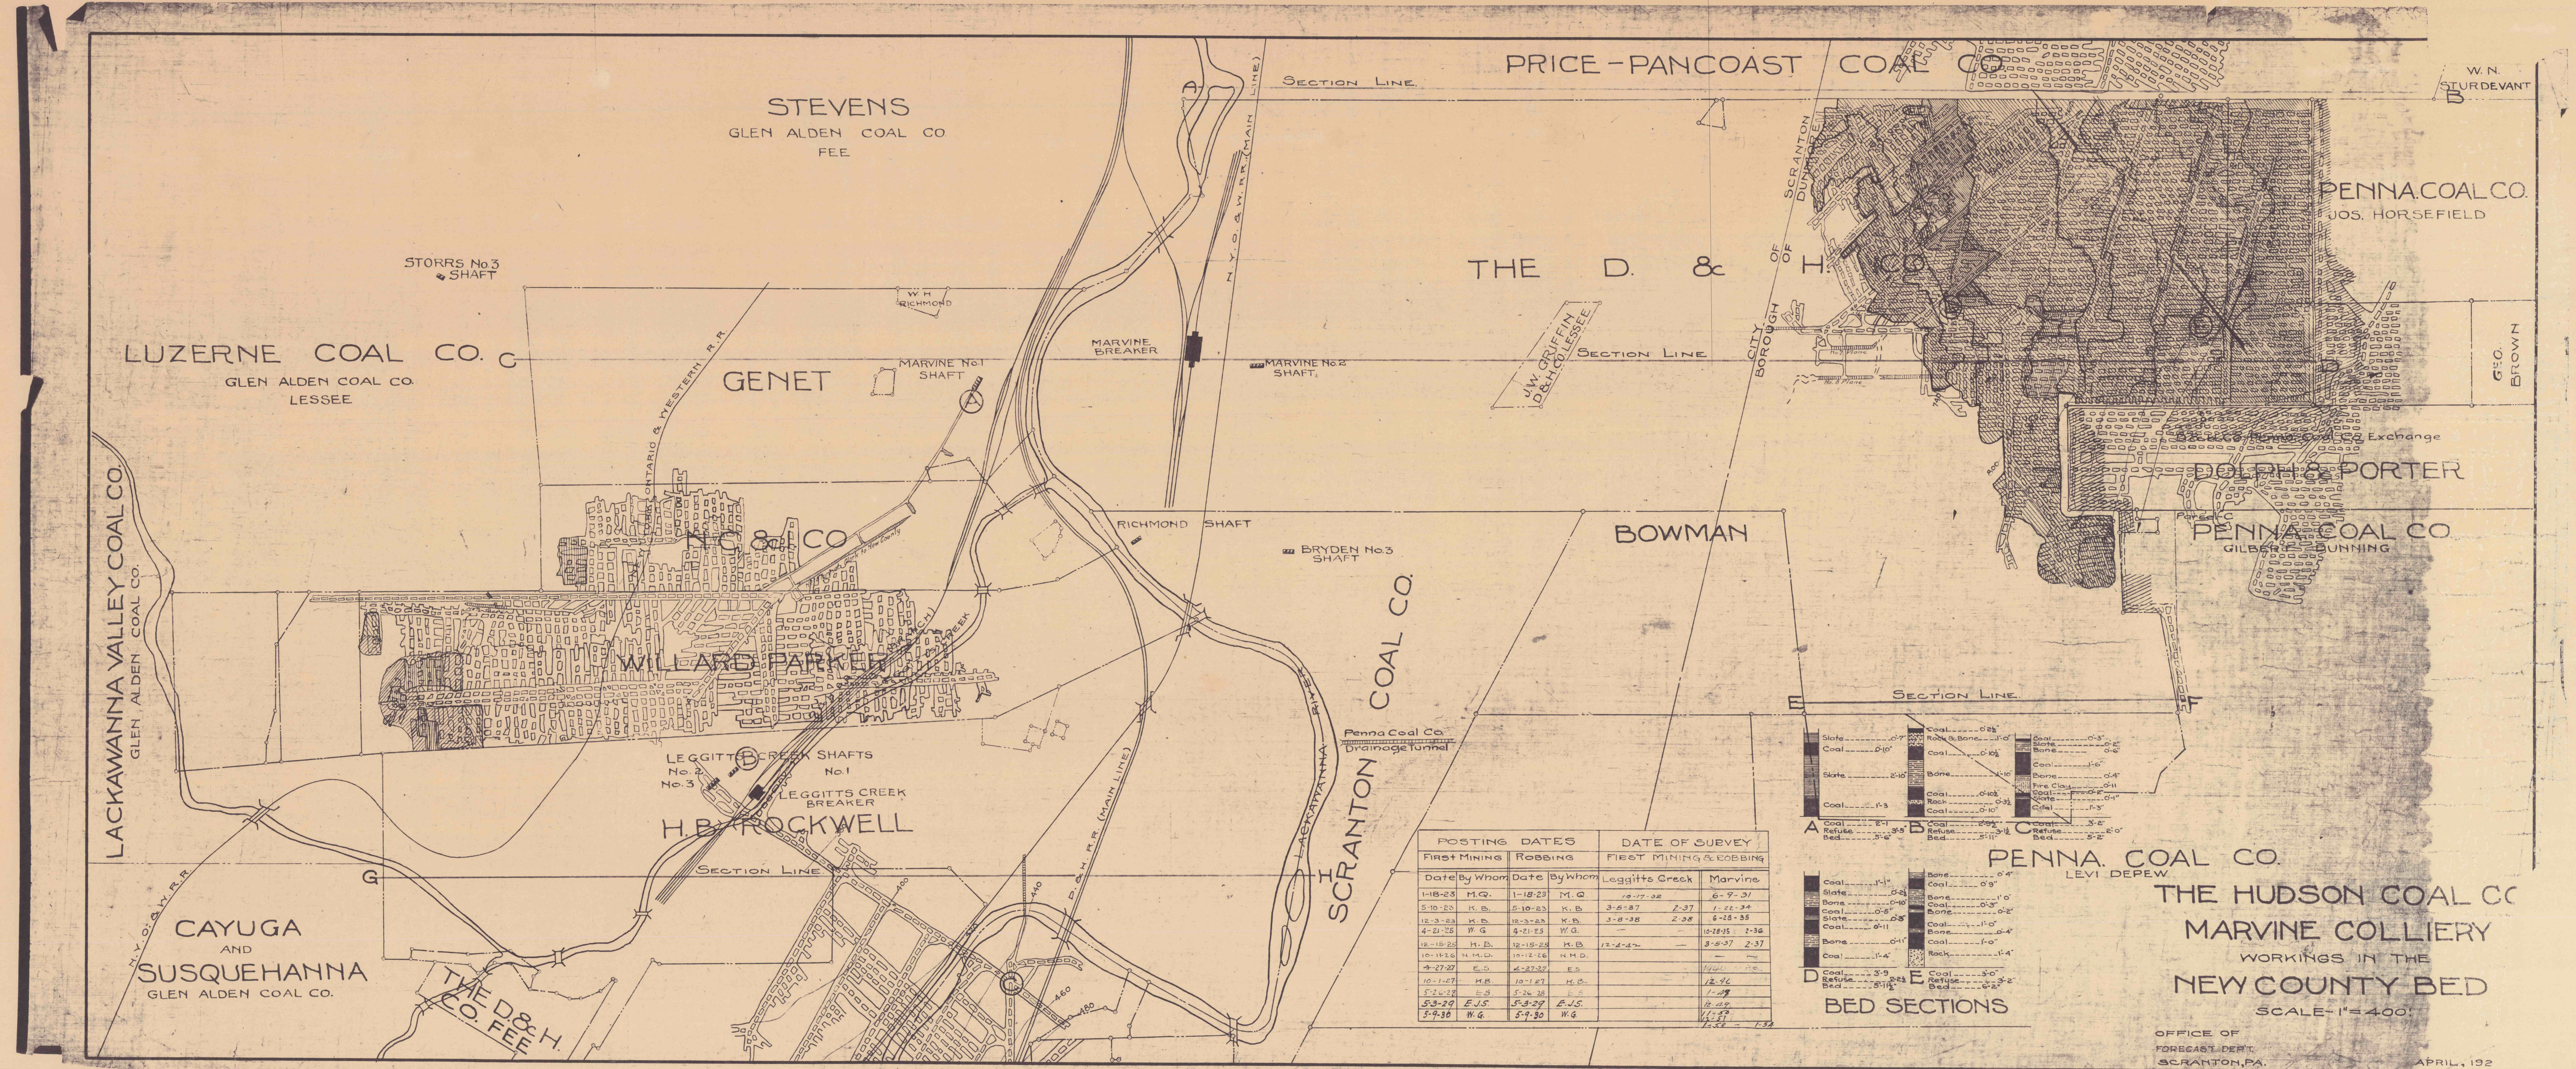

POSTING DATES				DATE OF SURVEY	
First Mining	Robbing	First Mining	Robbing	First Mining	Robbing
Date By Whom	Date By Whom	Leggitts Creek	Marvine		
11-18-23 H.B.	1-18-23 M.G.	12-17-22	6-9-31		
5-10-23 H.B.	5-10-23 K.B.	3-5-27	2-37	1-21-34	
12-3-23 H.B.	12-3-23 K.B.	3-8-28	2-38	8-28-38	
4-21-23 W.G.	4-21-23 W.G.			10-28-35	2-34
12-18-23 H.B.	12-18-23 H.B.			3-5-37	2-37
10-18-23 H.M.D.	10-18-23 H.M.D.	12-4-22			
4-27-27 E.S.	4-27-27 E.S.			11-11-27	
10-1-27 H.B.	10-1-27 H.B.			12-26	
5-2-27 E.S.	5-2-27 E.S.			1-29	
5-3-29 E.J.S.	5-3-29 E.J.S.			12-29	
5-9-30 W.G.	5-9-30 W.G.			11-28	
				12-28	1-34

BED SECTIONS		
A	B	C
Slate.....0'7"	Coal.....0'2"	Coal.....0'3"
Coal.....0'10"	Rock & Bone.....1'0"	Slate.....0'5"
Slate.....2'10"	Coal.....0'10"	Bone.....0'5"
Coal.....1'3"	Bone.....1'10"	Coal.....1'5"

PENNA. COAL CO.
LEVI DEWEY
THE HUDSON COAL CO.
MARVINE COLLIERY
WORKINGS IN THE
NEW COUNTY BED
SCALE-1"=400'