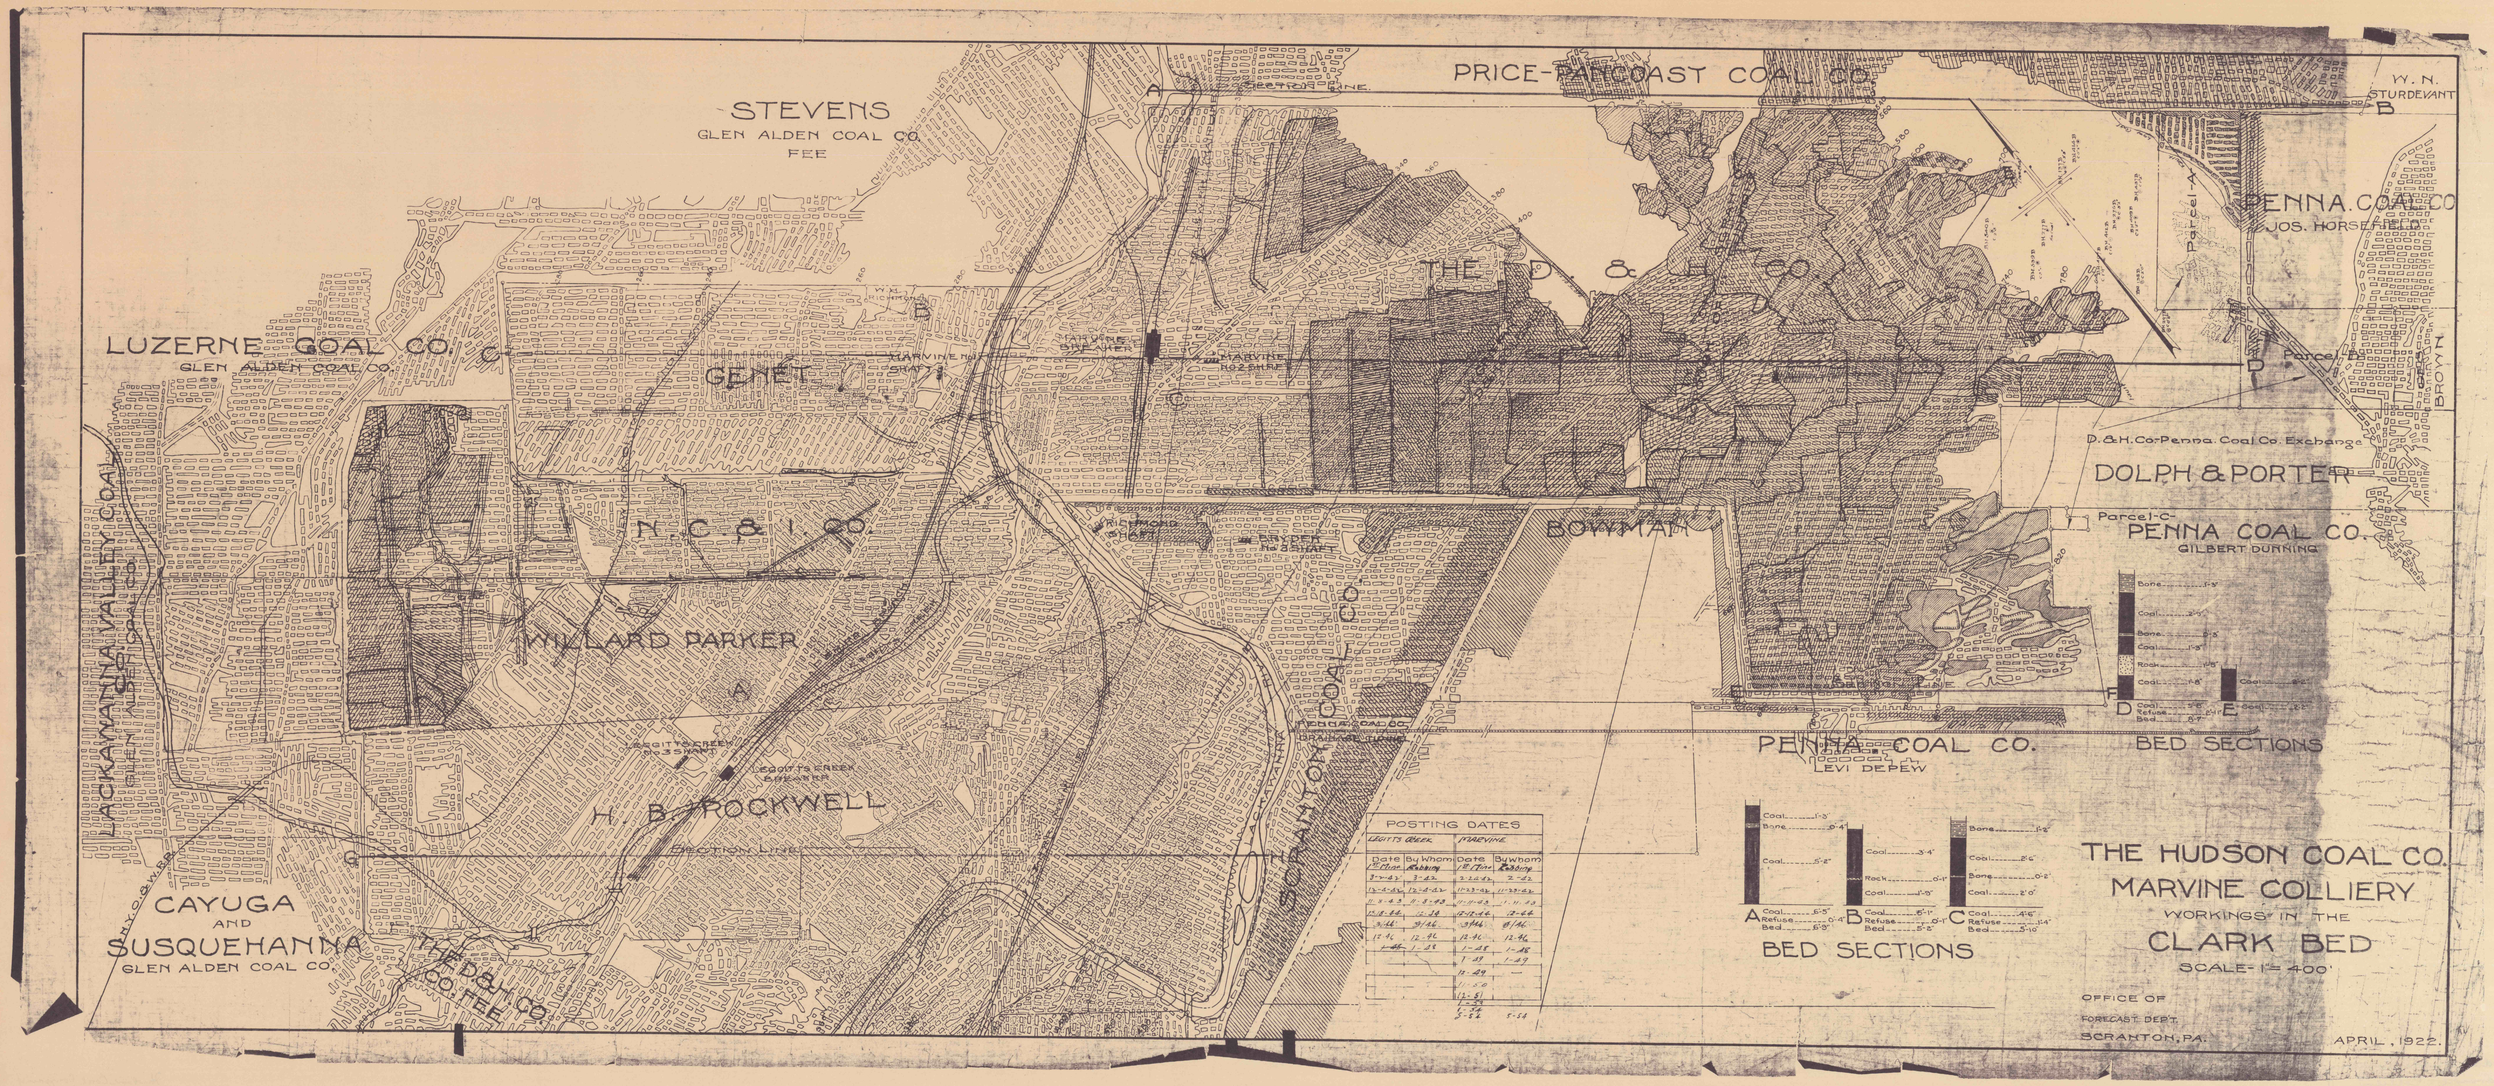
PRICE-PANCOAST COAL CO.
W. N. STURDEVANT
STEVENS
GLEN ALDEN COAL CO.
FEE
LUZERNE COAL CO.
GLEN ALDEN COAL CO.
GENET
N. C. & I. CO.
WILLARD PARKER
H. B. ROCKWELL
SECTION LINE
CAYUGA AND SUSQUEHANNA
GLEN ALDEN COAL CO.
THE D. & H. CO.
FEE
THE D. & H. CO.
BOWMAN
SCRANTON COAL CO.
PENNA. COAL CO.
JOS. HORSEFIELD
Parcel-A
Parcel-B
BROWN
D. & H. Co-Penna. Coal Co. Exchange
DOLPH & PORTER
Parcel-C
PENNA COAL CO.
GILBERT DURNING
PENNA. COAL CO.
LEVI DEPEW
BED SECTIONS
POSTING DATES
LEGITTS CREEK
MARVINE
THE HUDSON COAL CO.
MARVINE COLLIERY
WORKINGS IN THE
CLARK BED
SCALE-1" = 400'
OFFICE OF
FORECAST DEPT.
SCRANTON, PA.
APRIL, 1922.