


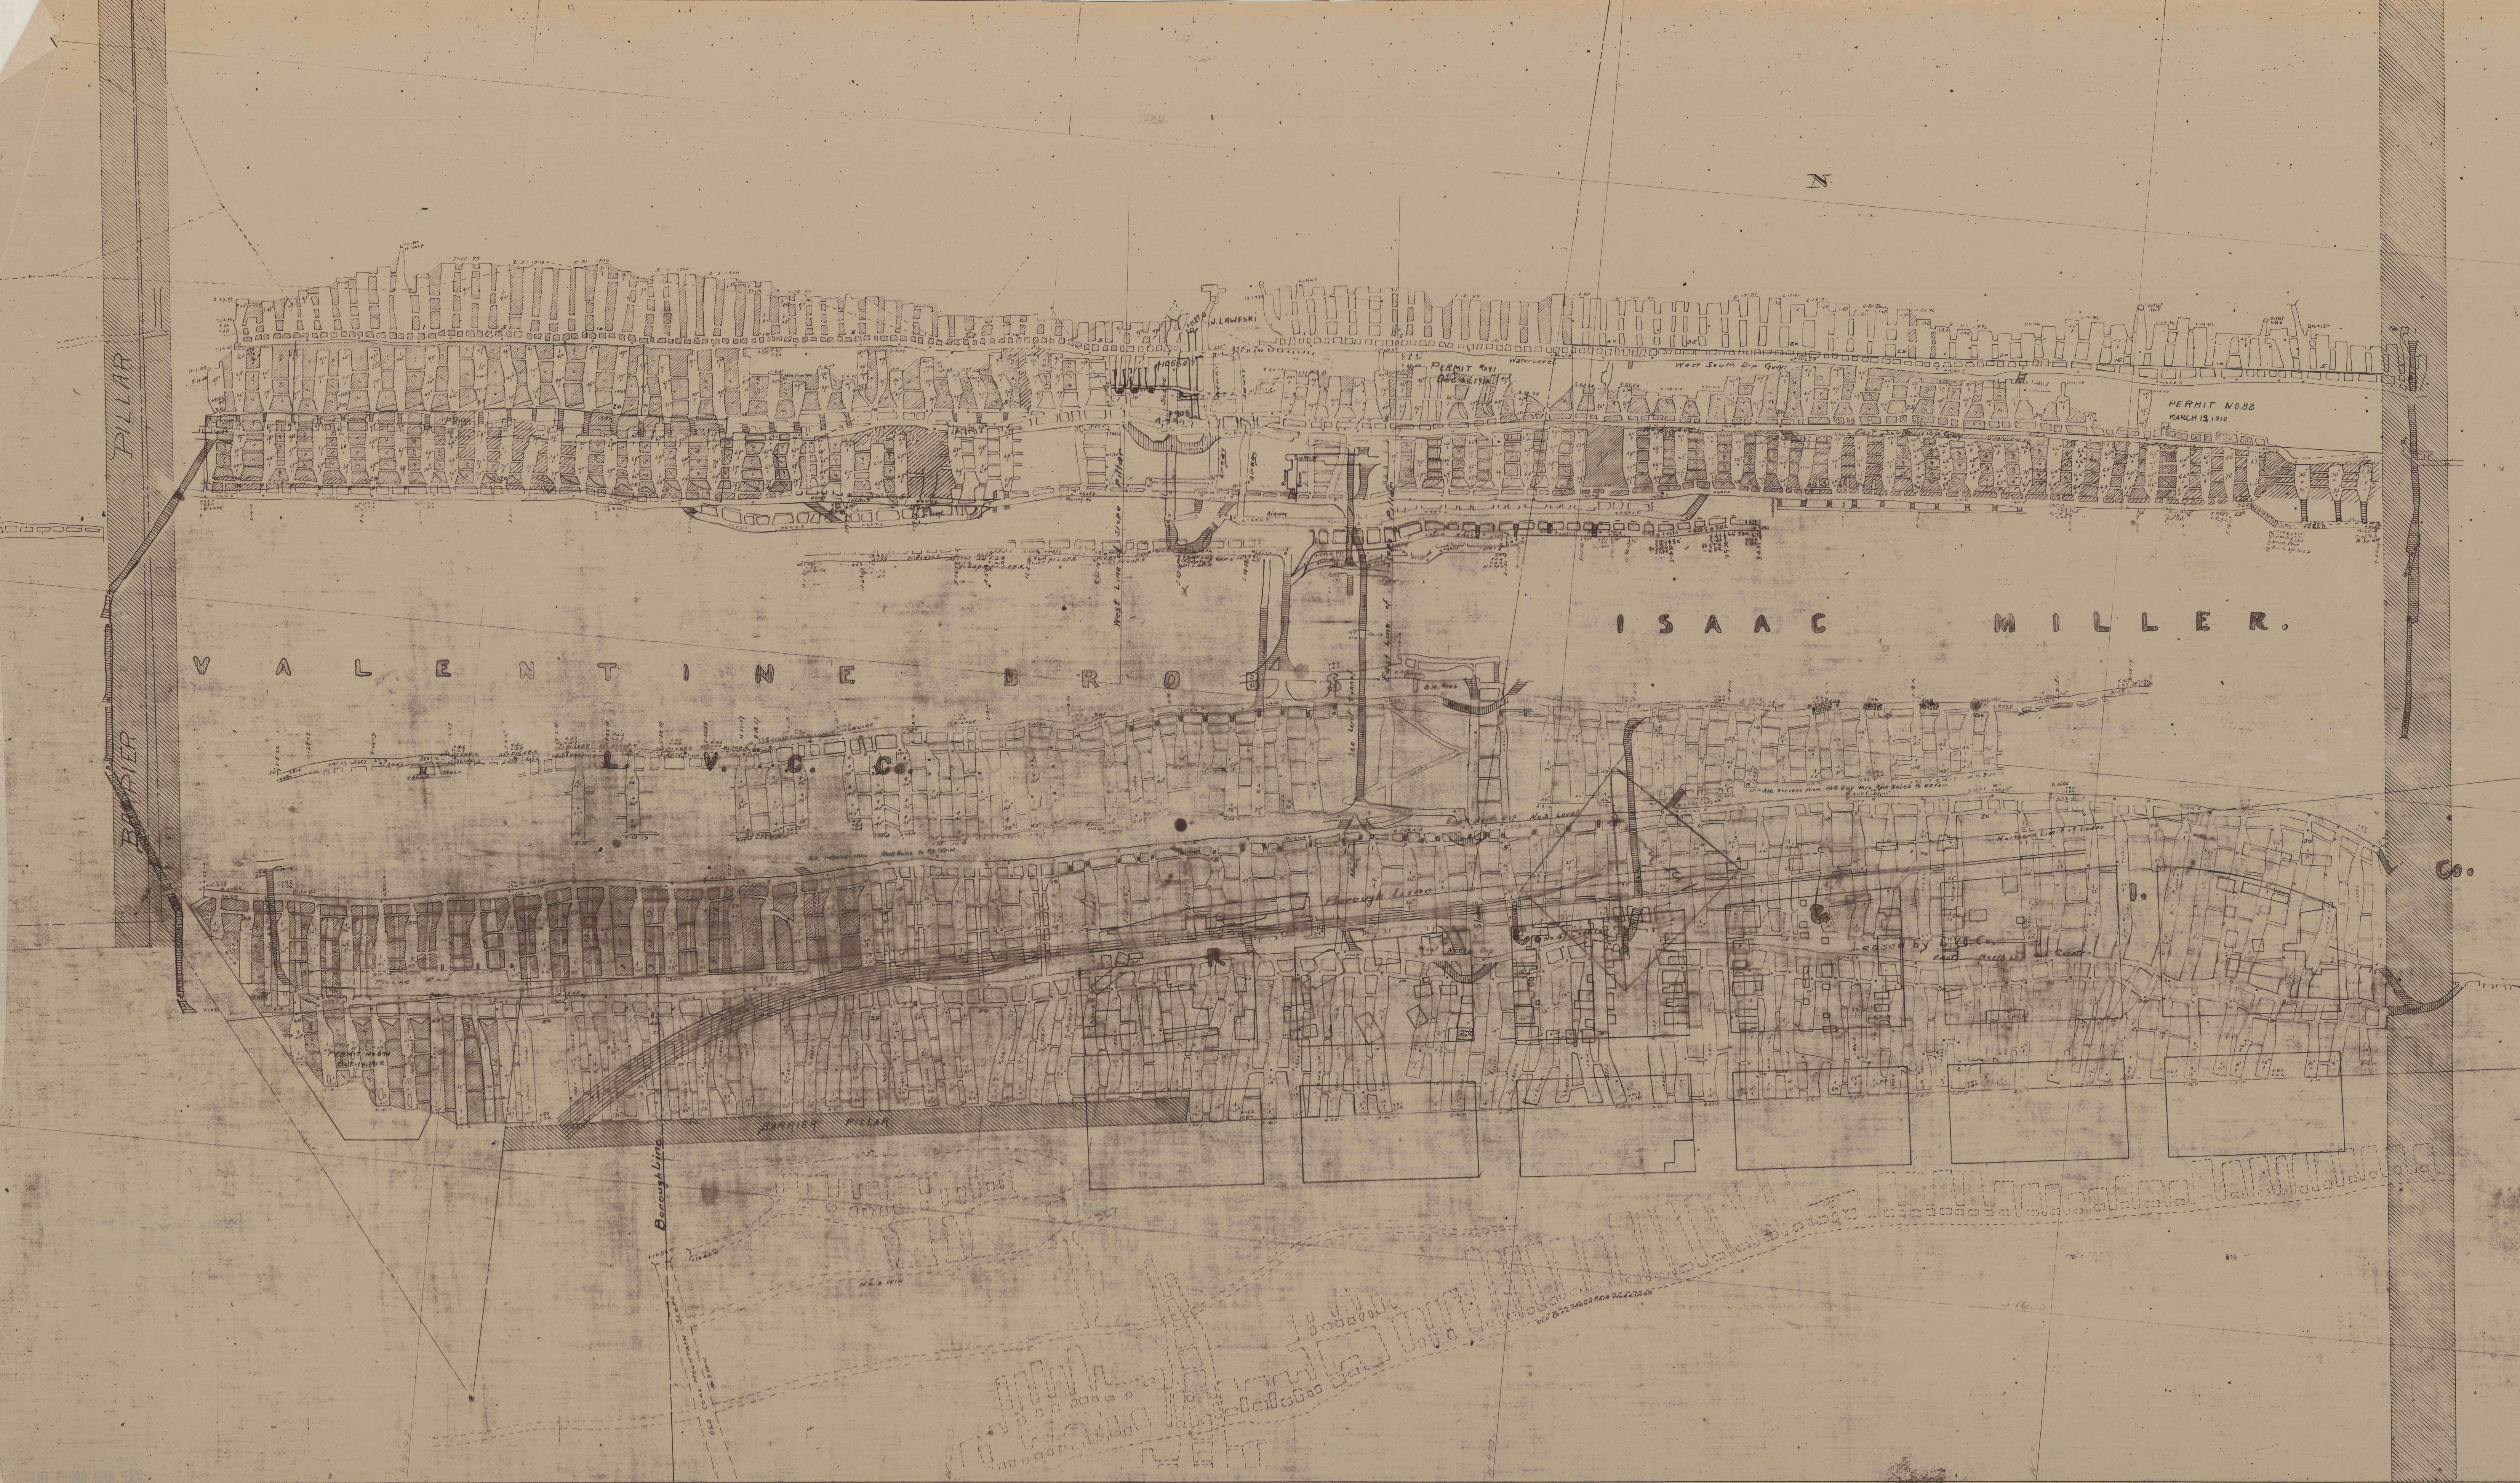

NO. 8 VEIN
— at —
SIOUX NO. 1 & 3 COLLIERIES
— OF THE —

Lehigh Valley Coal Company

ENGINEERING DEPARTMENT
L.V.C. Co.
MAHANBY AND SHAMOKIN DIVISION
100 ft = 1 in.
Dec 1910