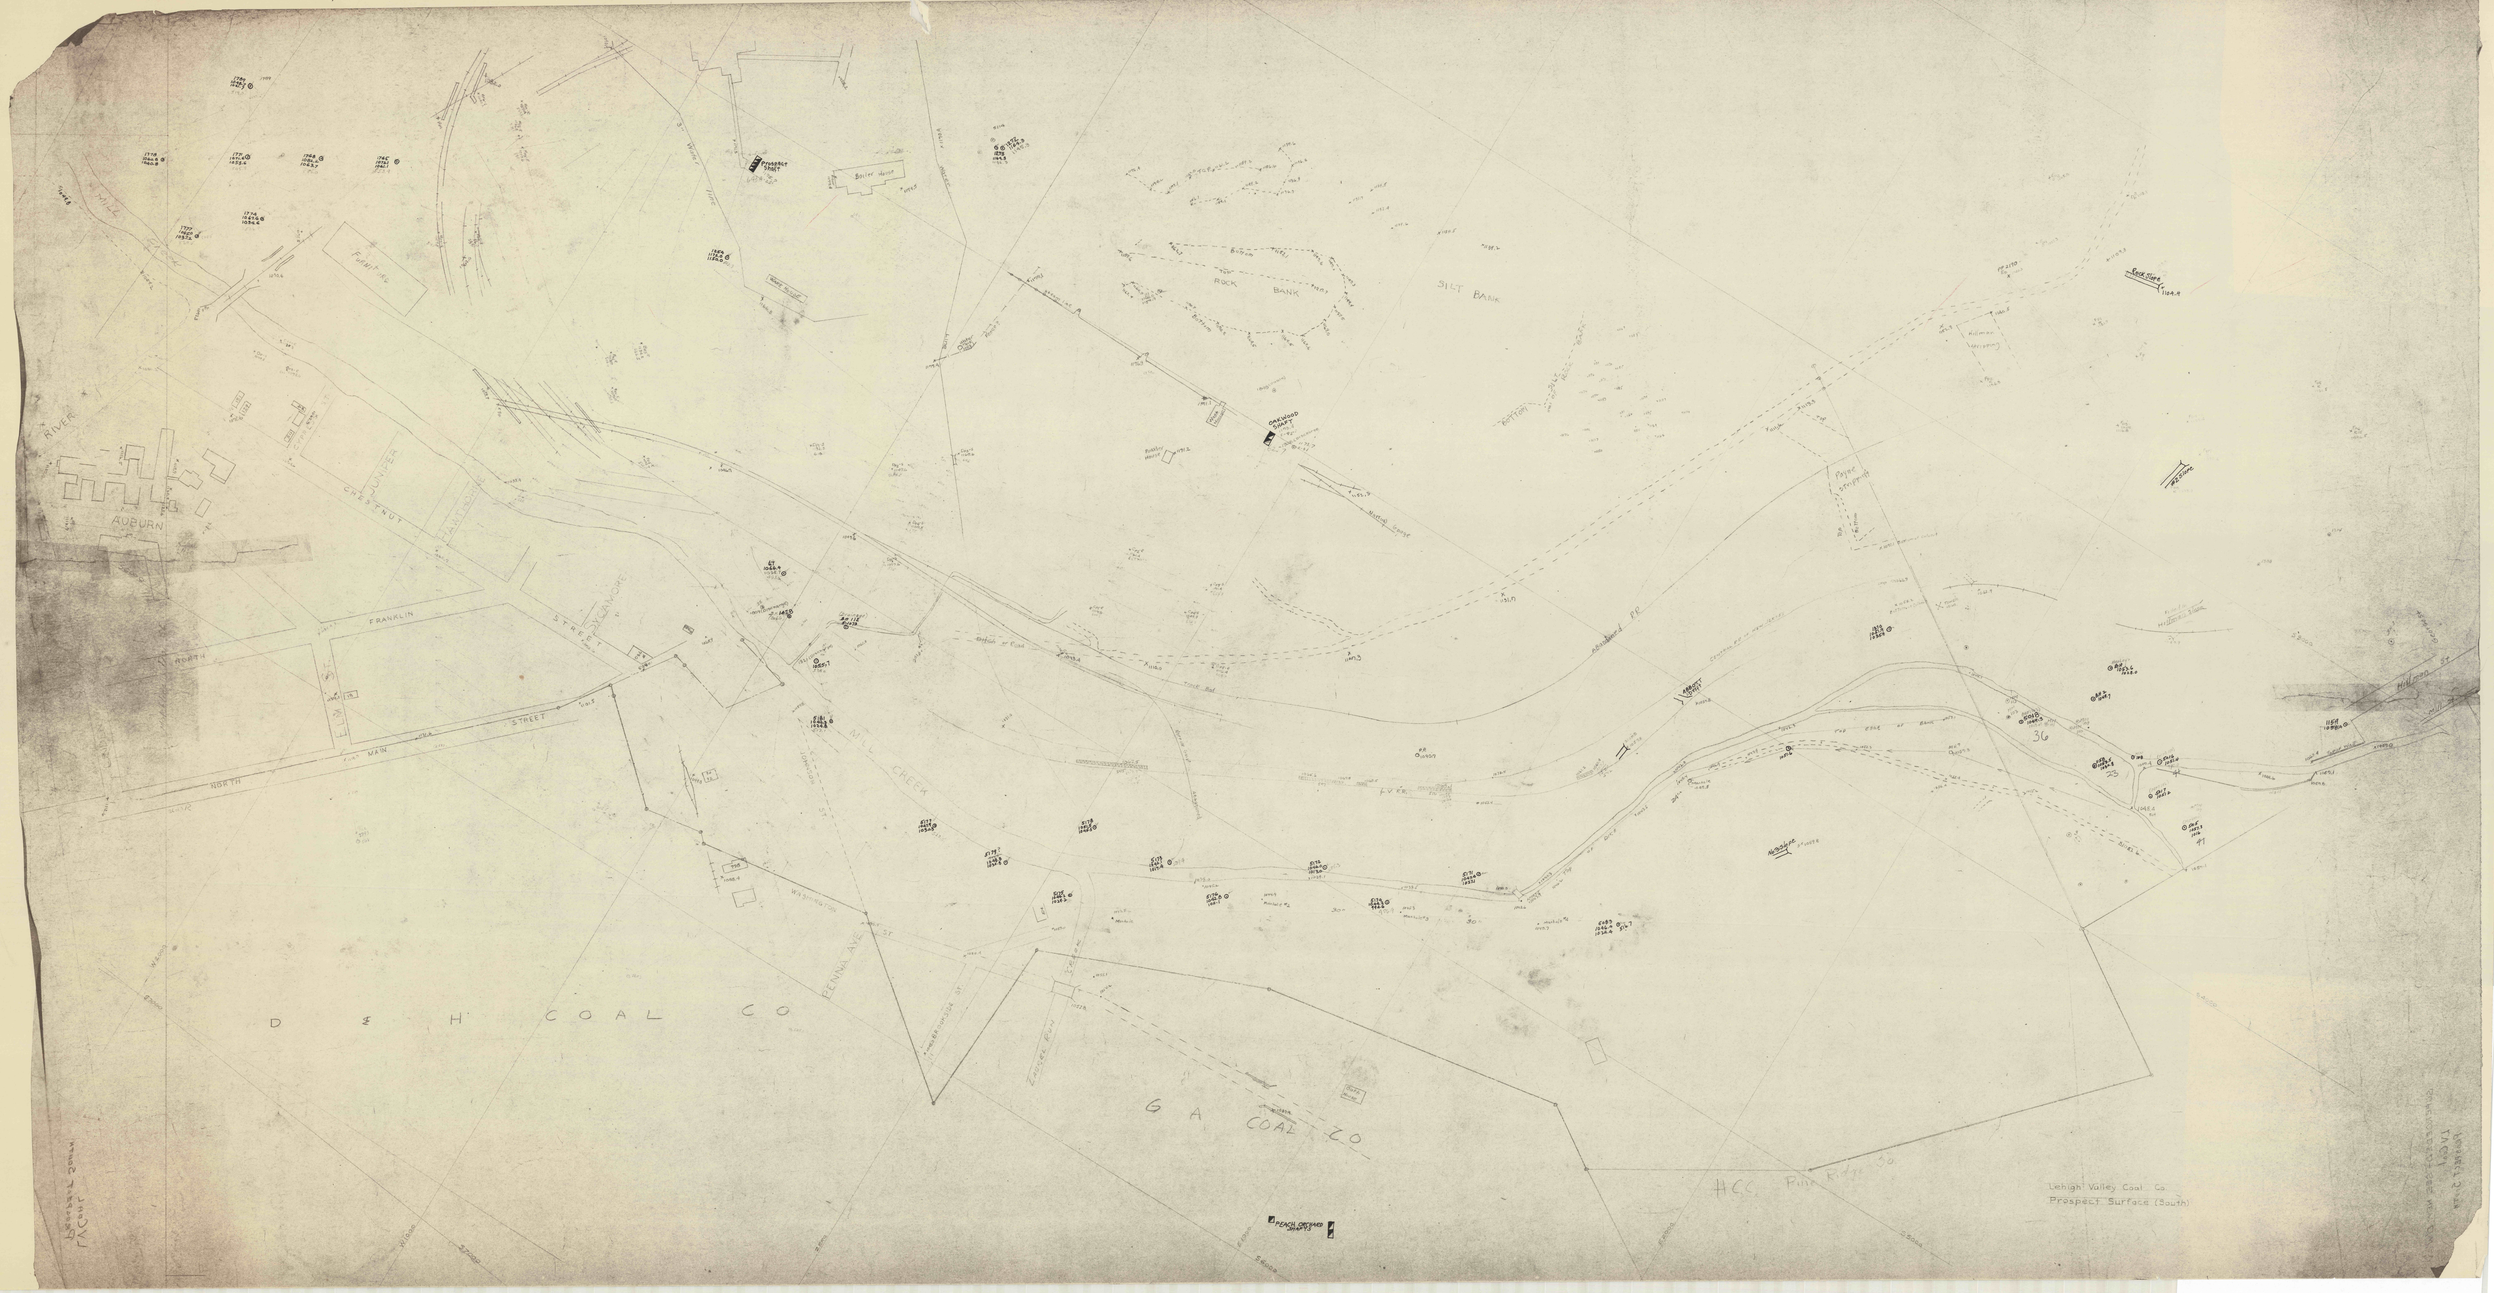
RIVER
AUBURN
CHESTNUT
JUNIPER
FRANKLIN
NORTH
MAIN
STREET
SYCAMORE
MILL CREEK
PENNSYLVANIA AVE
WASHINGTON ST
ROCK BANK
SILT BANK
BOTTOM
D & H COAL CO
G A COAL CO
HCC
Lehigh Valley Coal Co.
Prospect Surface (South)