


SHEET NO. V-113
LINE NO. V-508
KVA. AND CHINA FIE

CENTER SHEET
BOTTOM RED ASH
MURKIN A. COLLY
KEMER-BERGE Coal Co.

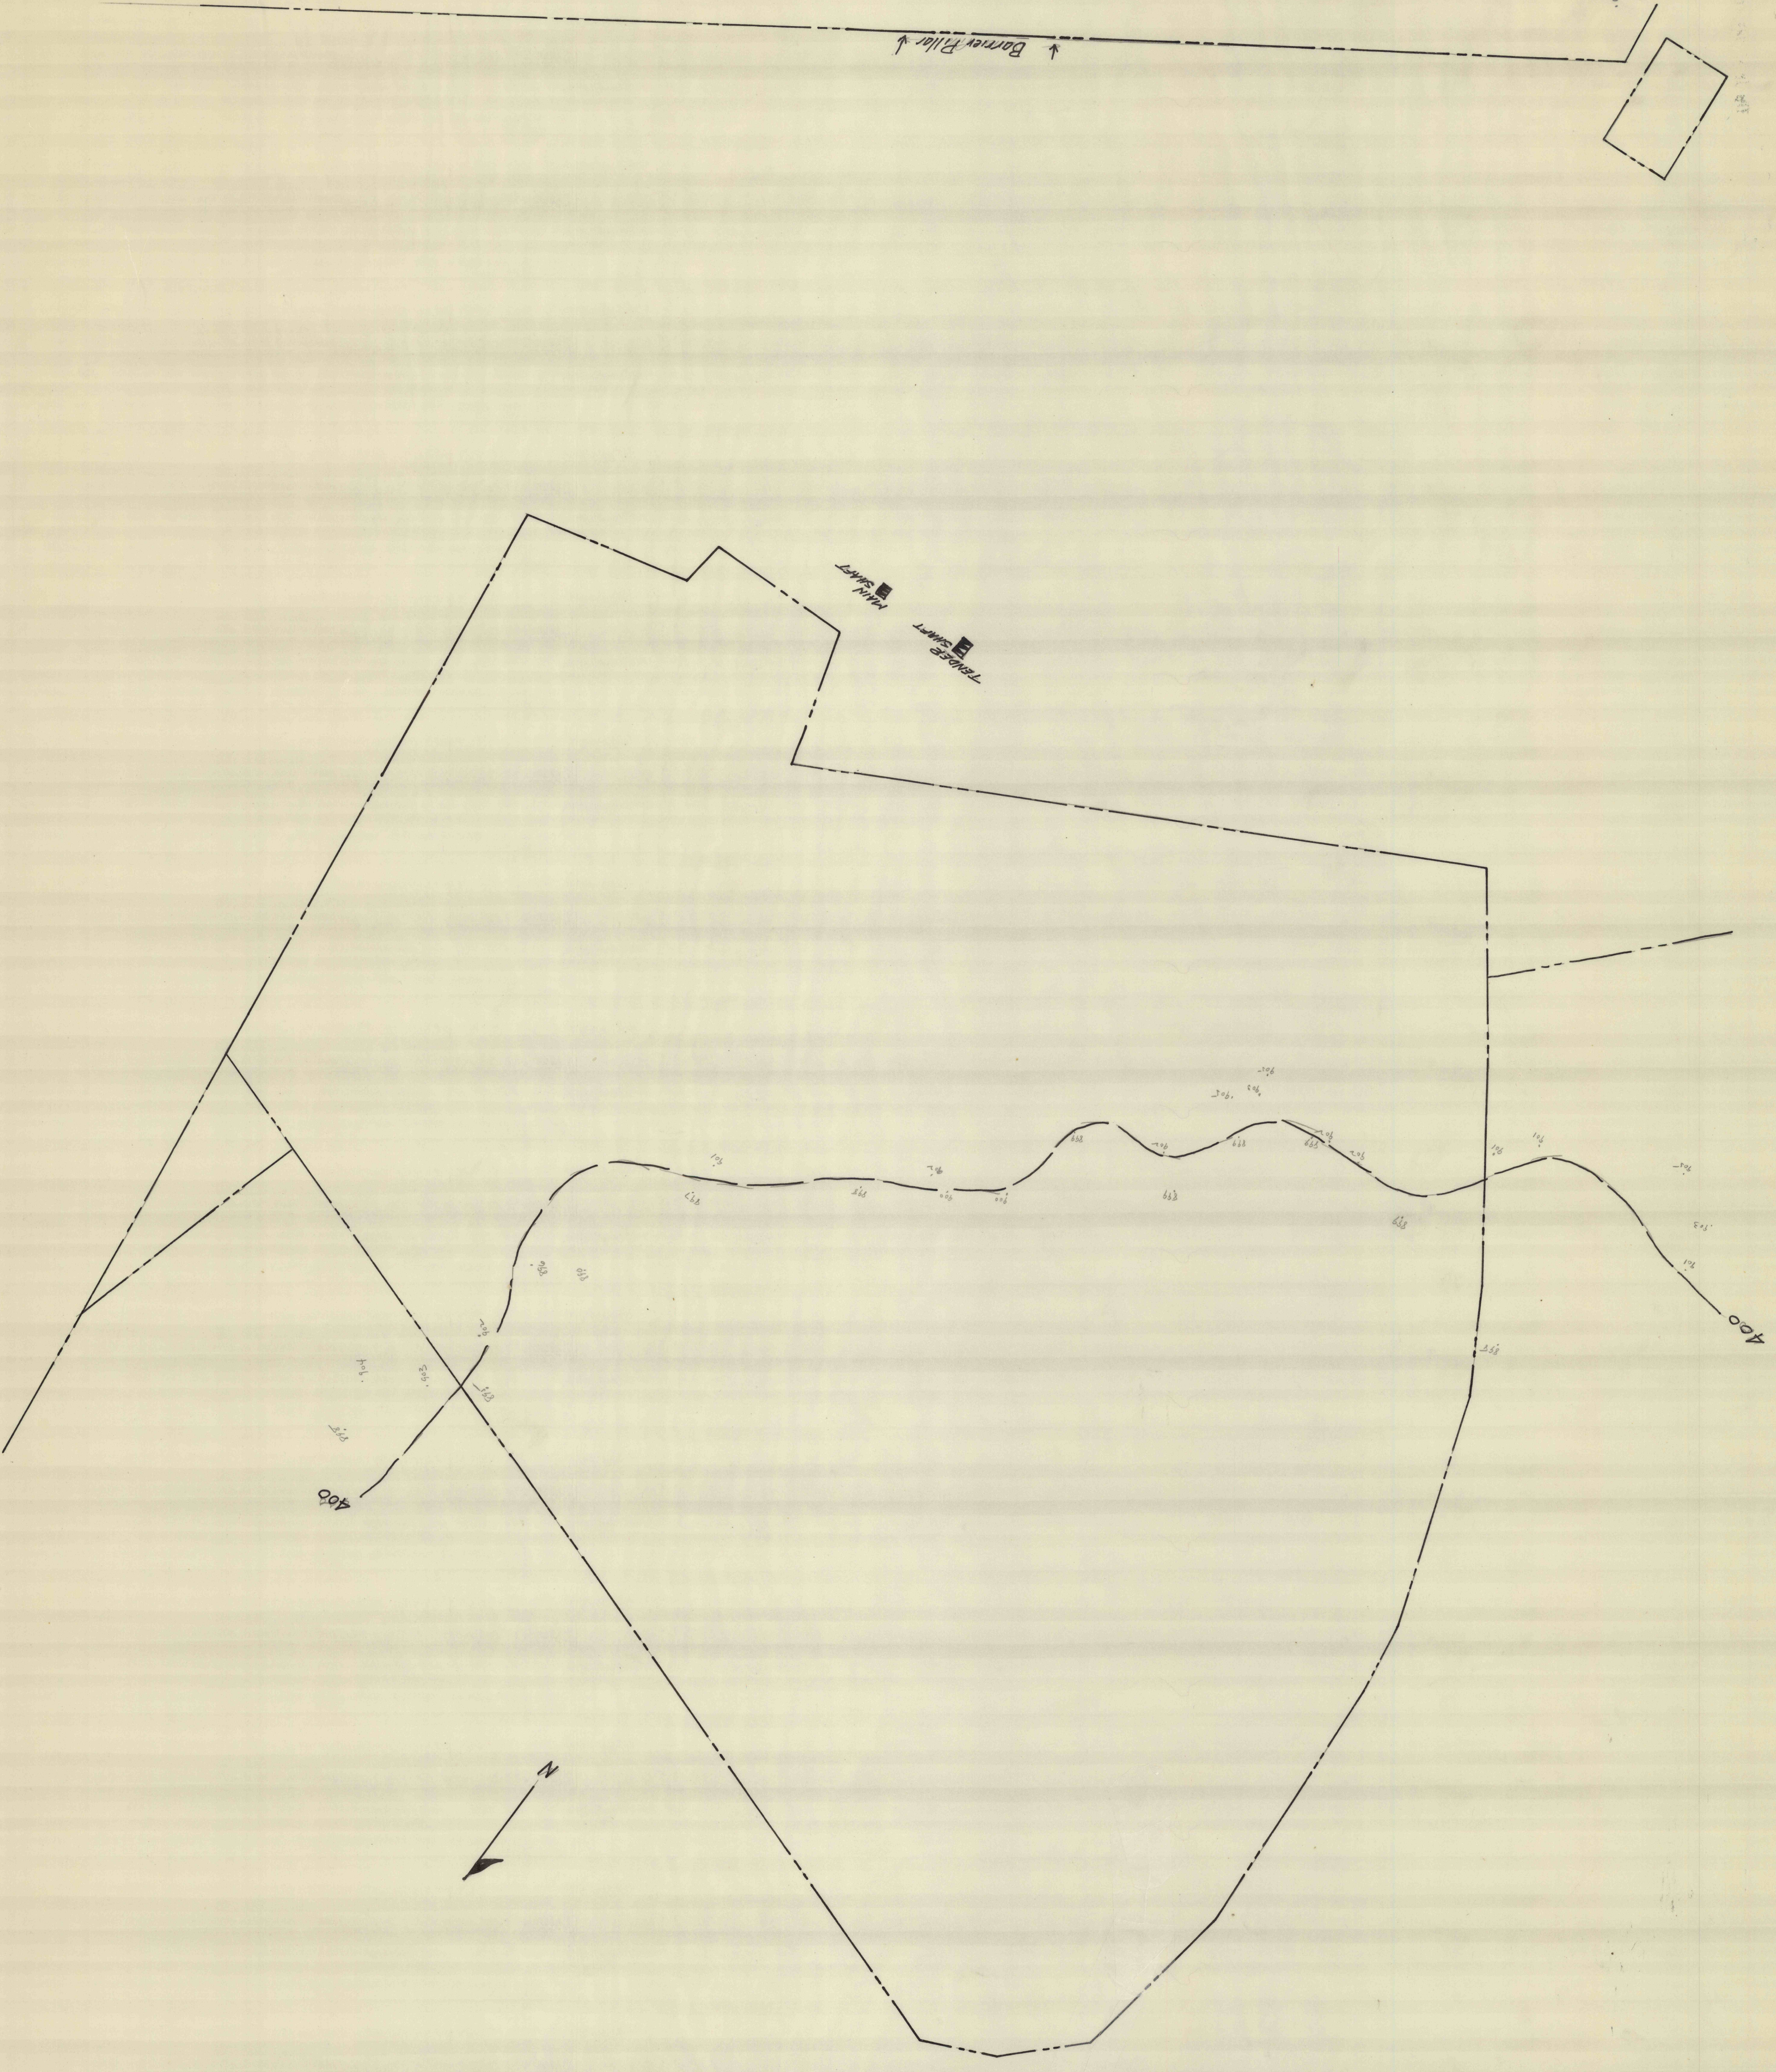

SHEET NO. V-113
LINE NO. V-508
KVA. AND CHINA FIE

KEMER-BERGE Coal Co.
W. A. COLLYERY
BOTTOM RED ASH
CENTER SHEET
Bottom Red Ash