

30000


+7.7
-5.2

3

DILLIEY

JAMES

JACOBS

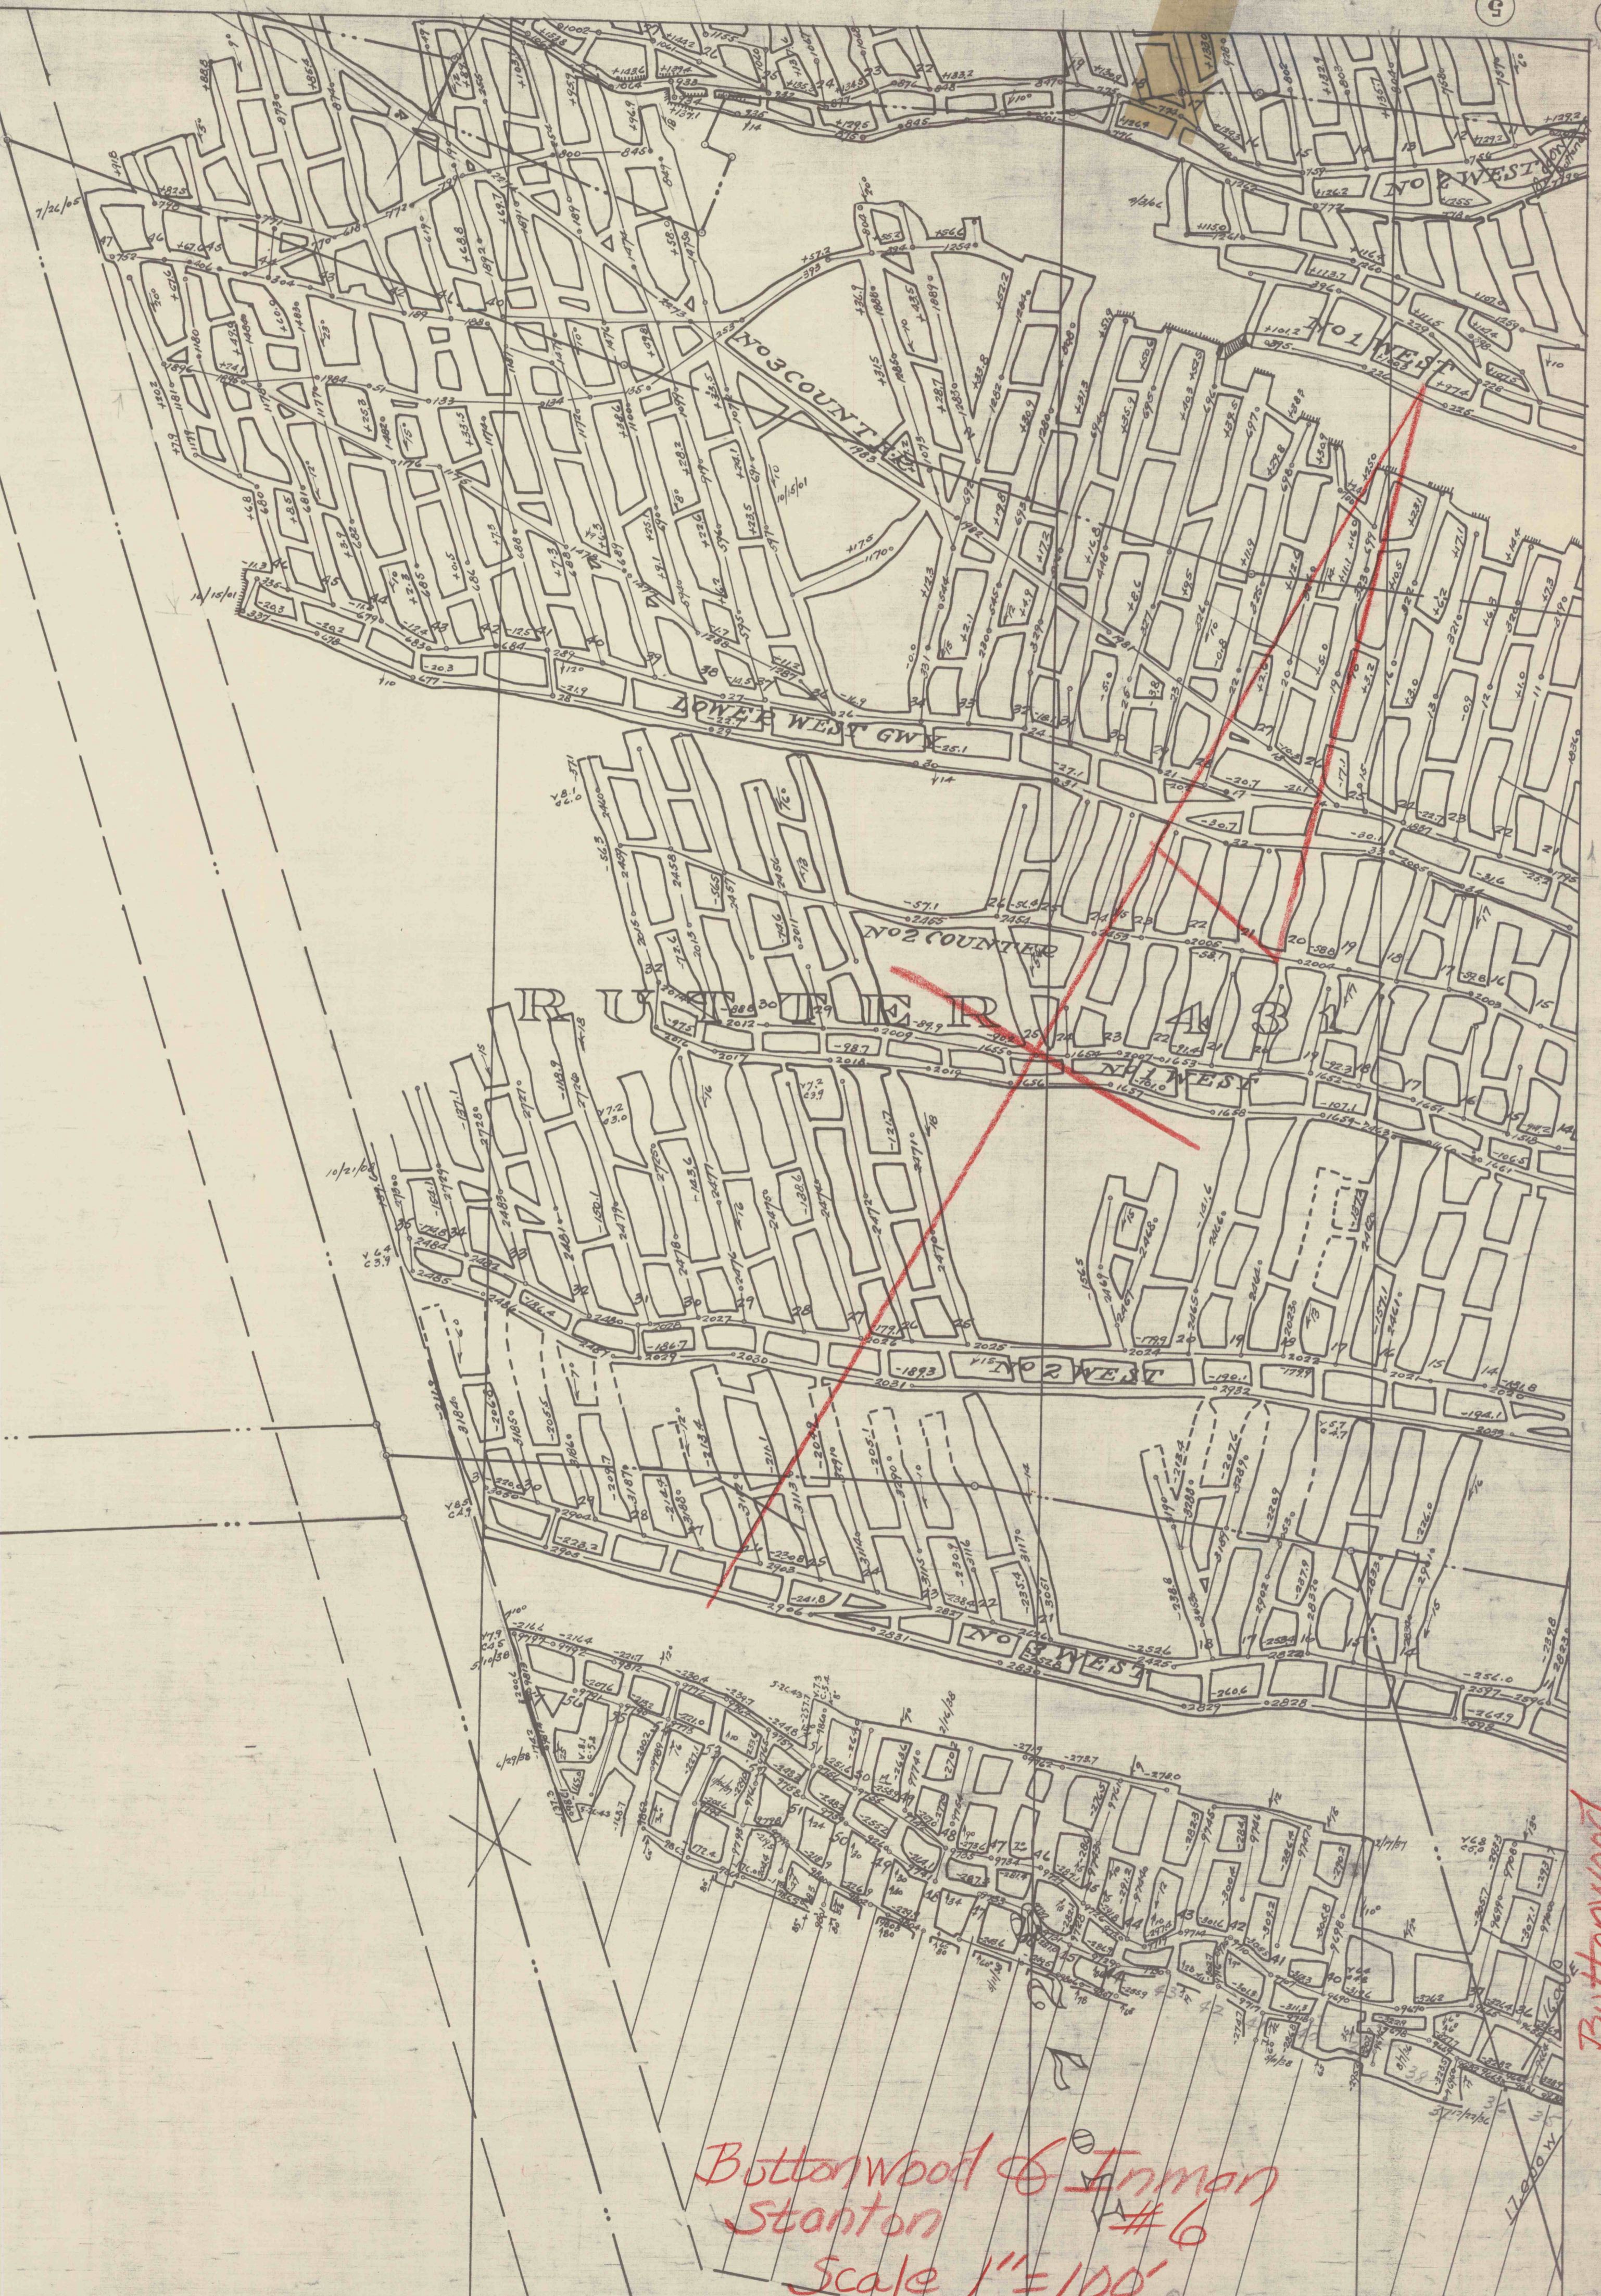

5
1
2

COLLIERY

Buttonwood
LOOMIS
Stanton

Buttonwood & Inman
Stanton #6
Scale 1"=100'