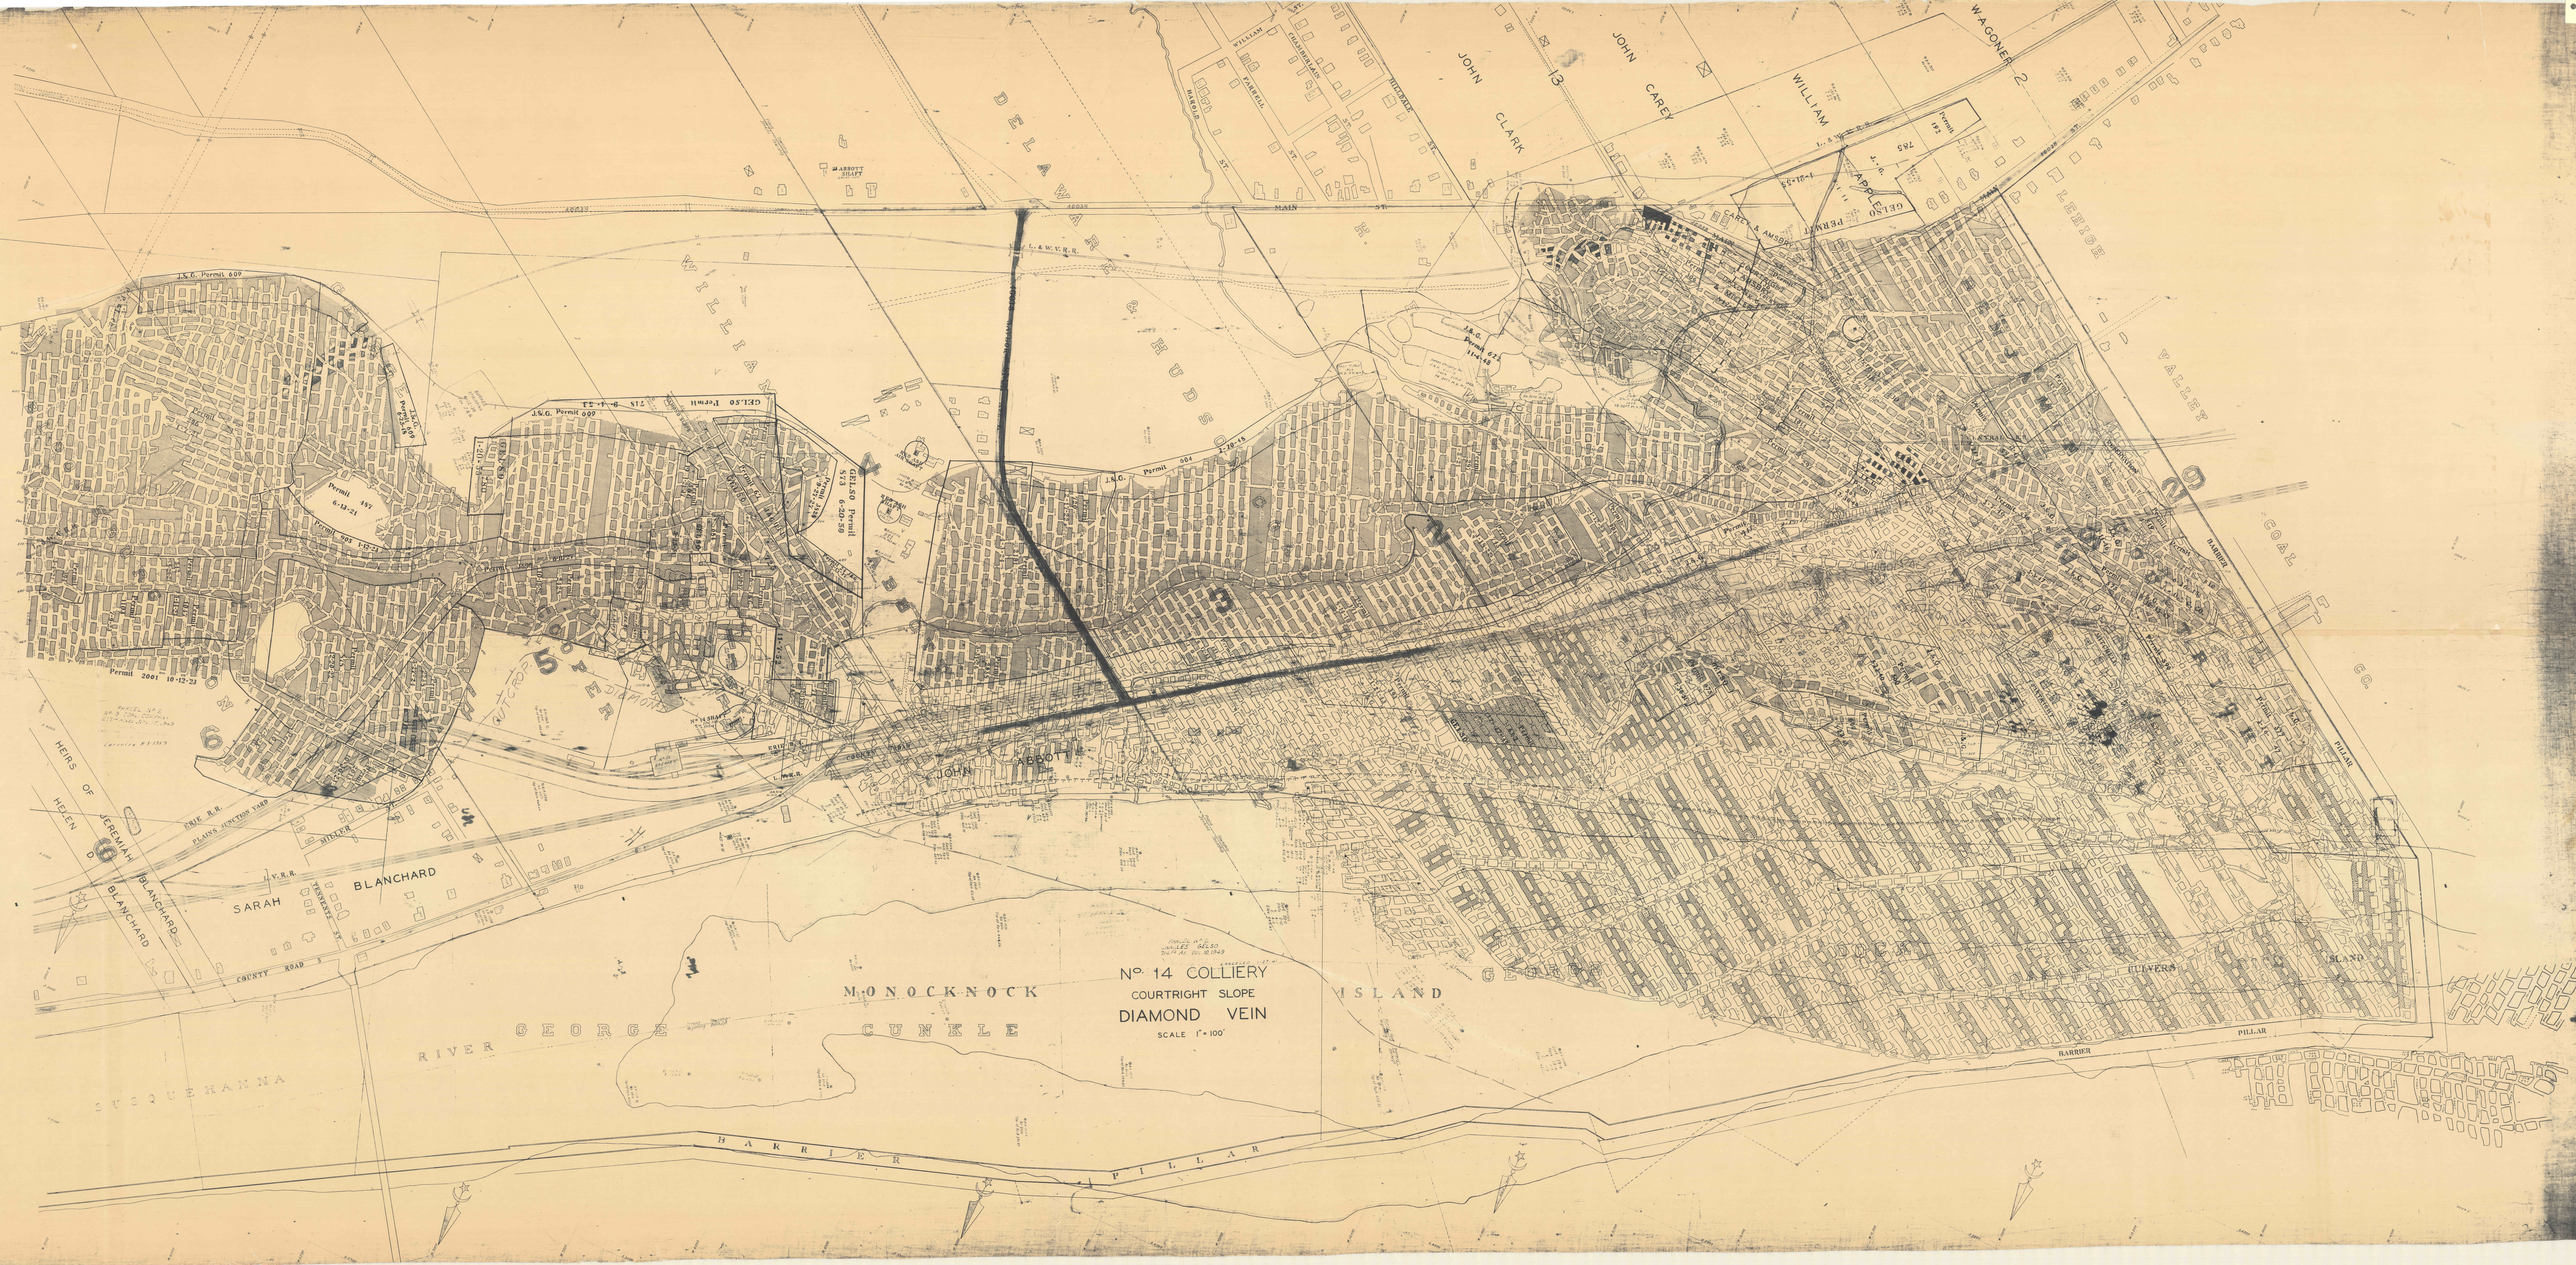
No. 14 COLLIERY
COURTRIGHT SLOPE
DIAMOND VEIN
SCALE 1" = 100'
JOHN ABBOTT
SARAH BLANCHARD
HEIRS OF JEREMIAH BLANCHARD
HELEN D. BLANCHARD
MONOCKNOCK ISLAND
RIVER SUSQUEHANNA
BARRIER
PILLAR
COUNTY ROAD
MAIN
ERIE R.R.
PLAINS JUNCTION YARD
L. & W.V.R.R.
DELAWARE & HUDSON R.R.
WILLIAM ABBOTT
JOHN CLARK
JOHN CAREY
WILLIAM
W.A. GONER
GELSO PERMIT
J.&G. Permit 609
Permit 197
Permit 2001
Permit 664
Permit 624
Permit 783
Permit 792
Permit 1
Permit 2
