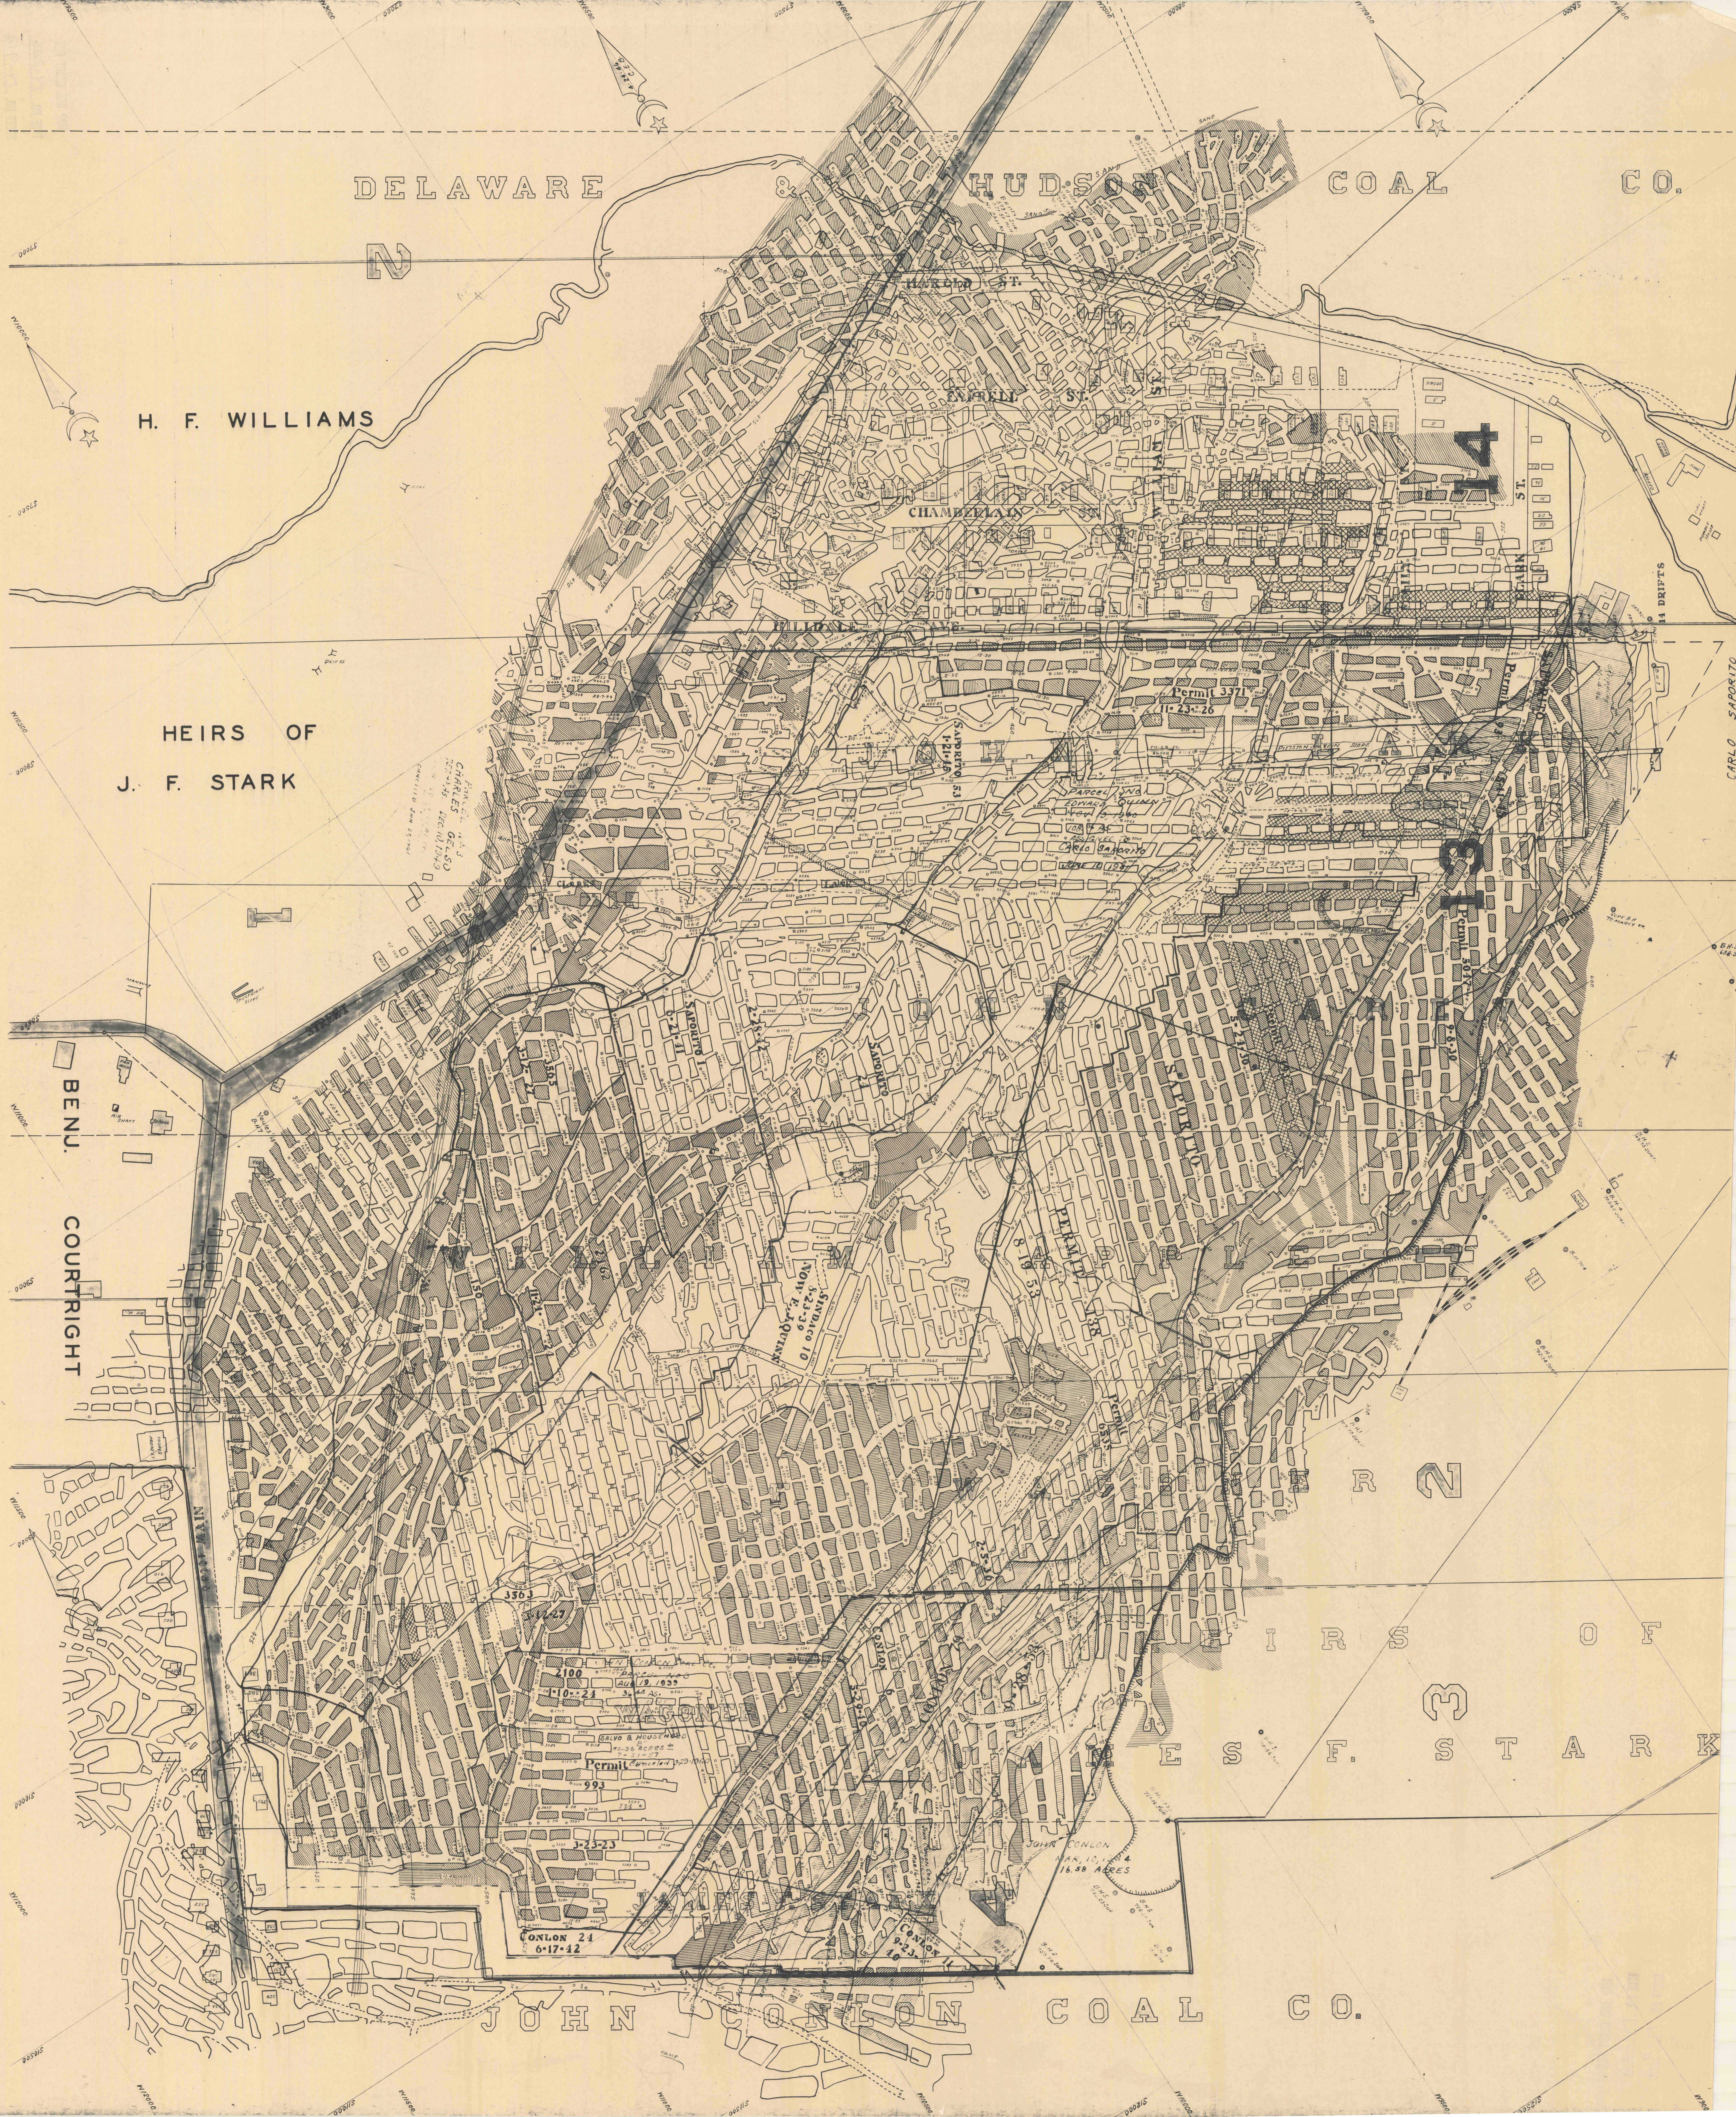
DELAWARE & HUDSON COAL CO.
2
H. F. WILLIAMS
HEIRS OF J. F. STARK
BENJ. COURTRIGHT
HAROLD ST.
FARRELL ST.
CHAMBERLAIN ST.
HILLSIDE AVE.
CLARK ST.
14
14 DRIFTS
CARLO SAPORITO
Permit 3371 11-23-26
PARCEL NO EDWARD QUINN NOV 3 1940
ASSIGNED TO CARLO SAPORITO JUNE 10 1941
PITTSTON VEIN SLOPE
SAPORITO 53 1-21-48
SAPORITO 5-21-41
13
Permit 5047 9-8-30
Permit 193 5-21-30
SAPORITO
PERMIT 338 8-19-53
SAPORITO 10 NOV 23-39 NOW E. QUINN
CAREY
WILLIAM
2
3
HEIRS OF JAMES F. STARK
3563 3-12-27
2100 1-10-24
JOHN CONLON COAL CO. PARCEL NO 3 AUG 19, 1939 36.44 AS.
WAGONER
SALVO & HOUSEHOLD "B" 55.36 ACRES ± 7-31-57
Permit Canceled 3-29-1960 993
3-23-23
CONLON 24 6-17-42
CONLON 6 5-29-40
CONLON 11 9-23-40
JOHN CONLON MAR. 10, 1944 16.58 ACRES
ROPE B.H. TO MARCY VN.
JOHN CONLON COAL CO.
SOUTH MAIN