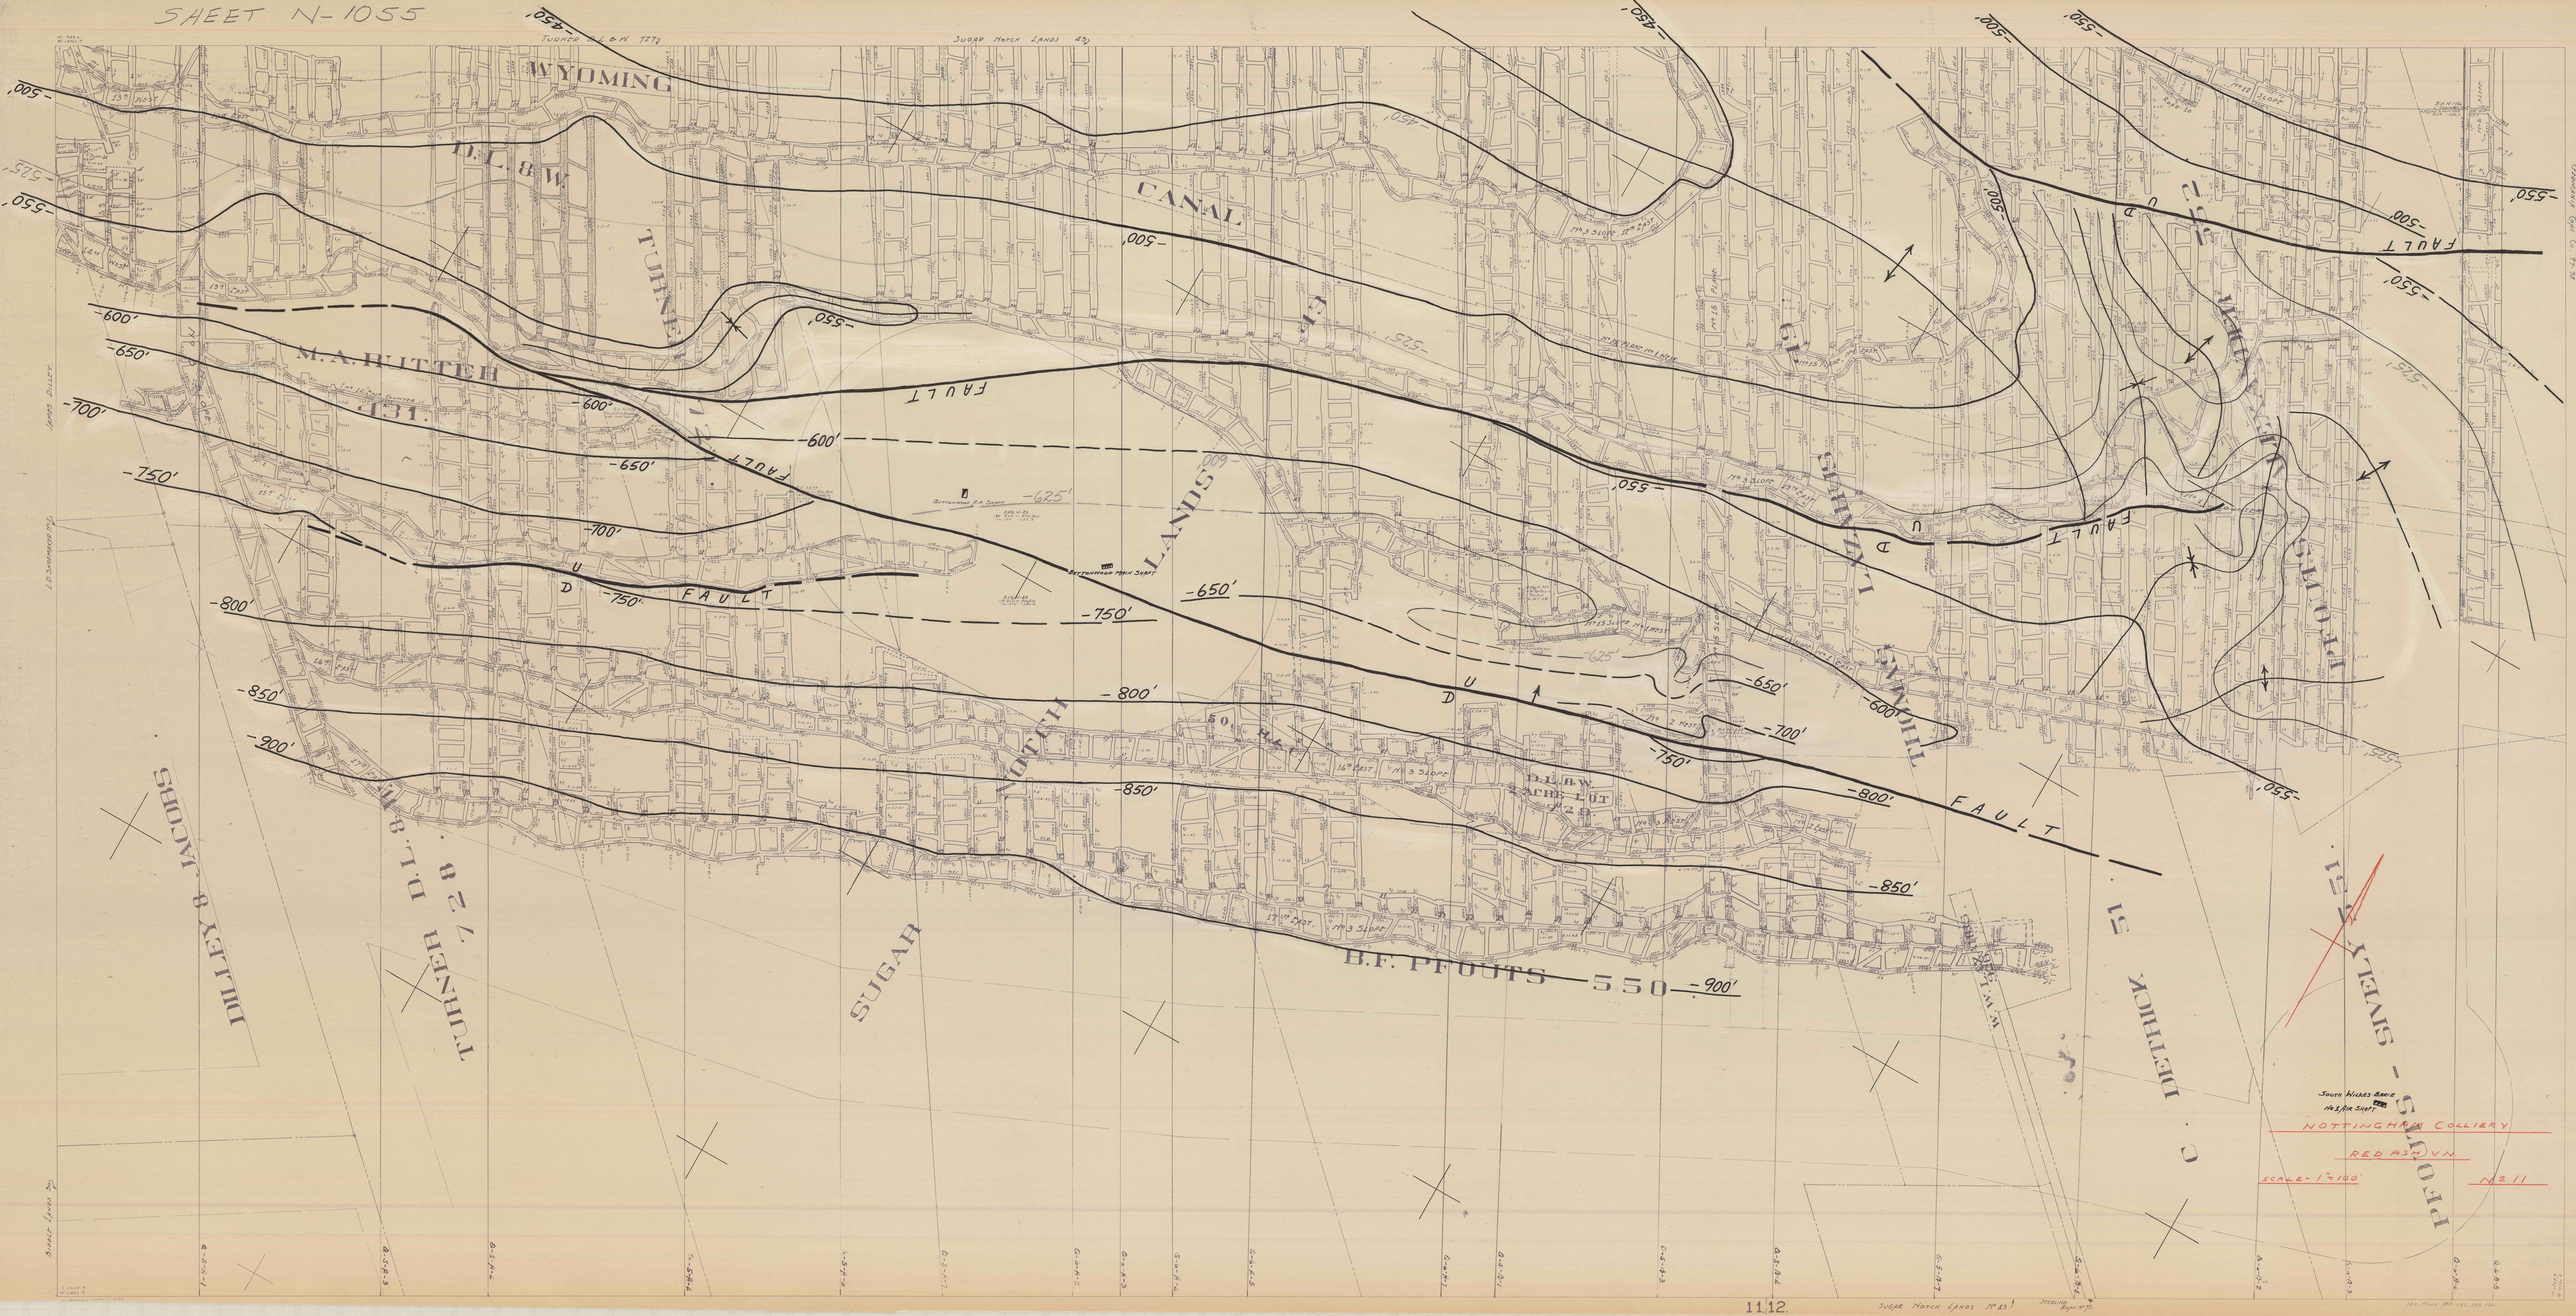

SHEET N-1055

TURNER D.L.&W. 727
SUGAR NOTCH LANDS 437
WYOMING
D.L.&W.
CANAL
TURNER
M.A. RUTTER
431.
LANDS
SUGAR
NOTCH
50 ACRE LOT
D.L.&W. 2 ACRE LOT 729
B.F. PFOUTS 550
DILLEY & JACOBS
TURNER D.L.&W. 728
DETRICK 51
PFOUTS - SHAFER 51
C.
W.W.L. 756
GP
FAULT
U
D
-450'
-500'
-525'
-550'
-600'
-625'
-650'
-700'
-750'
-800'
-850'
-900'
13th WEST
14th WEST
12th EAST
13th EAST
15th EAST
16th EAST
17th EAST
No 3 SLOPE
No 3 SLOPE, 12th EAST
No 3 SLOPE 13th EAST
No 15 PLANE
No 15 PLANE No 1 WEST
No 15 PLANE No 1 EAST
No 15 SLOPE No 1 WEST
No 15 SLOPE No 1 EAST
No 12 SLOPE
No 6 SLOPE
No 1 COUNTER
No 2 WEST
No 2 EAST
No 3 WEST
BUTTONWOOD AIR SHAFT
BUTTONWOOD MAIN SHAFT
ROAD 10
SUMP
JAMES DILLEY
L.D. SHOEMAKER No 2
BIDDLE LANDS 30
GERMANIA COAL CO. 97-98
SOUTH WILKES-BARRE No 1 AIR SHAFT
SUGAR NOTCH LANDS No 43
STERLING ROAD No 75
SEE MAPS Nos 126, 135, 136
Q-5-A-1
Q-5-A-3
Q-5-A-4
Q-5-A-6
Q-5-A-7
Q-6-A-2
Q-6-A-3
Q-6-A-4
Q-6-A-5
Q-6-A-7
Q-5-B-1
Q-5-B-3
Q-5-B-4
Q-5-B-7
Q-6-B-4
Q-6-B-2
Q-6-B-3
Q-6-B-4
Q-6-B-5

NOTTINGHAM COLLIERY

RED ASH VN.

SCALE - 1" = 100'

No 11

11.12.