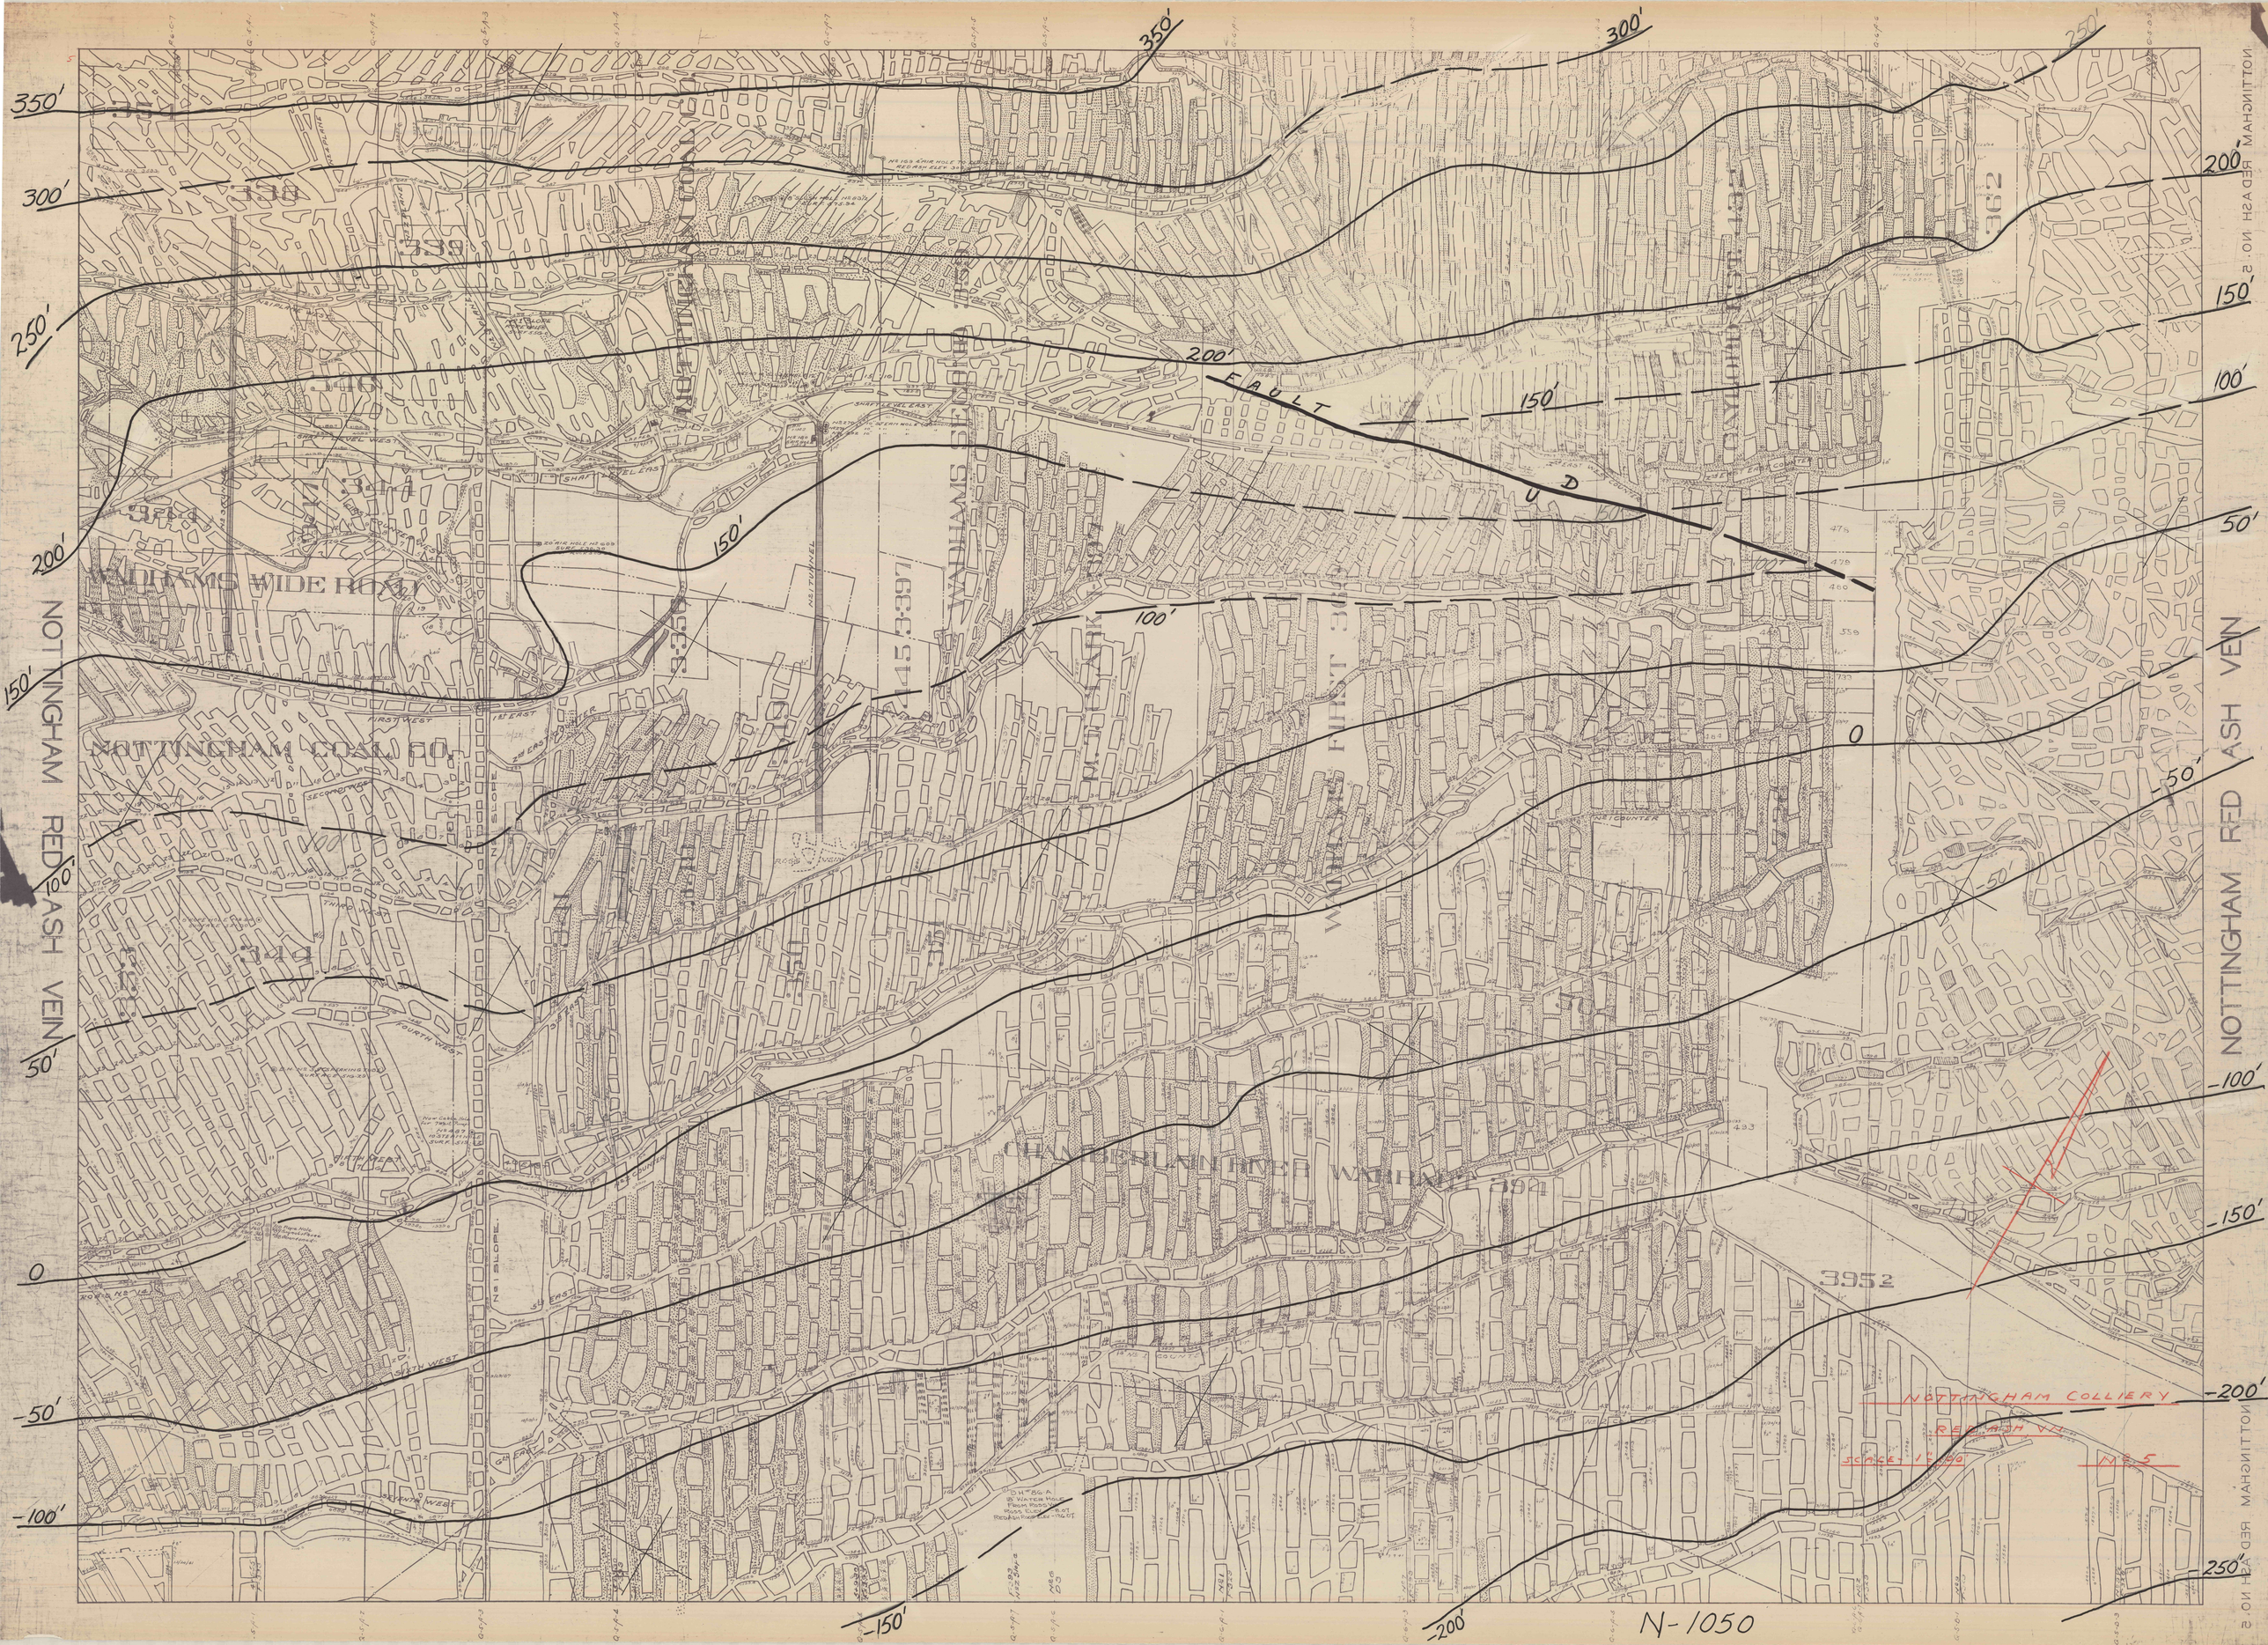

NOTTINGHAM RED ASH VEIN
NOTTINGHAM RED ASH VEIN
NOTTINGHAM COAL CO.
WADHAMS WIDE ROAD
WADHAMS SECOND
WADHAMS FIRST
CHAMBERLAIN RIVER WARRANT 394
FAULT
U
D
NOTTINGHAM COLLIERY
RED ASH VEIN
SCALE 1" = 50'
No. 5
N-1050
350'
300'
250'
200'
150'
100'
50'
0
-50'
-100'
-150'
-200'