


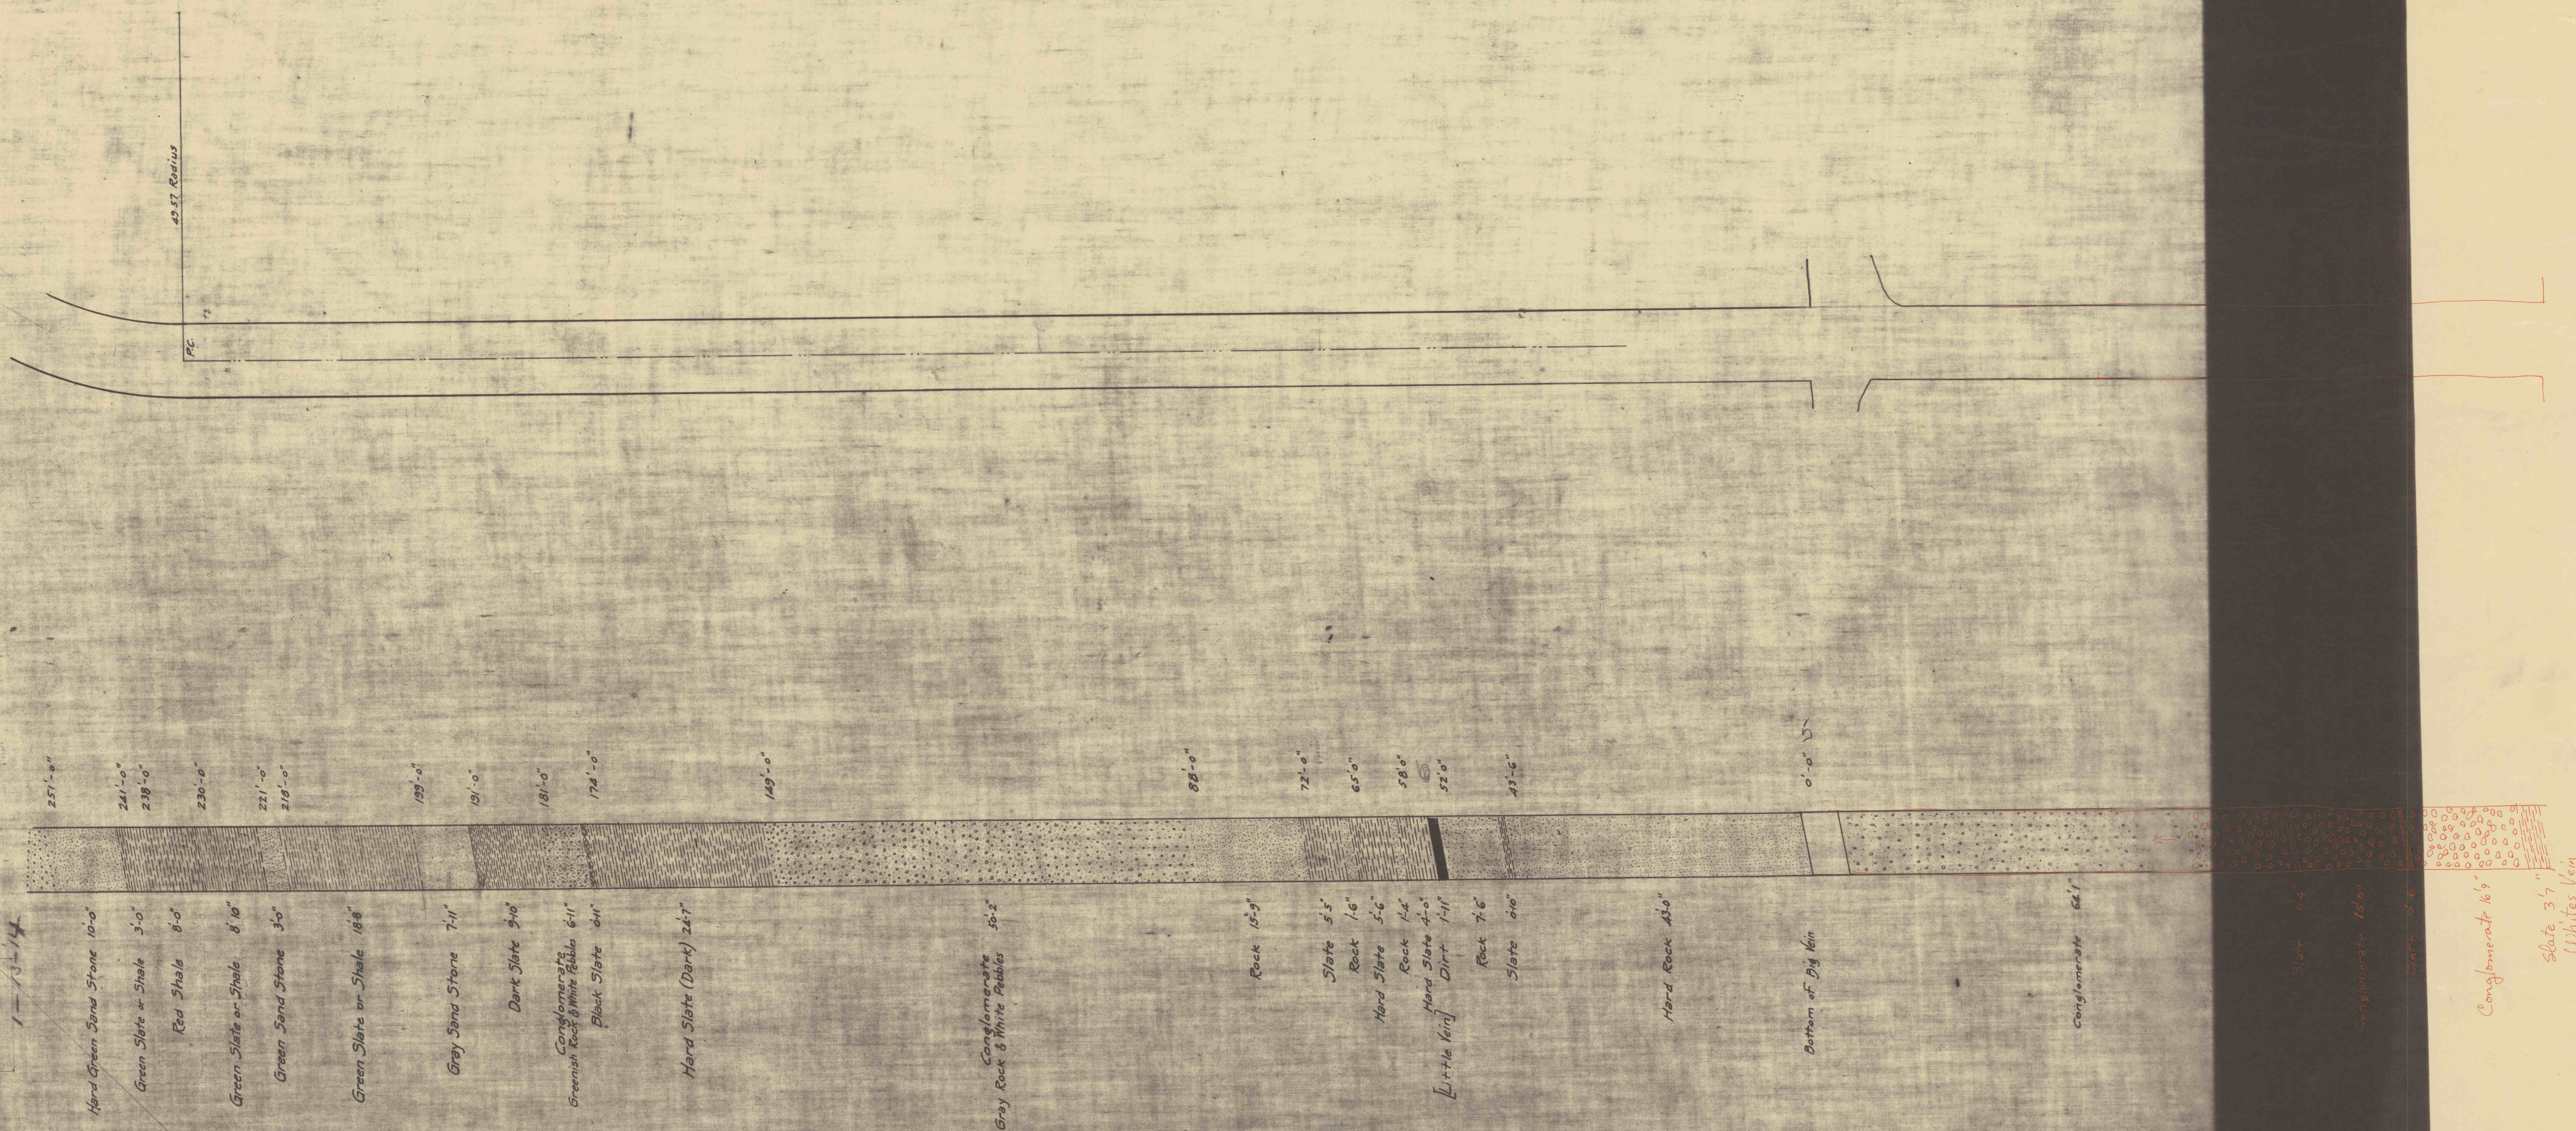

WEST SIDE OF TUNNEL
LOOKING WEST

PLAN AND SECTION OF TUNNEL
FROM WHITES VEIN TO RED SHALE
Nº 2 SHAFT BOTTOM LEVEL
WILLIAMSTOWN
Lykens Pa., Jan. 14, 1914
SCALE 1" = 10'