


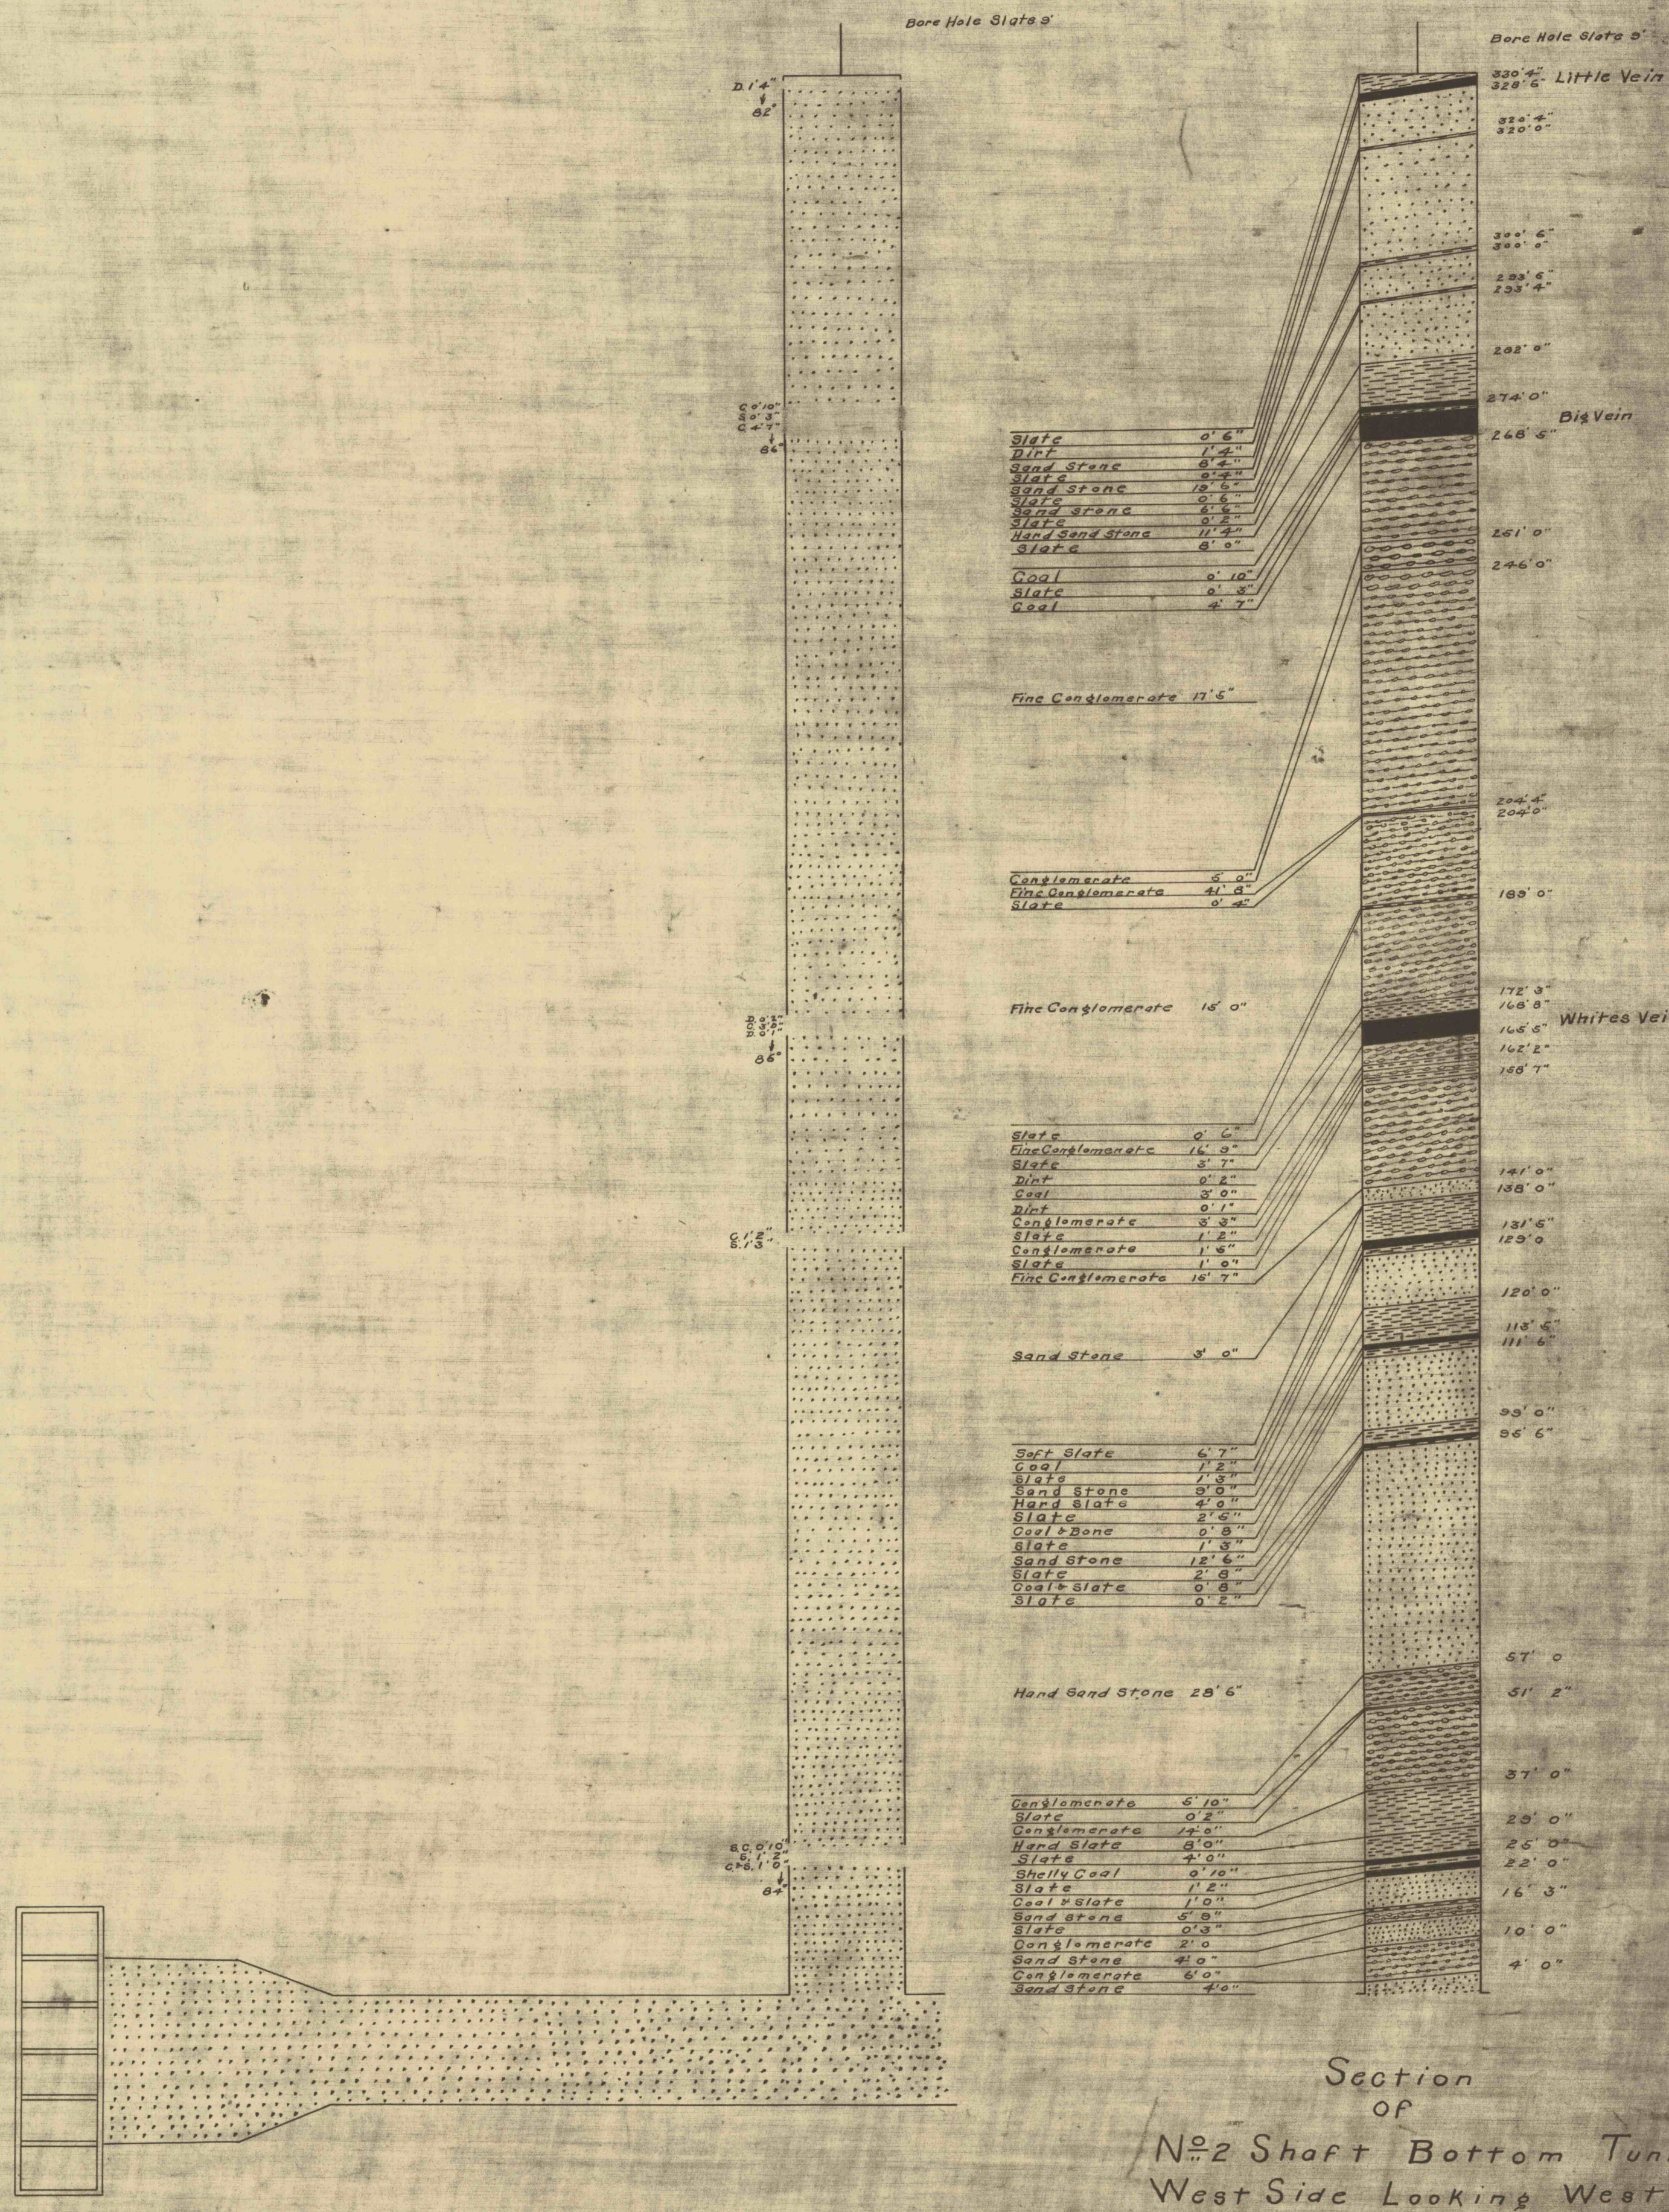

Scale Vertical 10' 1"