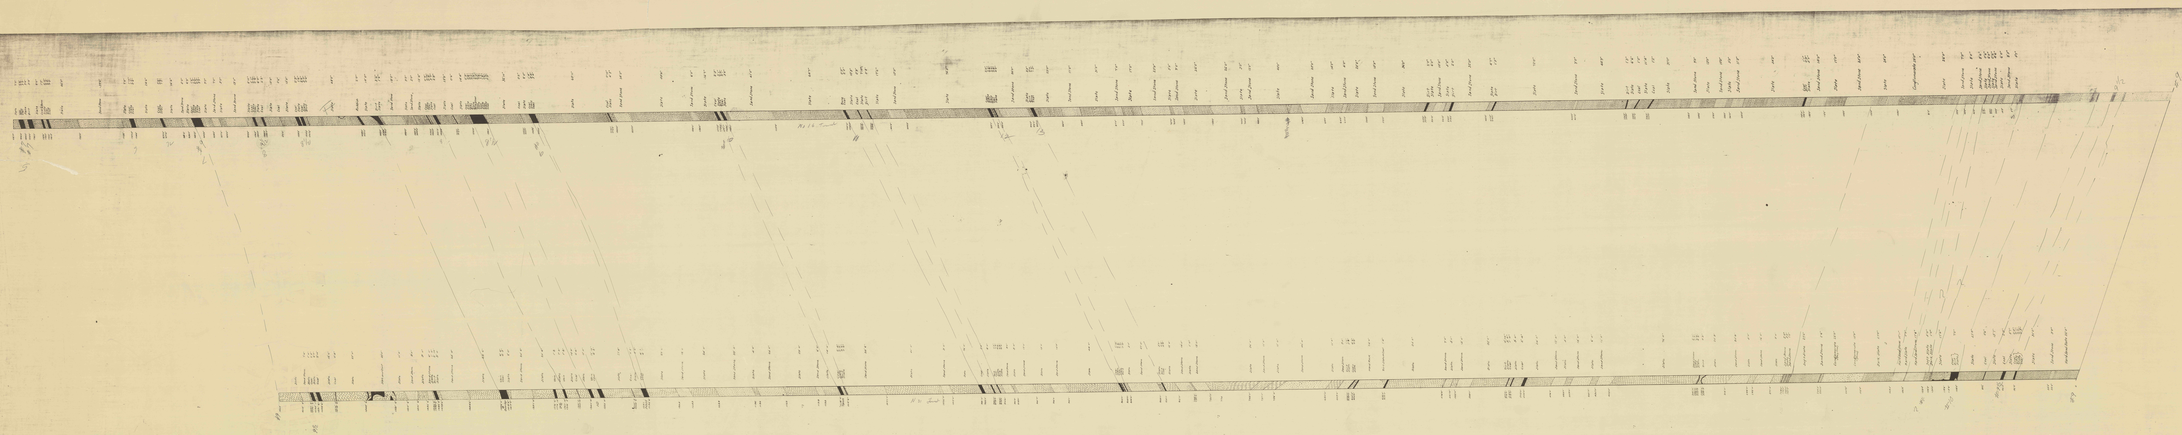

WILLIAMSTOWN COLLIERY.
SECTION OF NO 16 AND 21 TUNNELS
THROUGH DIFFERENT STRATA BEHIND
LONDON MARKET ON ROAD OVER