


C H A R L E S G A R R I N G E R

G. W. MORRIS

L. D. S H O E M A K E R
No. 1

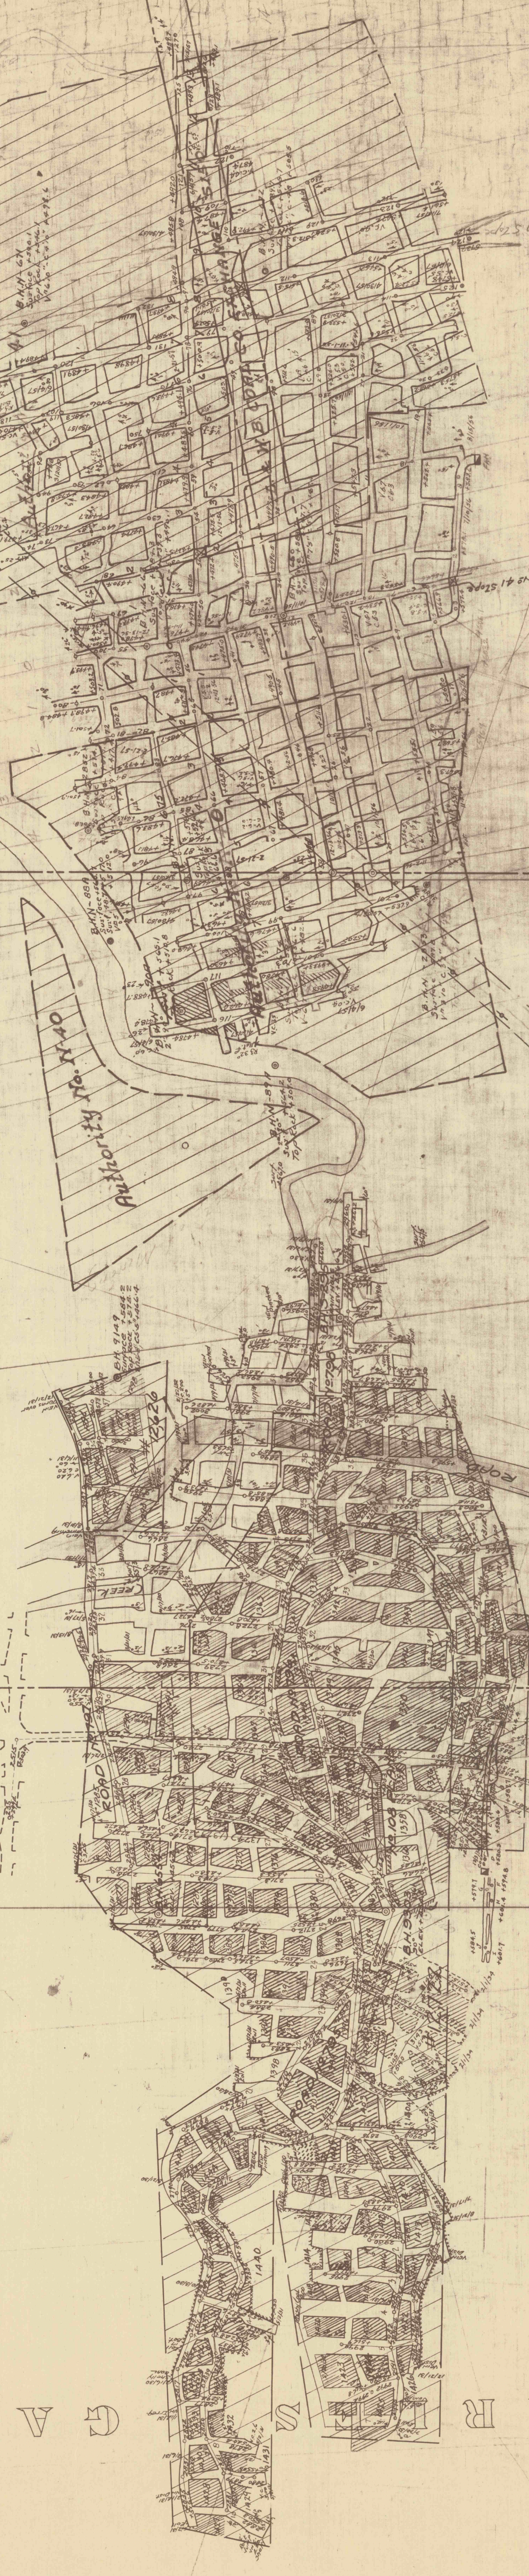

G. A. S.

I.L. 24

I.L. 25

I.L. 26

I.L. 27

L. 28

B.L. 22

10000

10000

10000