

P A R D E E

No 72-1A

L-34

L-33

L-32

L-31

L-30 1/2

01446

BH 1743
2-100 SURF +4340
VEIN 4-4" +4334

AIR SHAFT

No 2 SHAFT

BH 1820
2-100 SURF +4325
VEIN 3-2" +4306

No 1 SHAFT

BH 1857
2-100 SURF +4370
VEIN 6-0" +4363

BH 6370
2-100 SURF +4378
VEIN 6-0" +4330

BH 6326
2-100 SURF +4368
VEIN 2-0" +4335

BH 4073
2-100 SURF +4374
VEIN 2-0" +4344

BH 4072
2-100 SURF +4374
VEIN 2-0" +4344

C V R O B B I N S
A B R A M
M I N I O H

No 71-5A

BH 1594
2-100 SURF +4341
VEIN 1-0" +4334

BH 3853
2-100 SURF +4335
VEIN 1-0" +4304

BH 1528
2-100 SURF +4345
VEIN 1-0" +4308

BH 1527
2-100 SURF +4342
VEIN 2-0" +4308

BH 1526
2-100 SURF +4342
VEIN 1-0" +4312

BH 6790
2-100 SURF +4301
VEIN 2-0" +4343

BH 1595
2-100 SURF +4356
VEIN 2-0" +4307

BH 8279
2-100 SURF +4340
VEIN 1-0" +4310

BH 8280
2-100 SURF +4337
VEIN 1-0" +4310

BH 8281
2-100 SURF +4337
VEIN 1-0" +4310

SAFETY ZONE

No 1 SLOPE


No 1 SLOPE

MANWAY

No 289 TUNNEL

No 298 TUNNEL

BH 4968
2-100 SURF +4374
VEIN 1-0" +4354

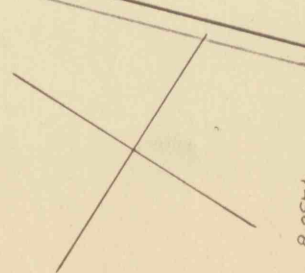

No 3 1/2

C H A