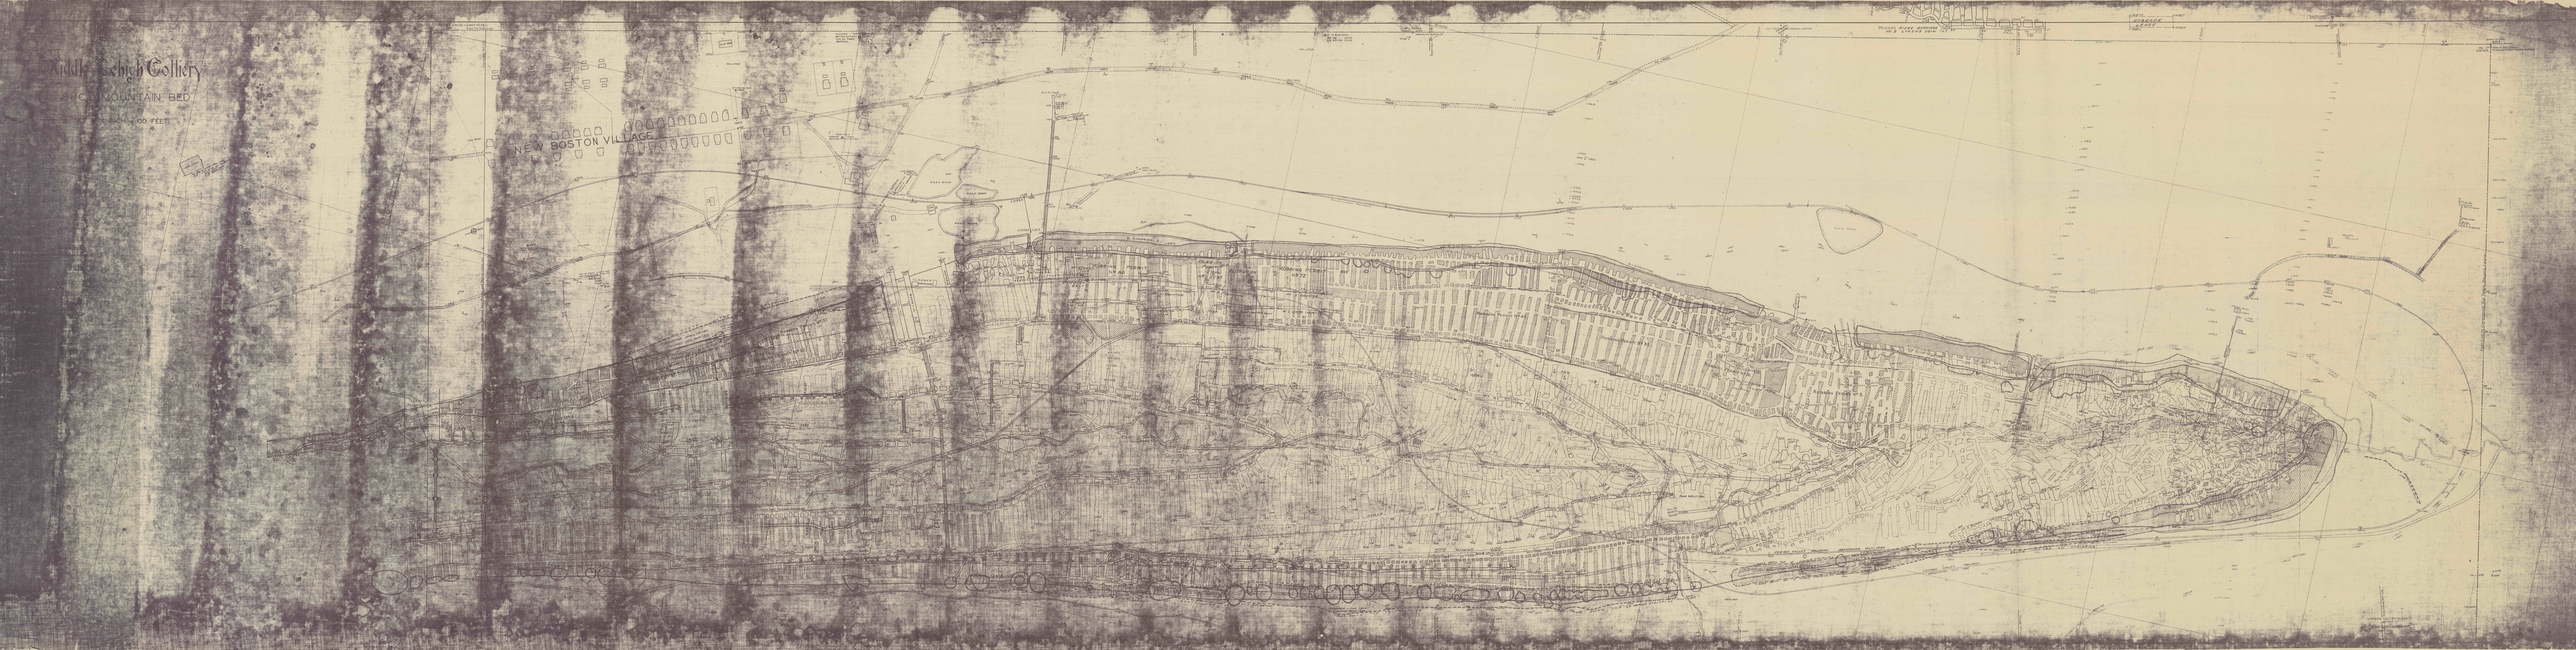

Middle Lehigh Colliery
NEW BOSTON VILLAGE