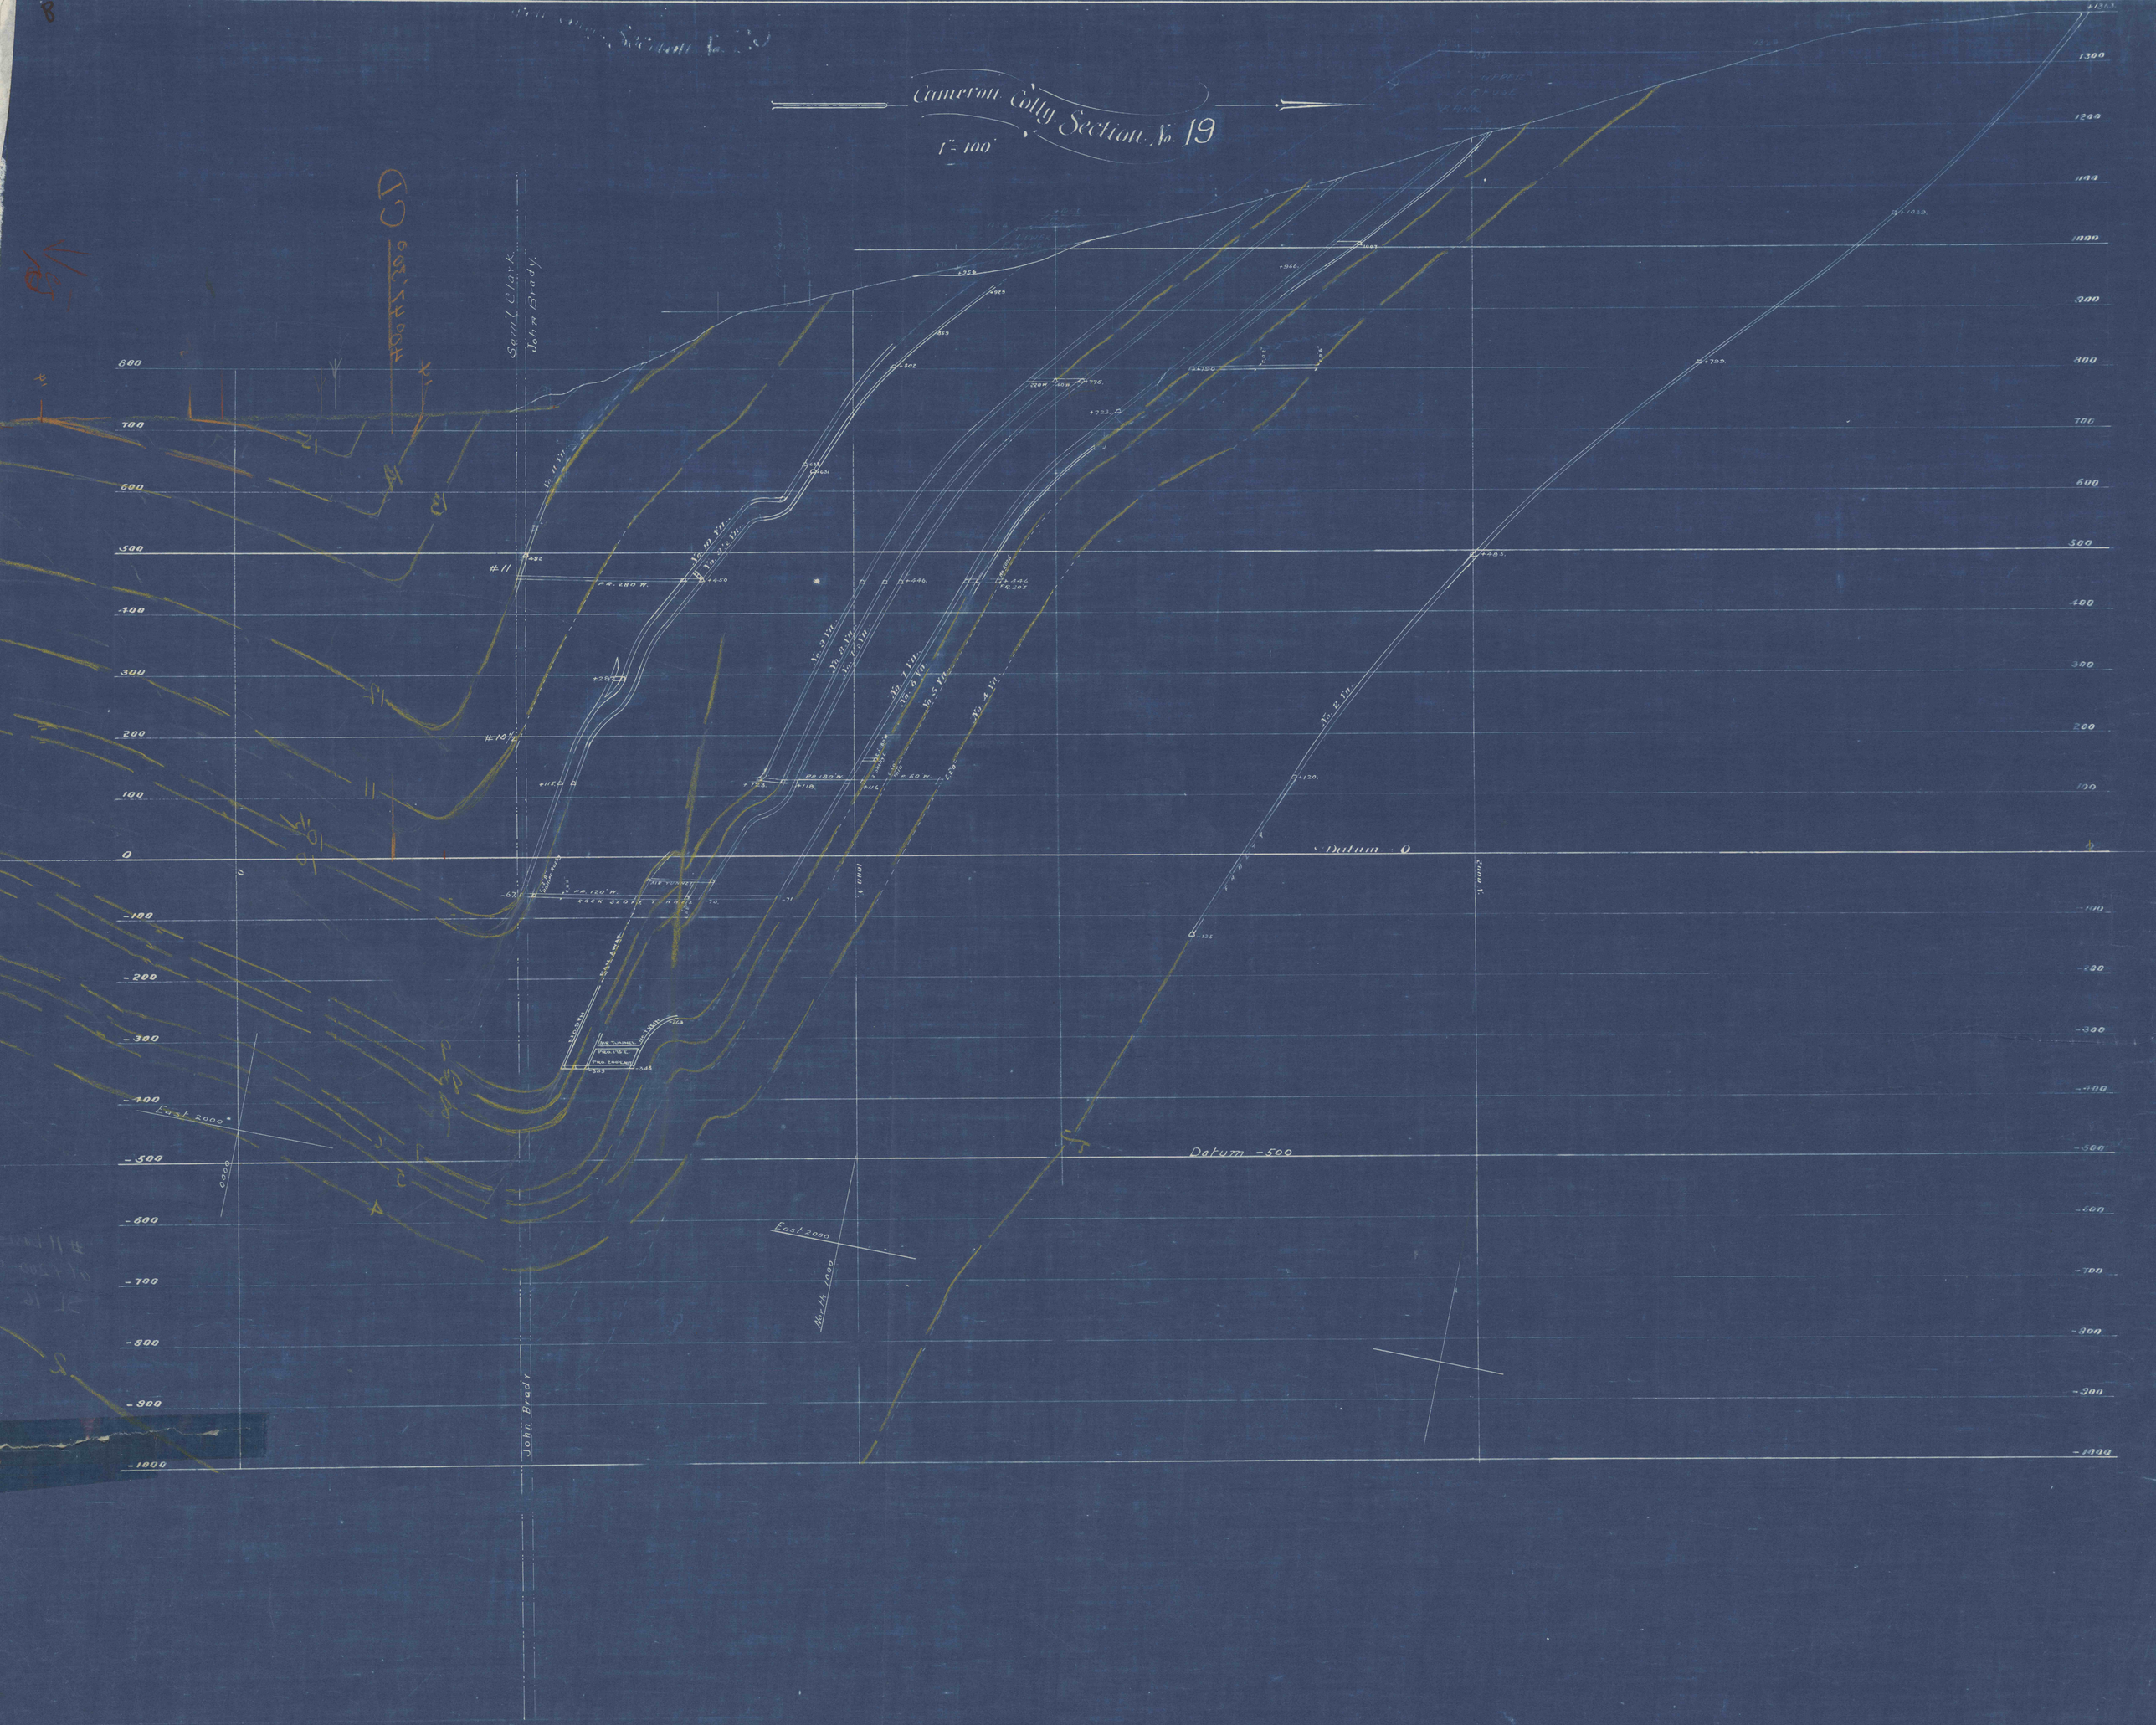
Cameron Colly. Section No. 19
1" = 100'
Second Clay R.
John W. Brady
Datum 0
Datum -500
East 2000
North 1000
John Bradt
X and Y
Y and X
No. 11 Vn.
No. 10 Vn.
No. 9 Vn.
No. 8 Vn.
No. 7 Vn.
No. 6 Vn.
No. 5 Vn.
No. 4 Vn.
No. 3 Vn.
No. 2 Vn.
#11
#10½
Pr. 280 W.
Pr. 180 W.
Pr. 60 W.
Pr. 120 W.
Pr. 50 E.
Pr. 50 W.
Pr. 50 E.
Pr. 50 W.
Pr. 50 E.
Pr. 50