



SHAMOKIN EAST
"E"
COMBINED WITH
CLAY 5 1/1
CAMERON SECT. NO. 23
BE 8A
X-356

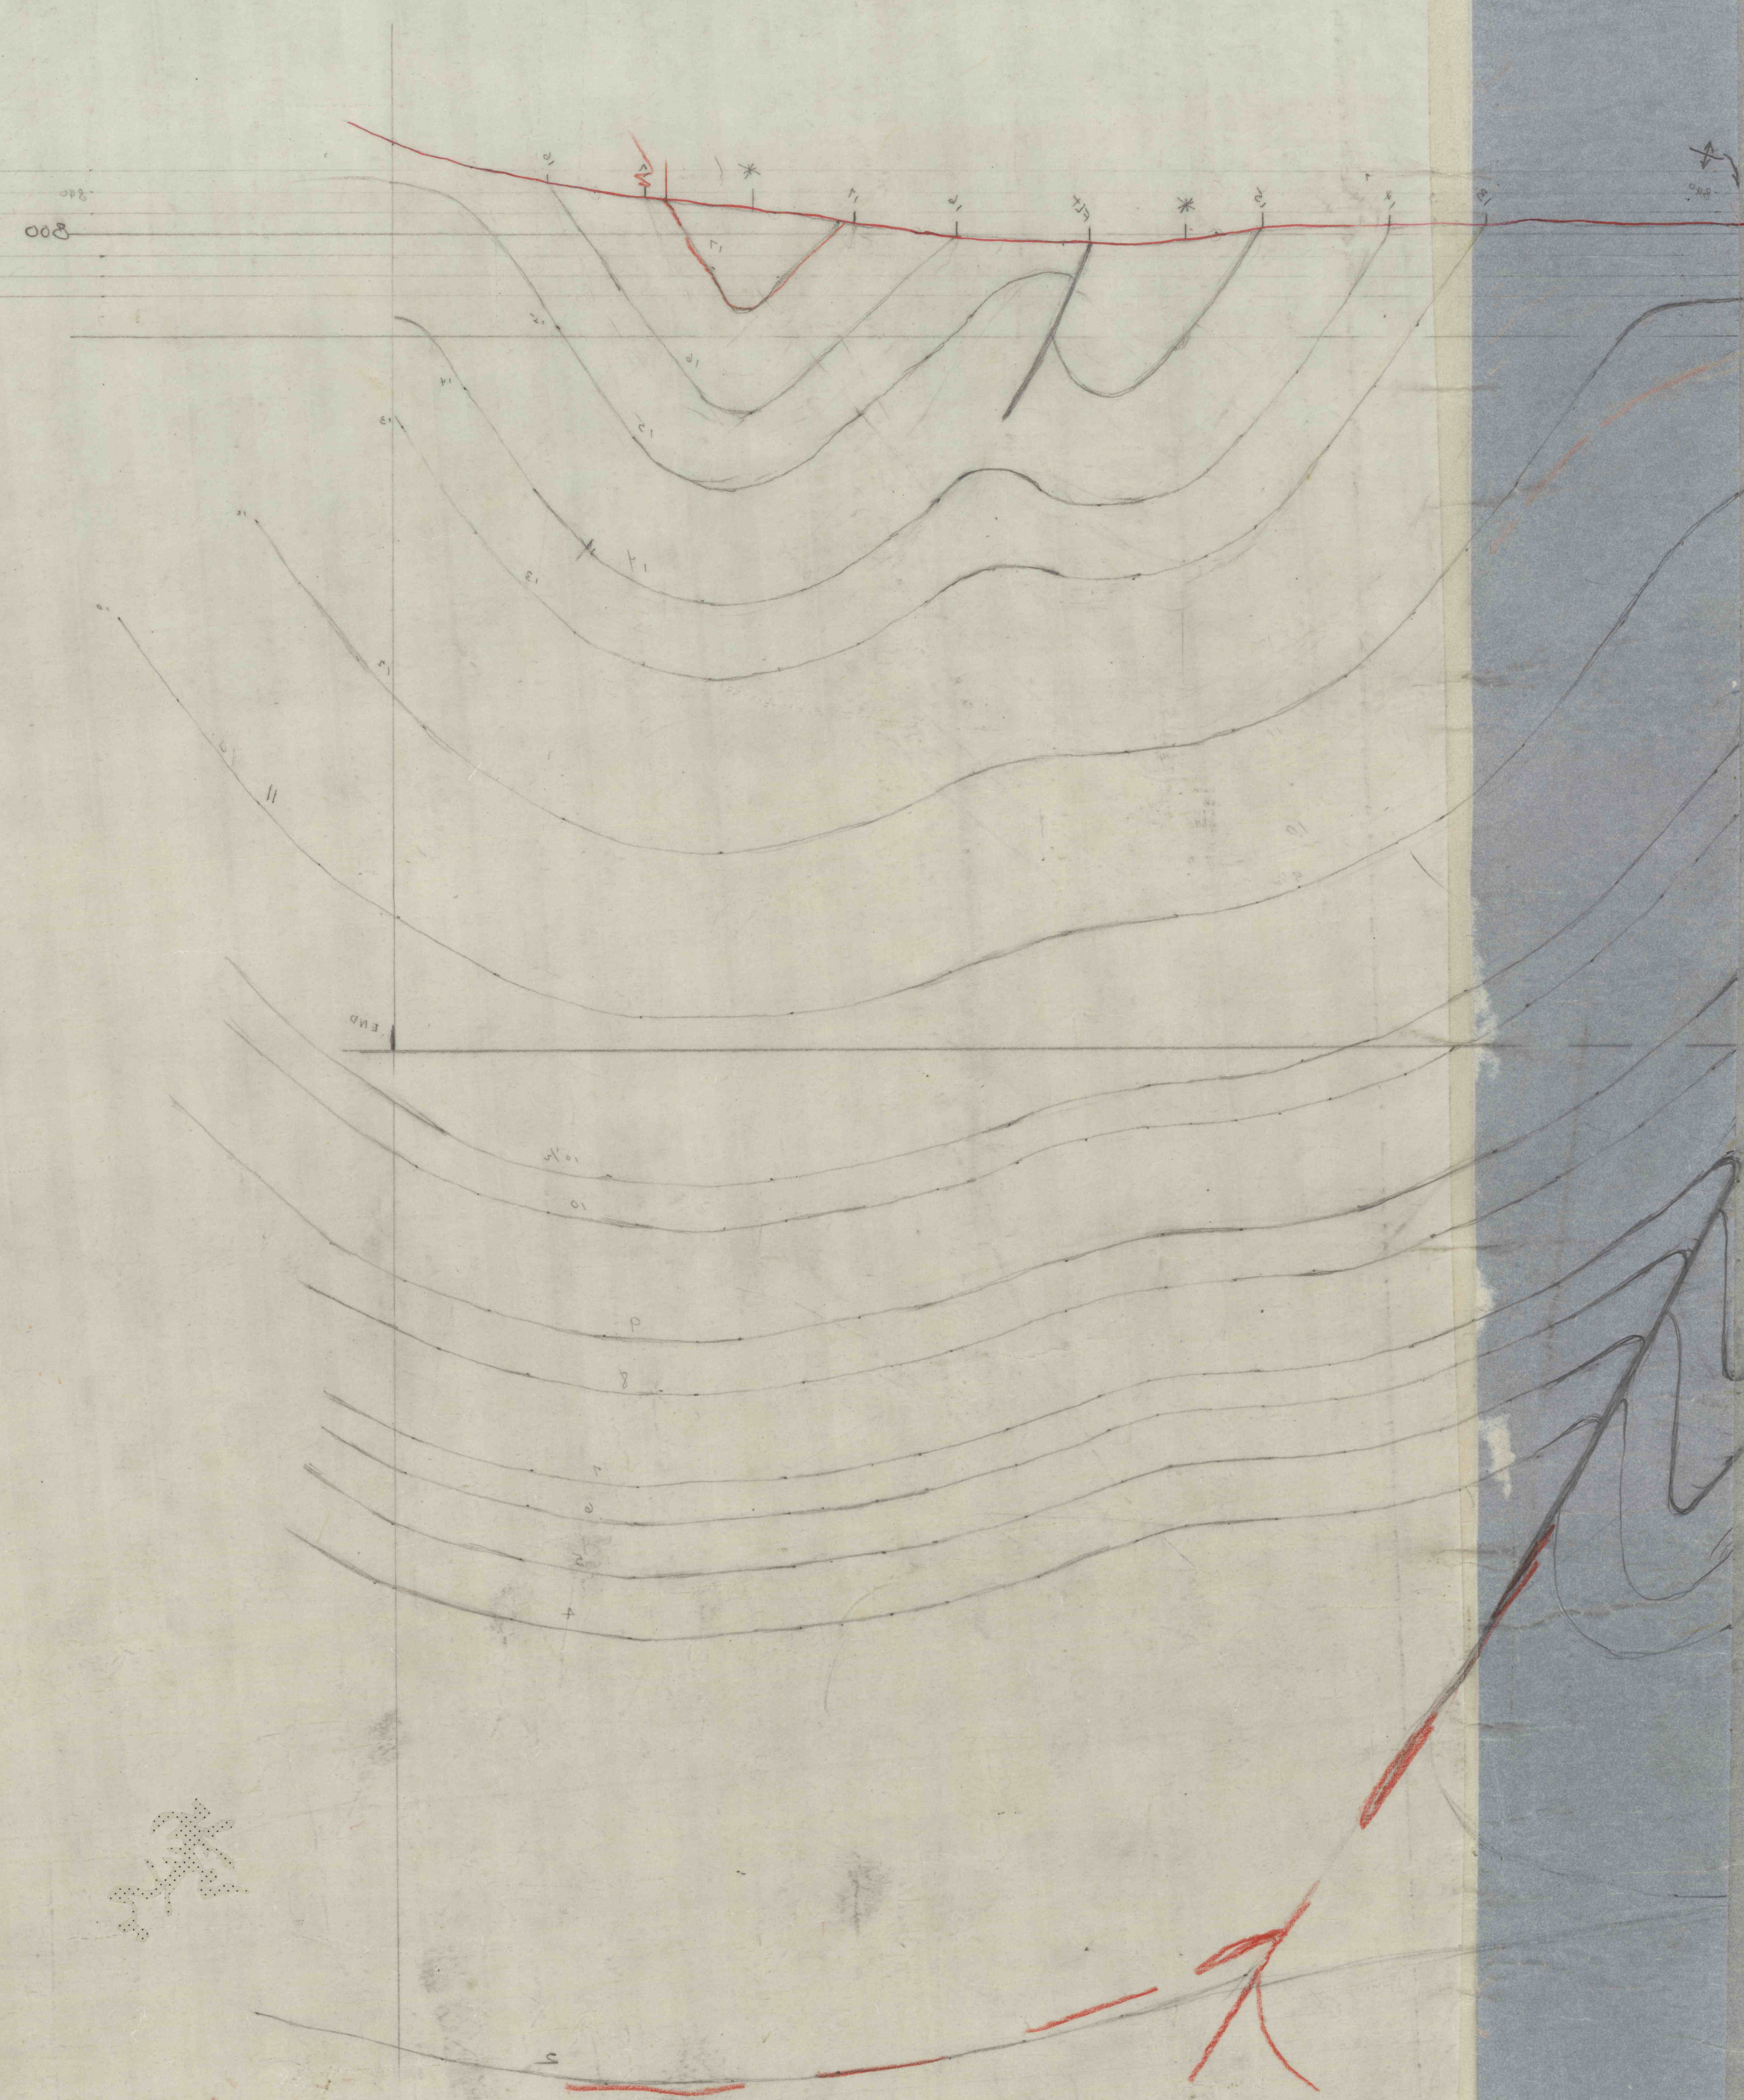

No. 23

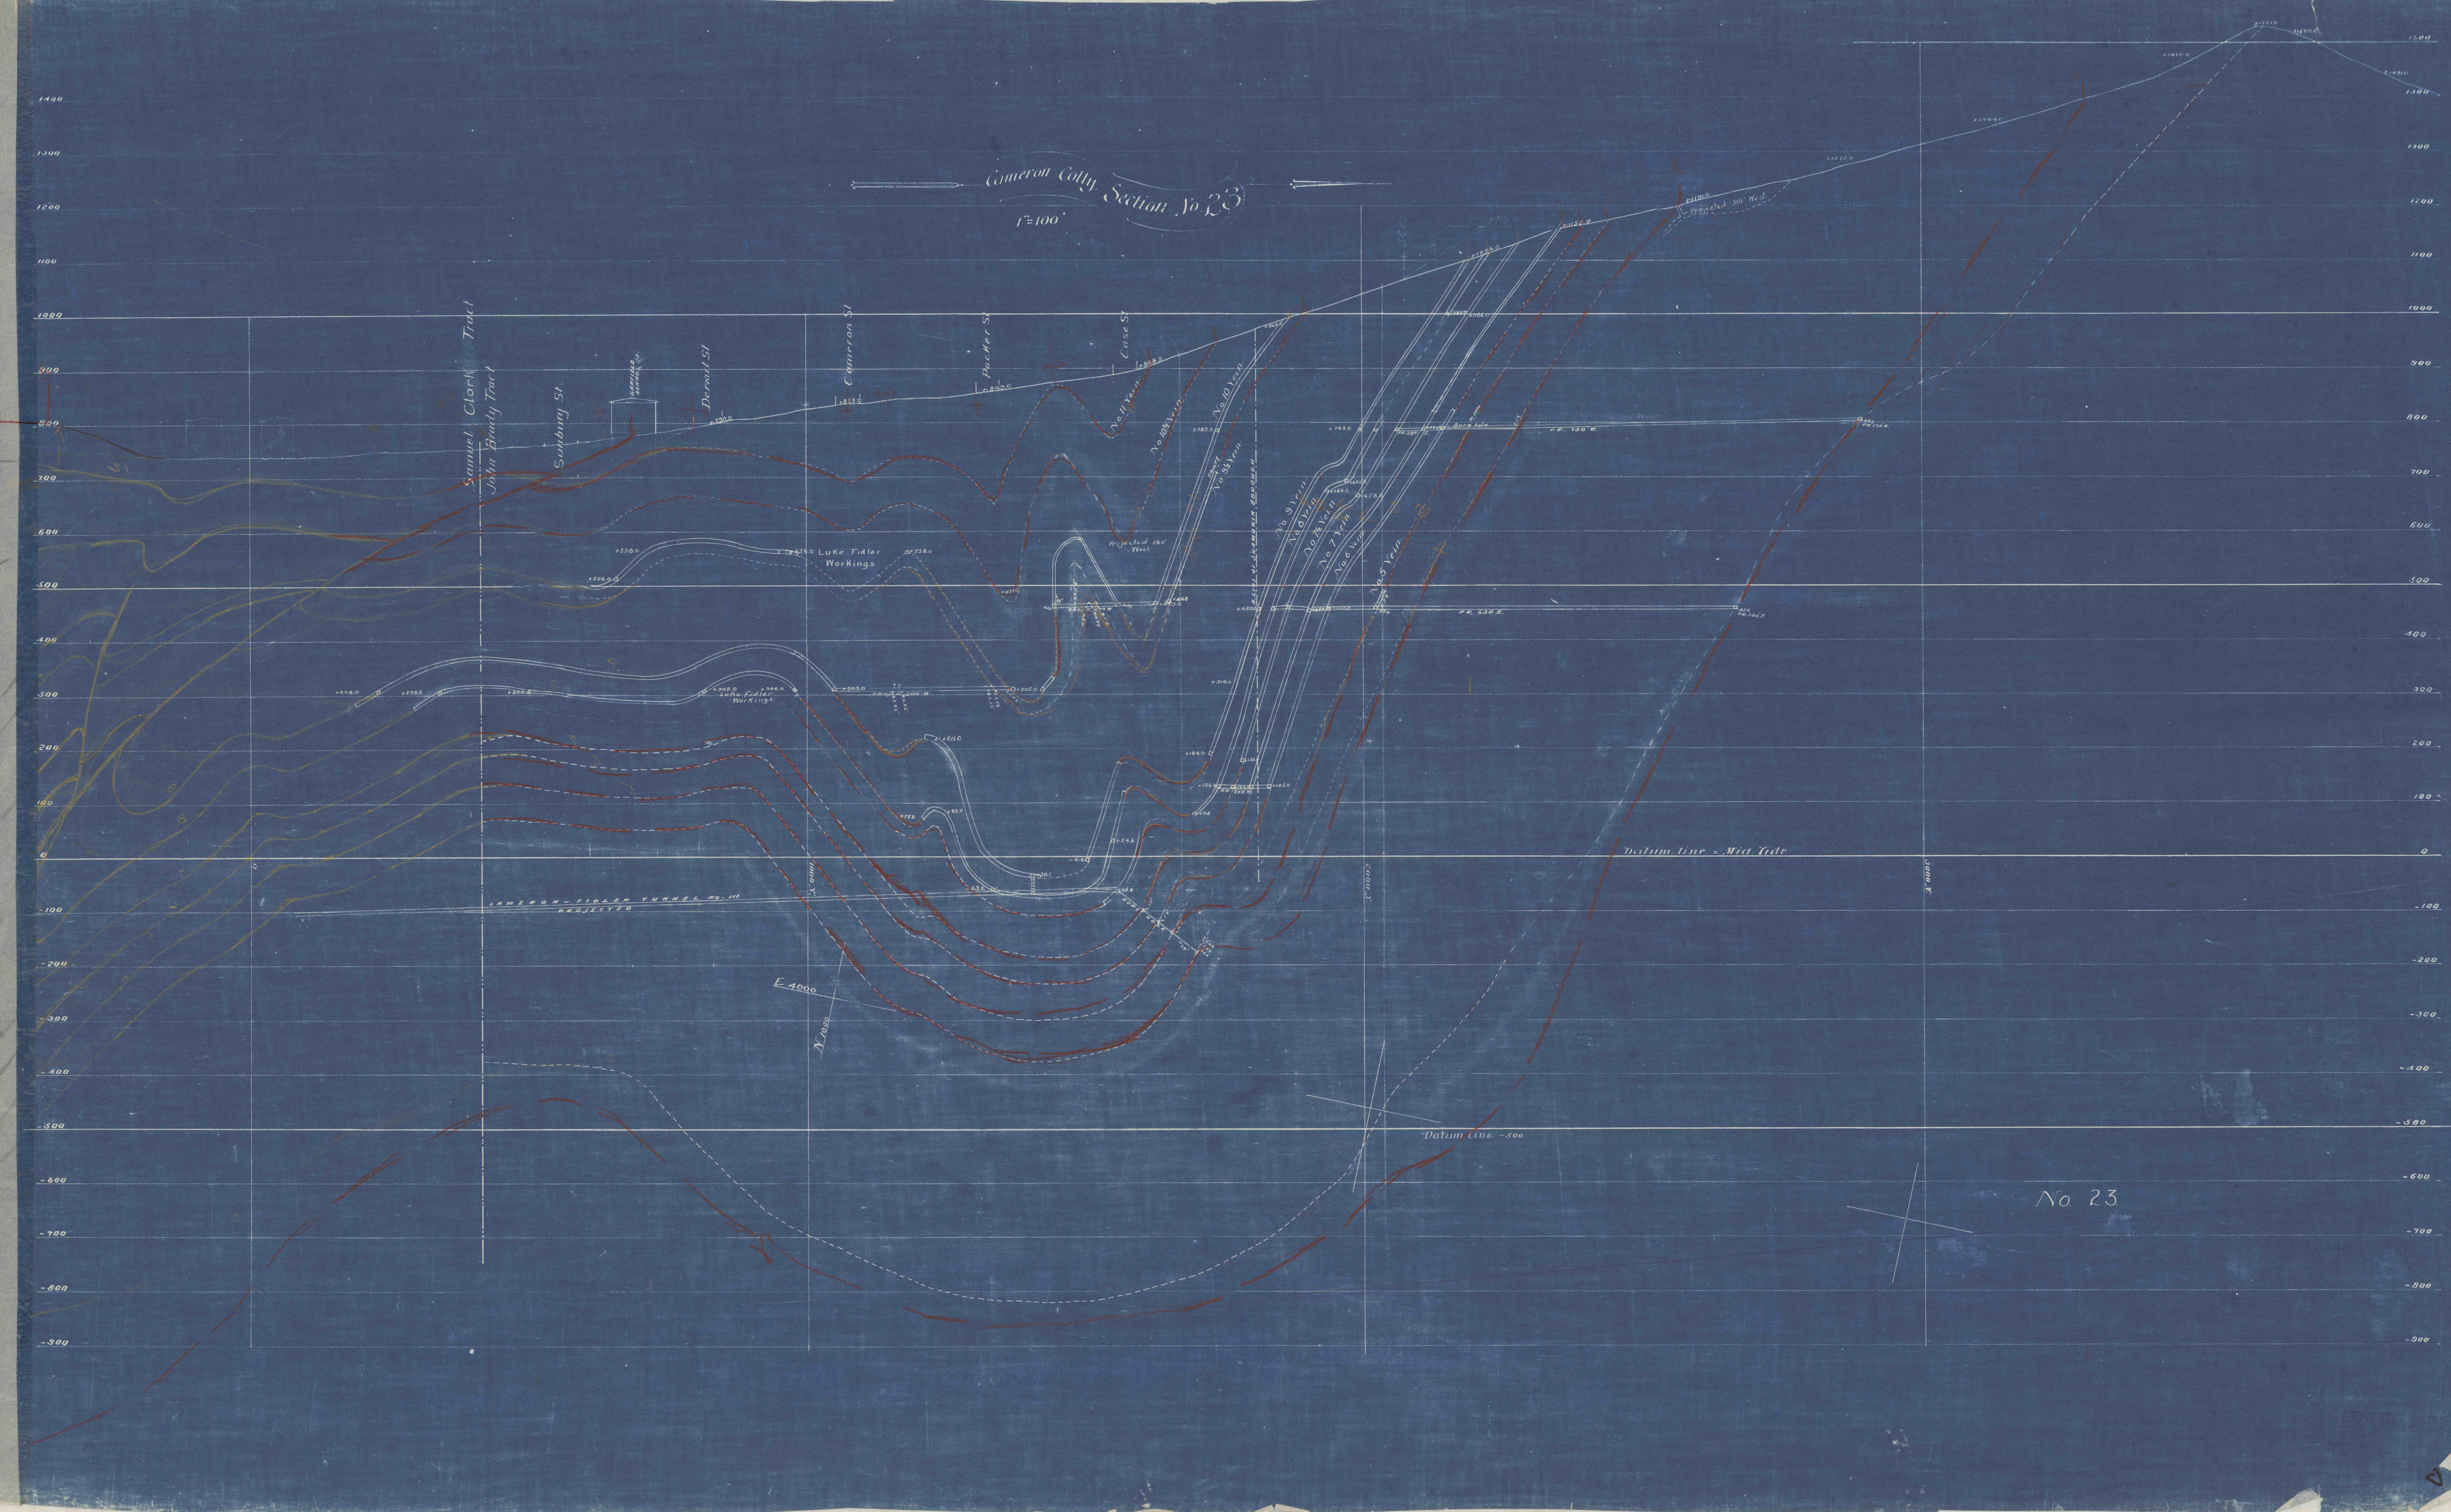

No. 23