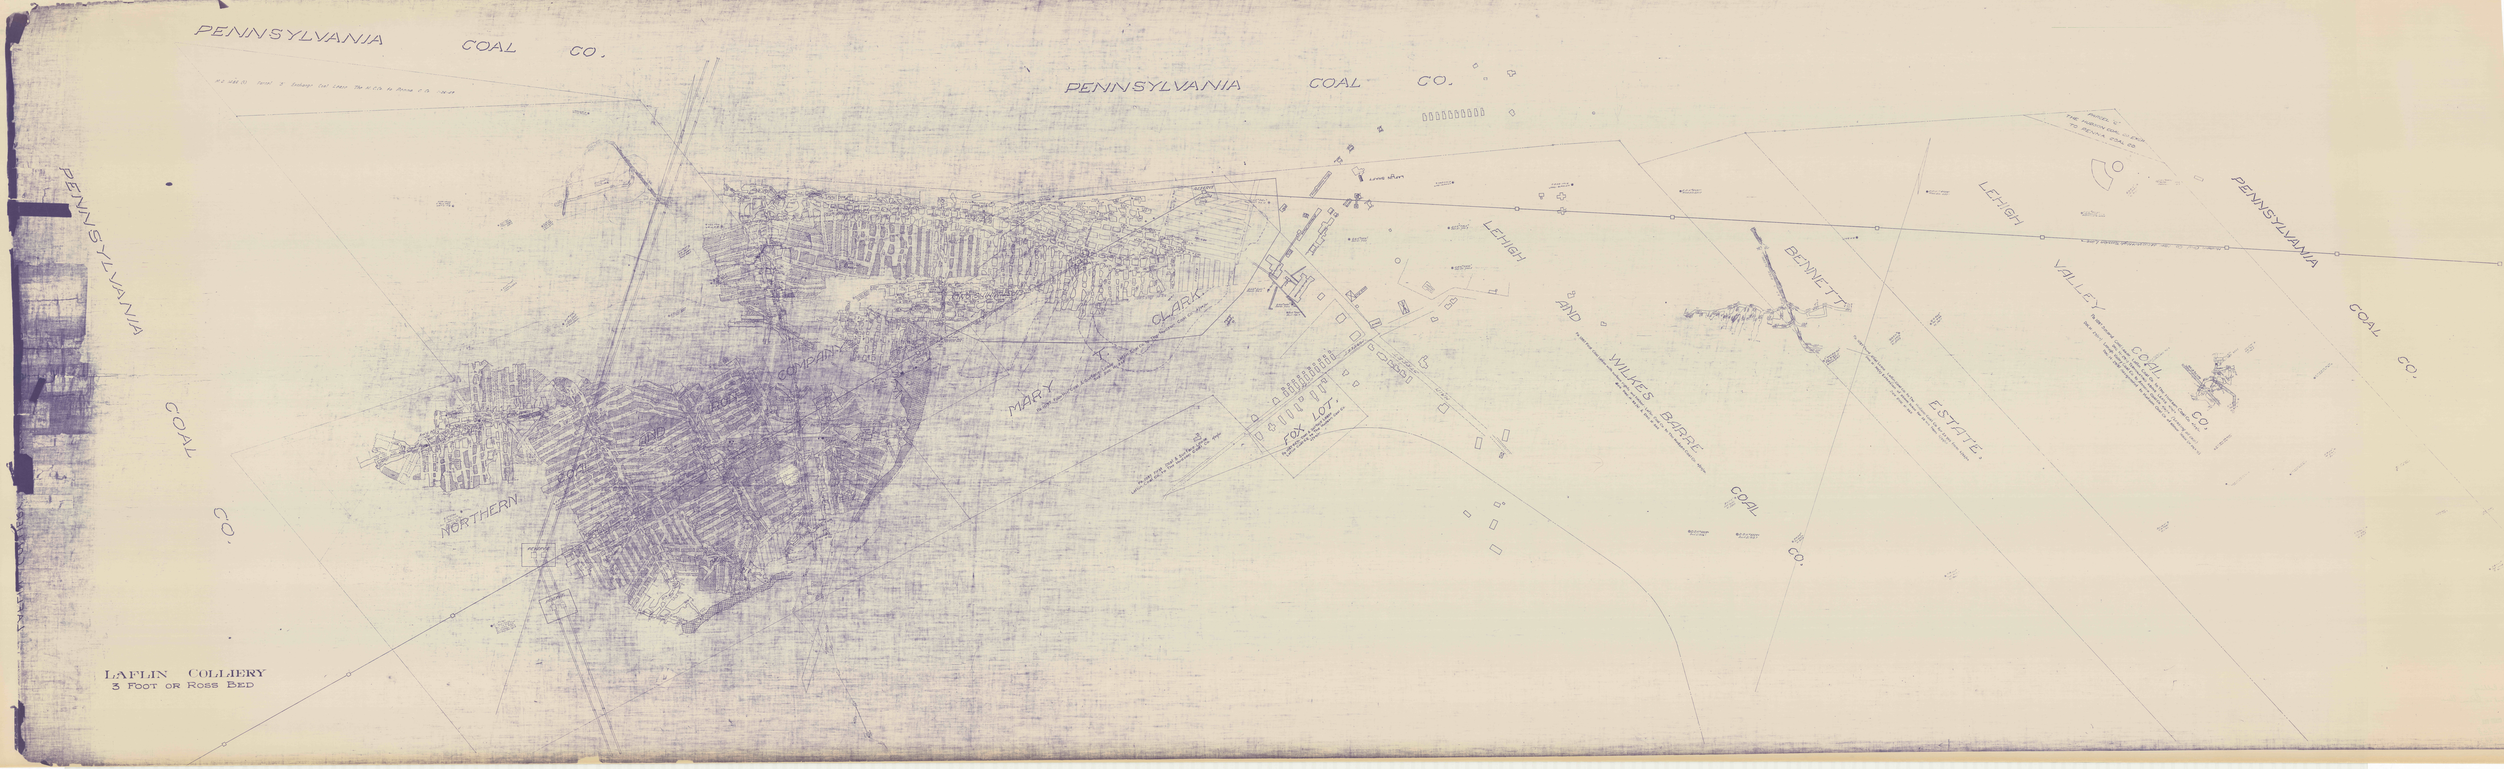

PENNSYLVANIA COAL CO.
PENNSYLVANIA COAL CO.
PENNSYLVANIA COAL CO.
LEHIGH AND WILKES BARRE COAL CO.
LEHIGH VALLEY COAL CO.
PENNSYLVANIA COAL CO.
BENNETT ESTATE.
NORTHERN COMPANY
MARY CLARK
FOX LOT.
LAFLIN COLLIERY
3 FOOT OR ROSS BED