


L A FLIN-HEIGHTS
COAL CO.
BOTTOM RED ASH VEIN

Sheet No. N-827B.

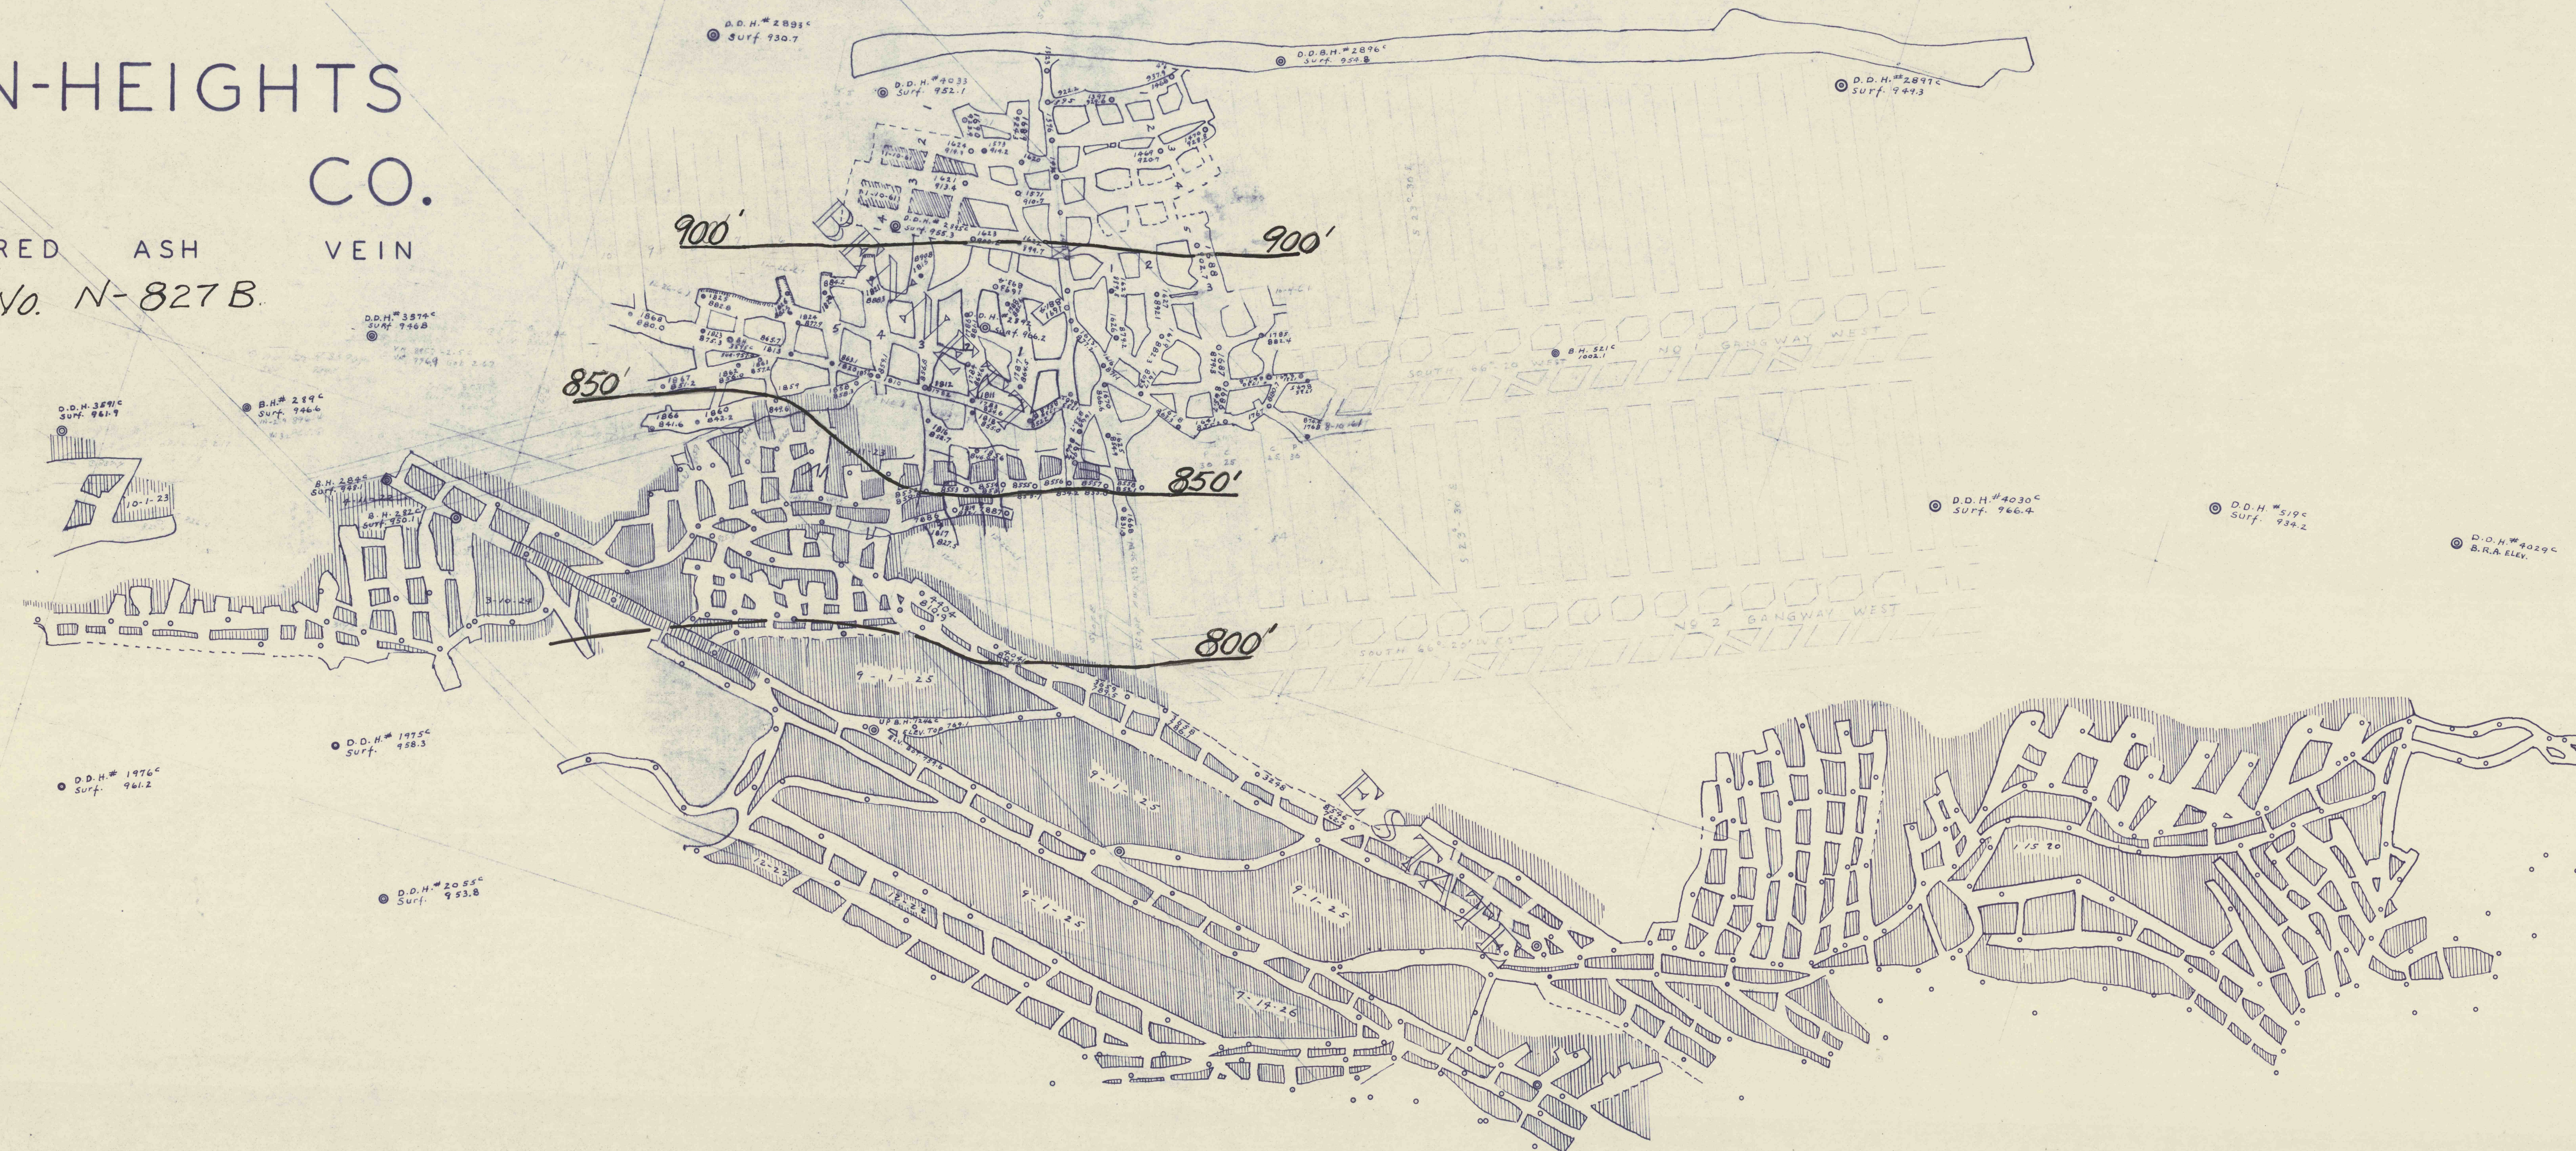

Laflin-Heights Coal Co.
Geological Map

BOT. RED ASH
SUPPLEMENT