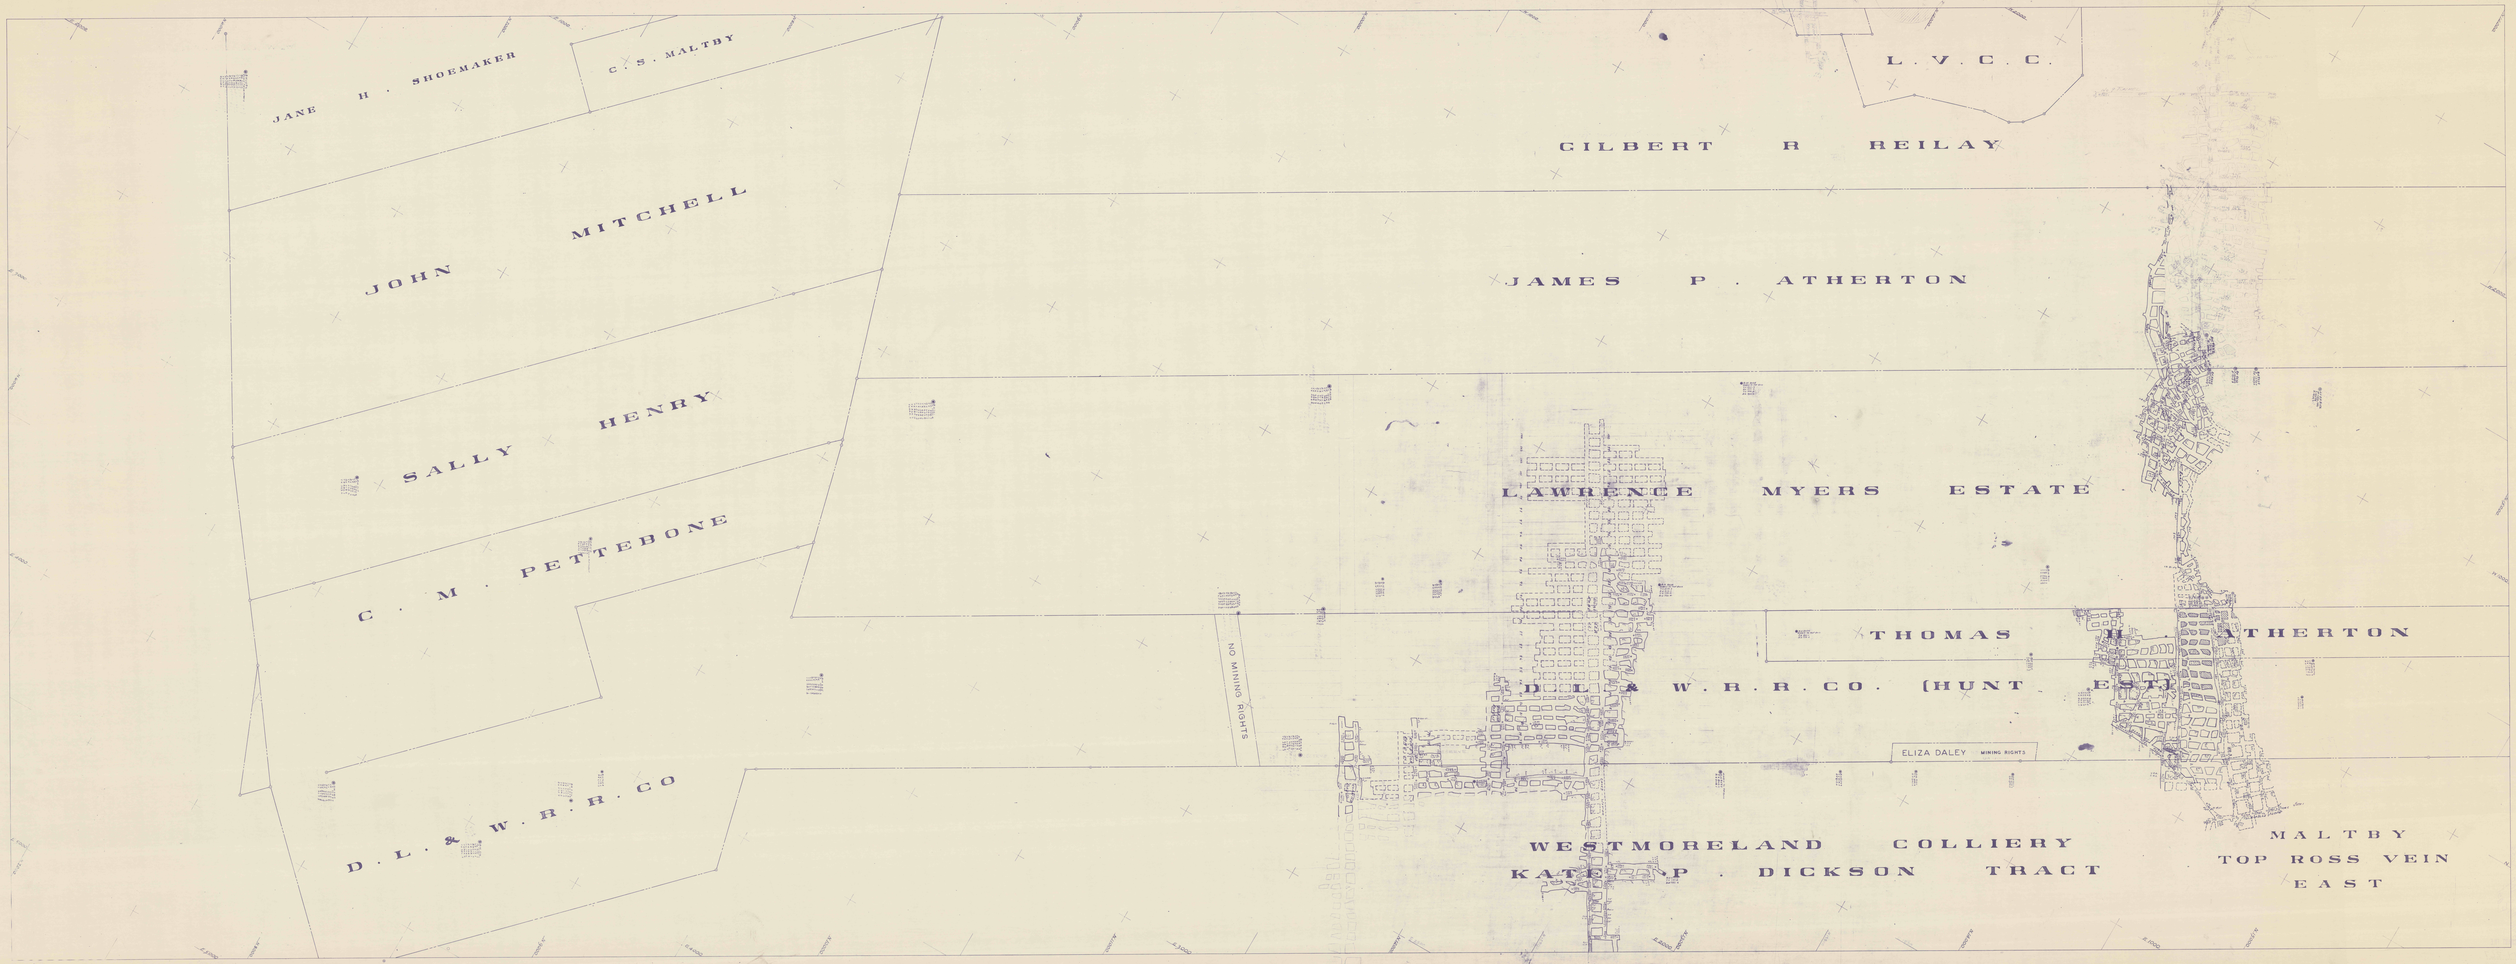
JANE H. SHOEMAKER
C. S. MALTBY
JOHN MITCHELL
SALLY HENRY
C. M. PETTEBONE
D. L. & W. R. R. CO
L. V. C. C.
GILBERT R REILAY
JAMES P. ATHERTON
LAWRENCE MYERS ESTATE
THOMAS H. ATHERTON
D. L. & W. R. R. CO. (HUNT ESTATE)
NO MINING RIGHTS
ELIZA DALEY MINING RIGHTS
WESTMORELAND COLLIERY
KATE P. DICKSON TRACT
MALTBY
TOP ROSS VEIN
EAST