


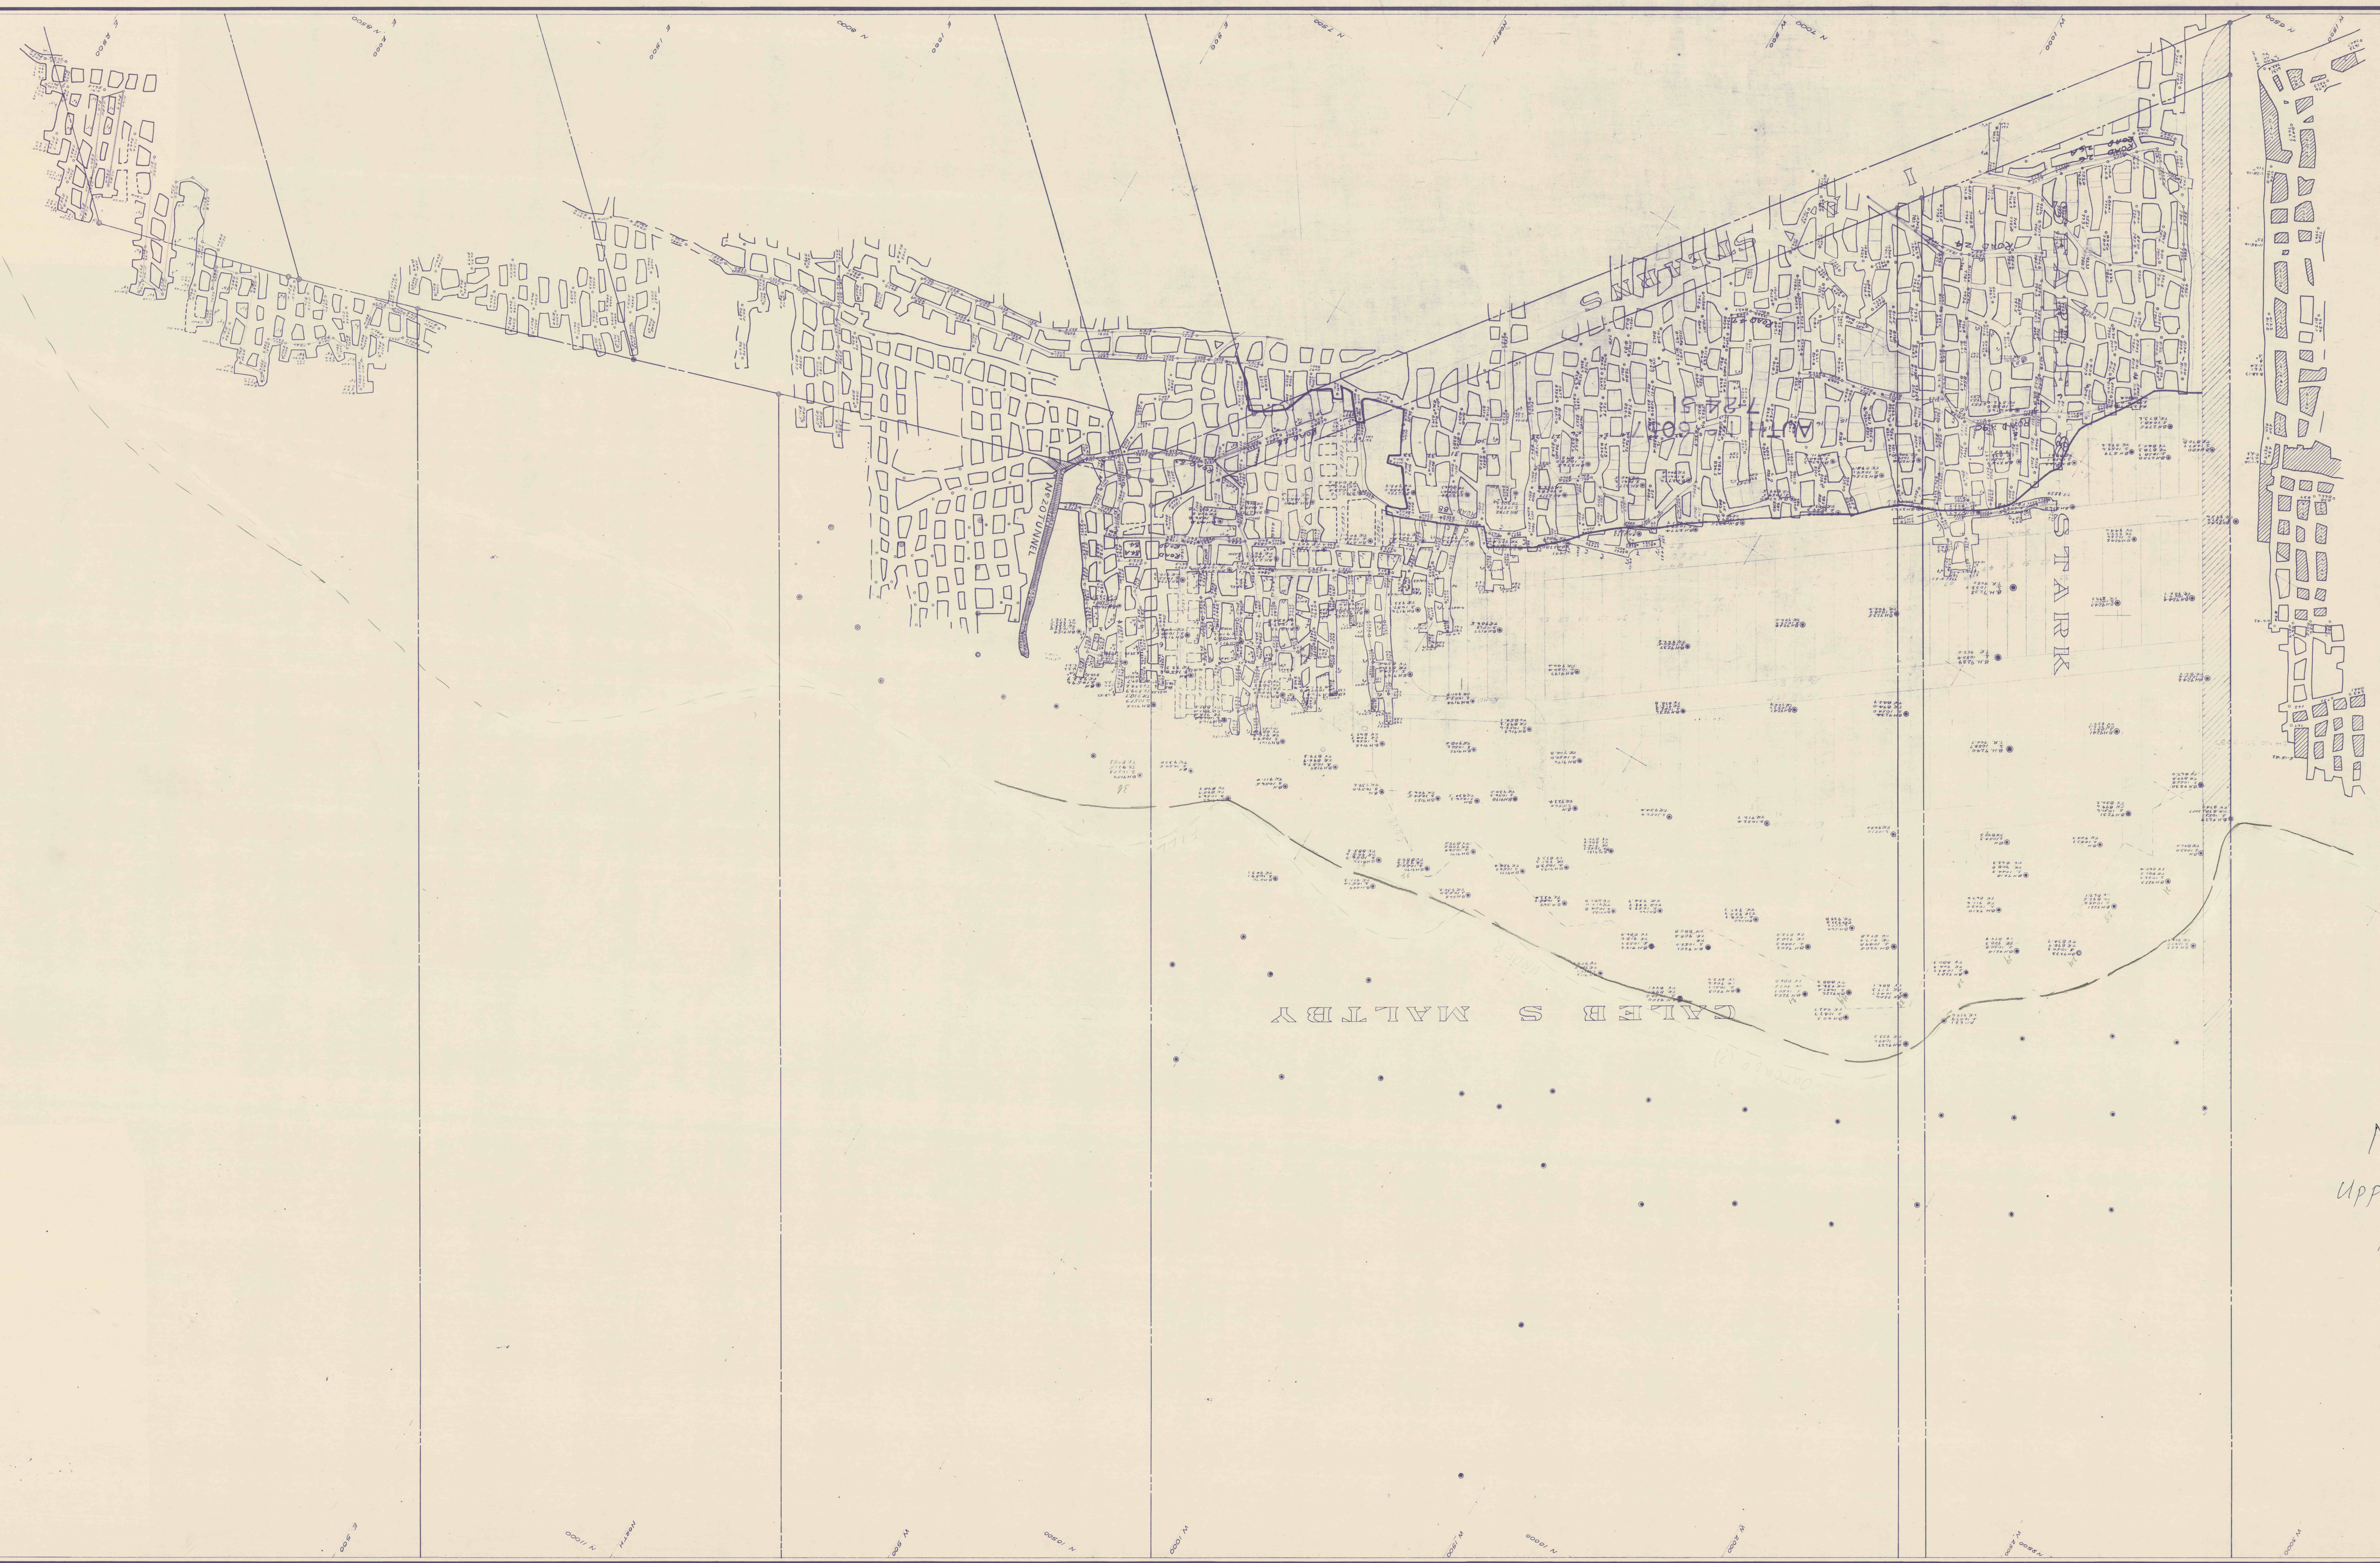

Maltby
Upper Baltimore
Middle