


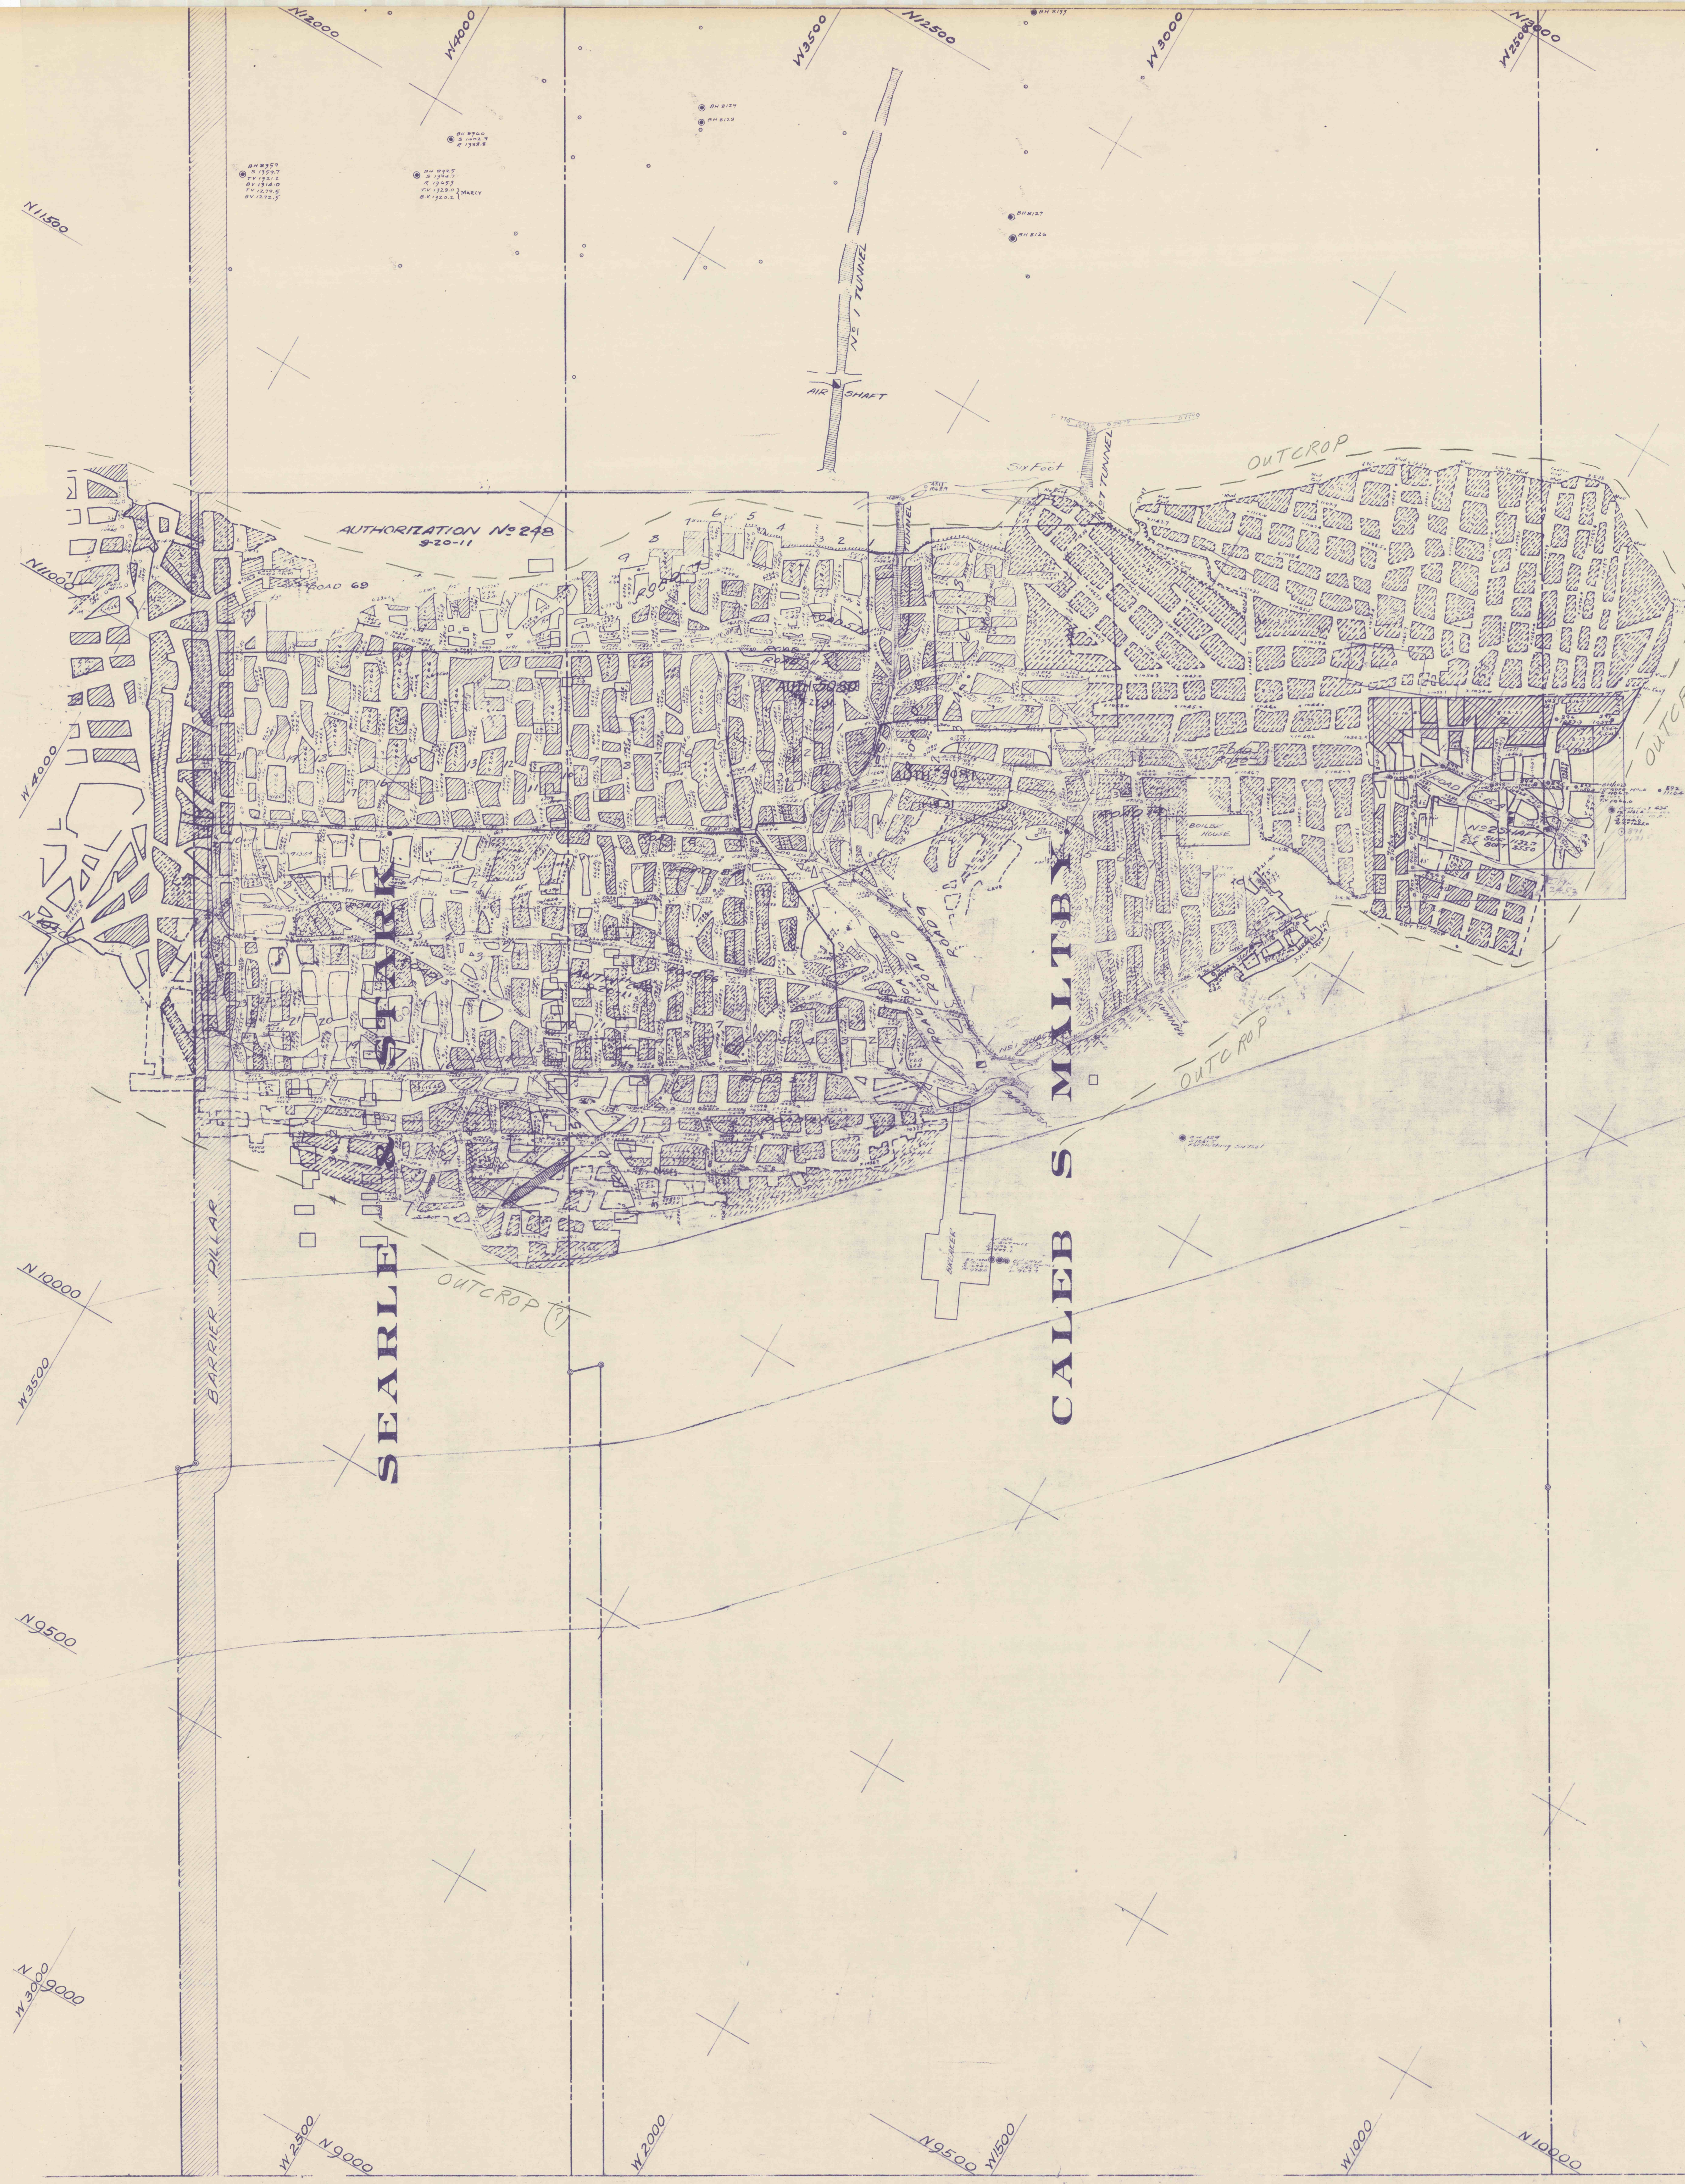

AUTHORIZATION No 248
9-20-11

SEARLE

CALEB S MALTBY

G. R. REILAY.

J. P. A THERTON.

L. MYERS

MALTBY
OUTSIDE FOUR FOOT VEIN
DATUM 500' BELOW TIDE 1:200