

24-48

WATER LOB

ADIN



FORTY FORT

DANIEL SEARLE & JOHN M. STARK

C. S. MALTBY

G. R. REILAY

JAS. P. ATHERTON

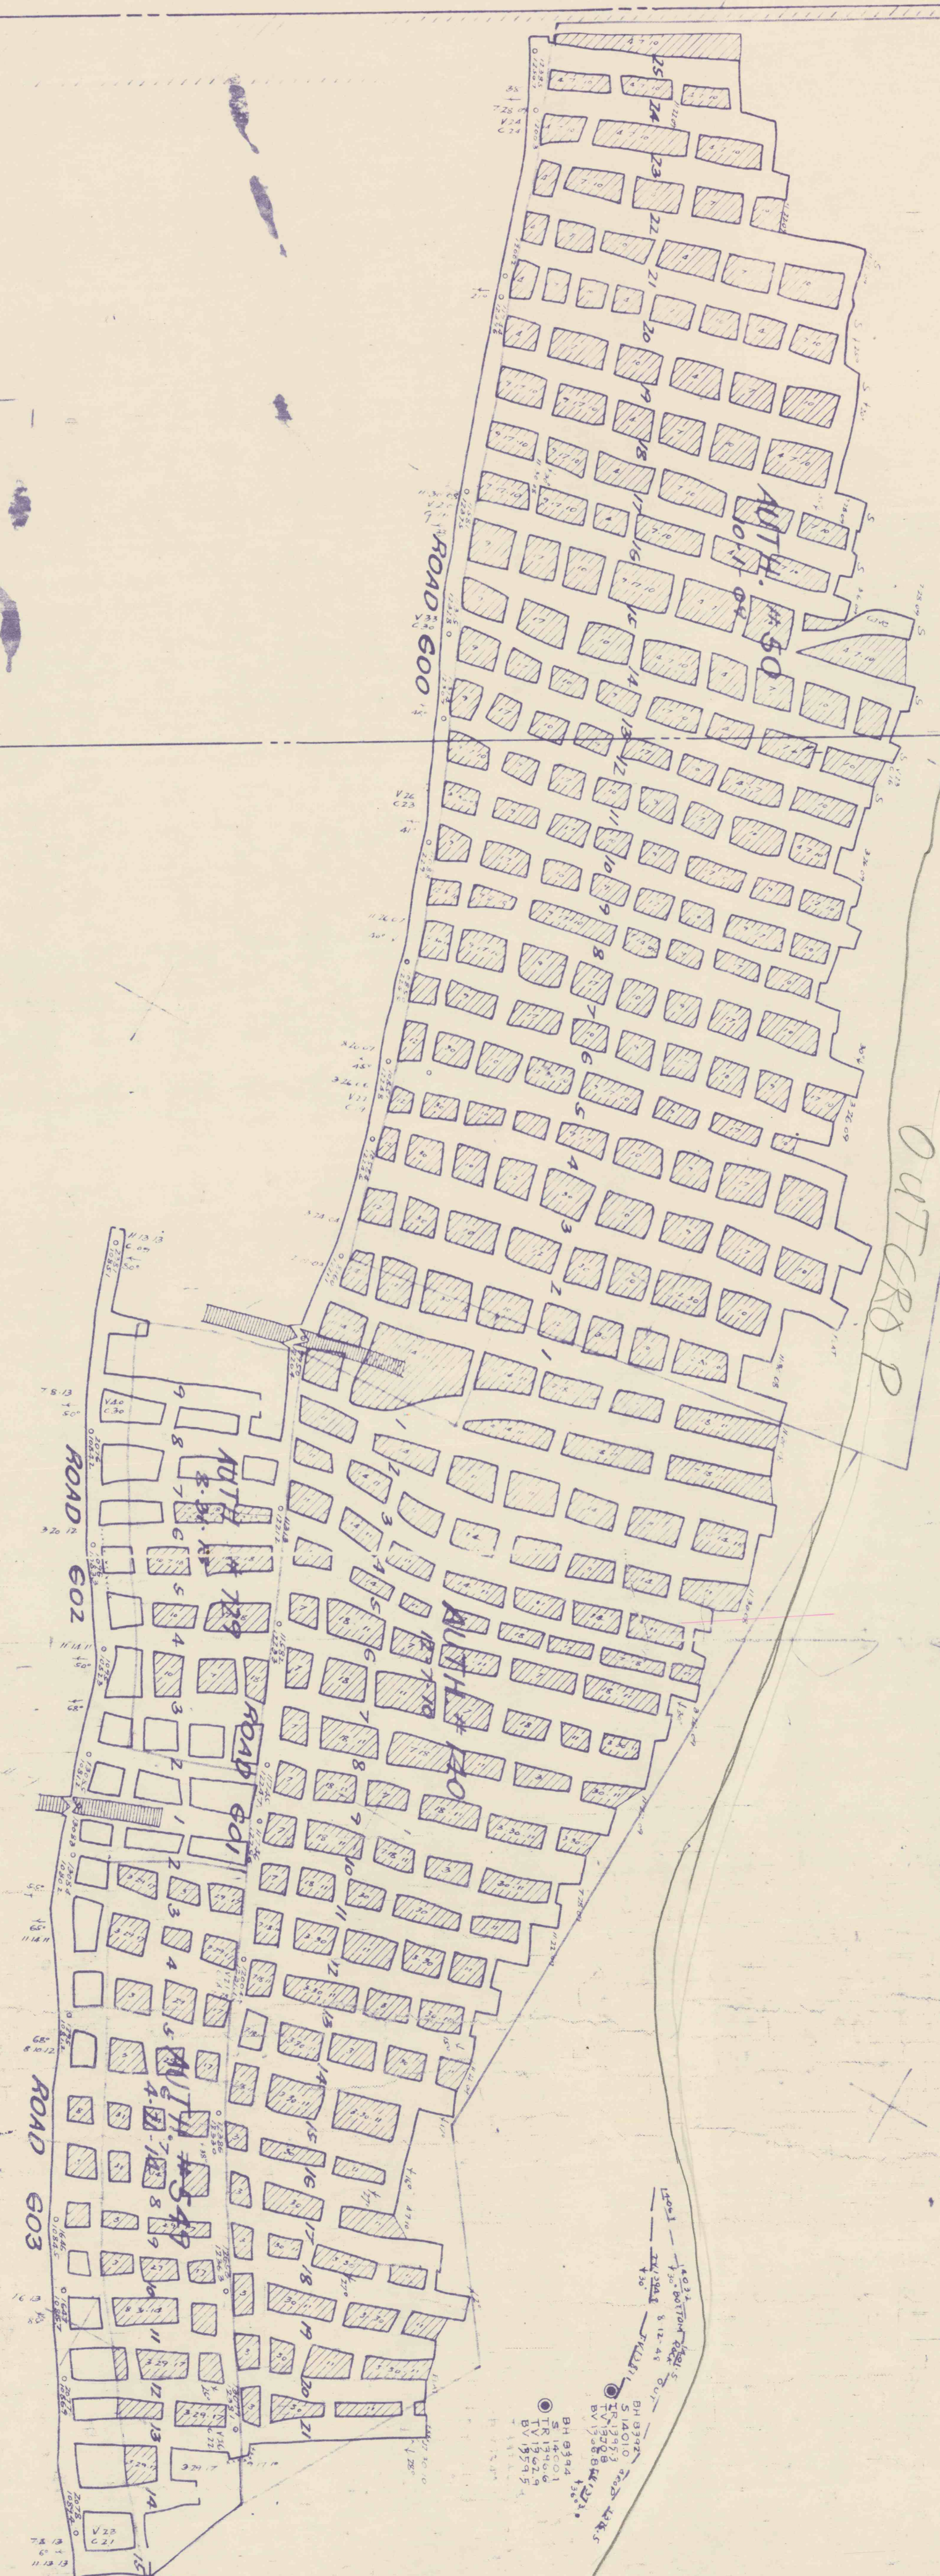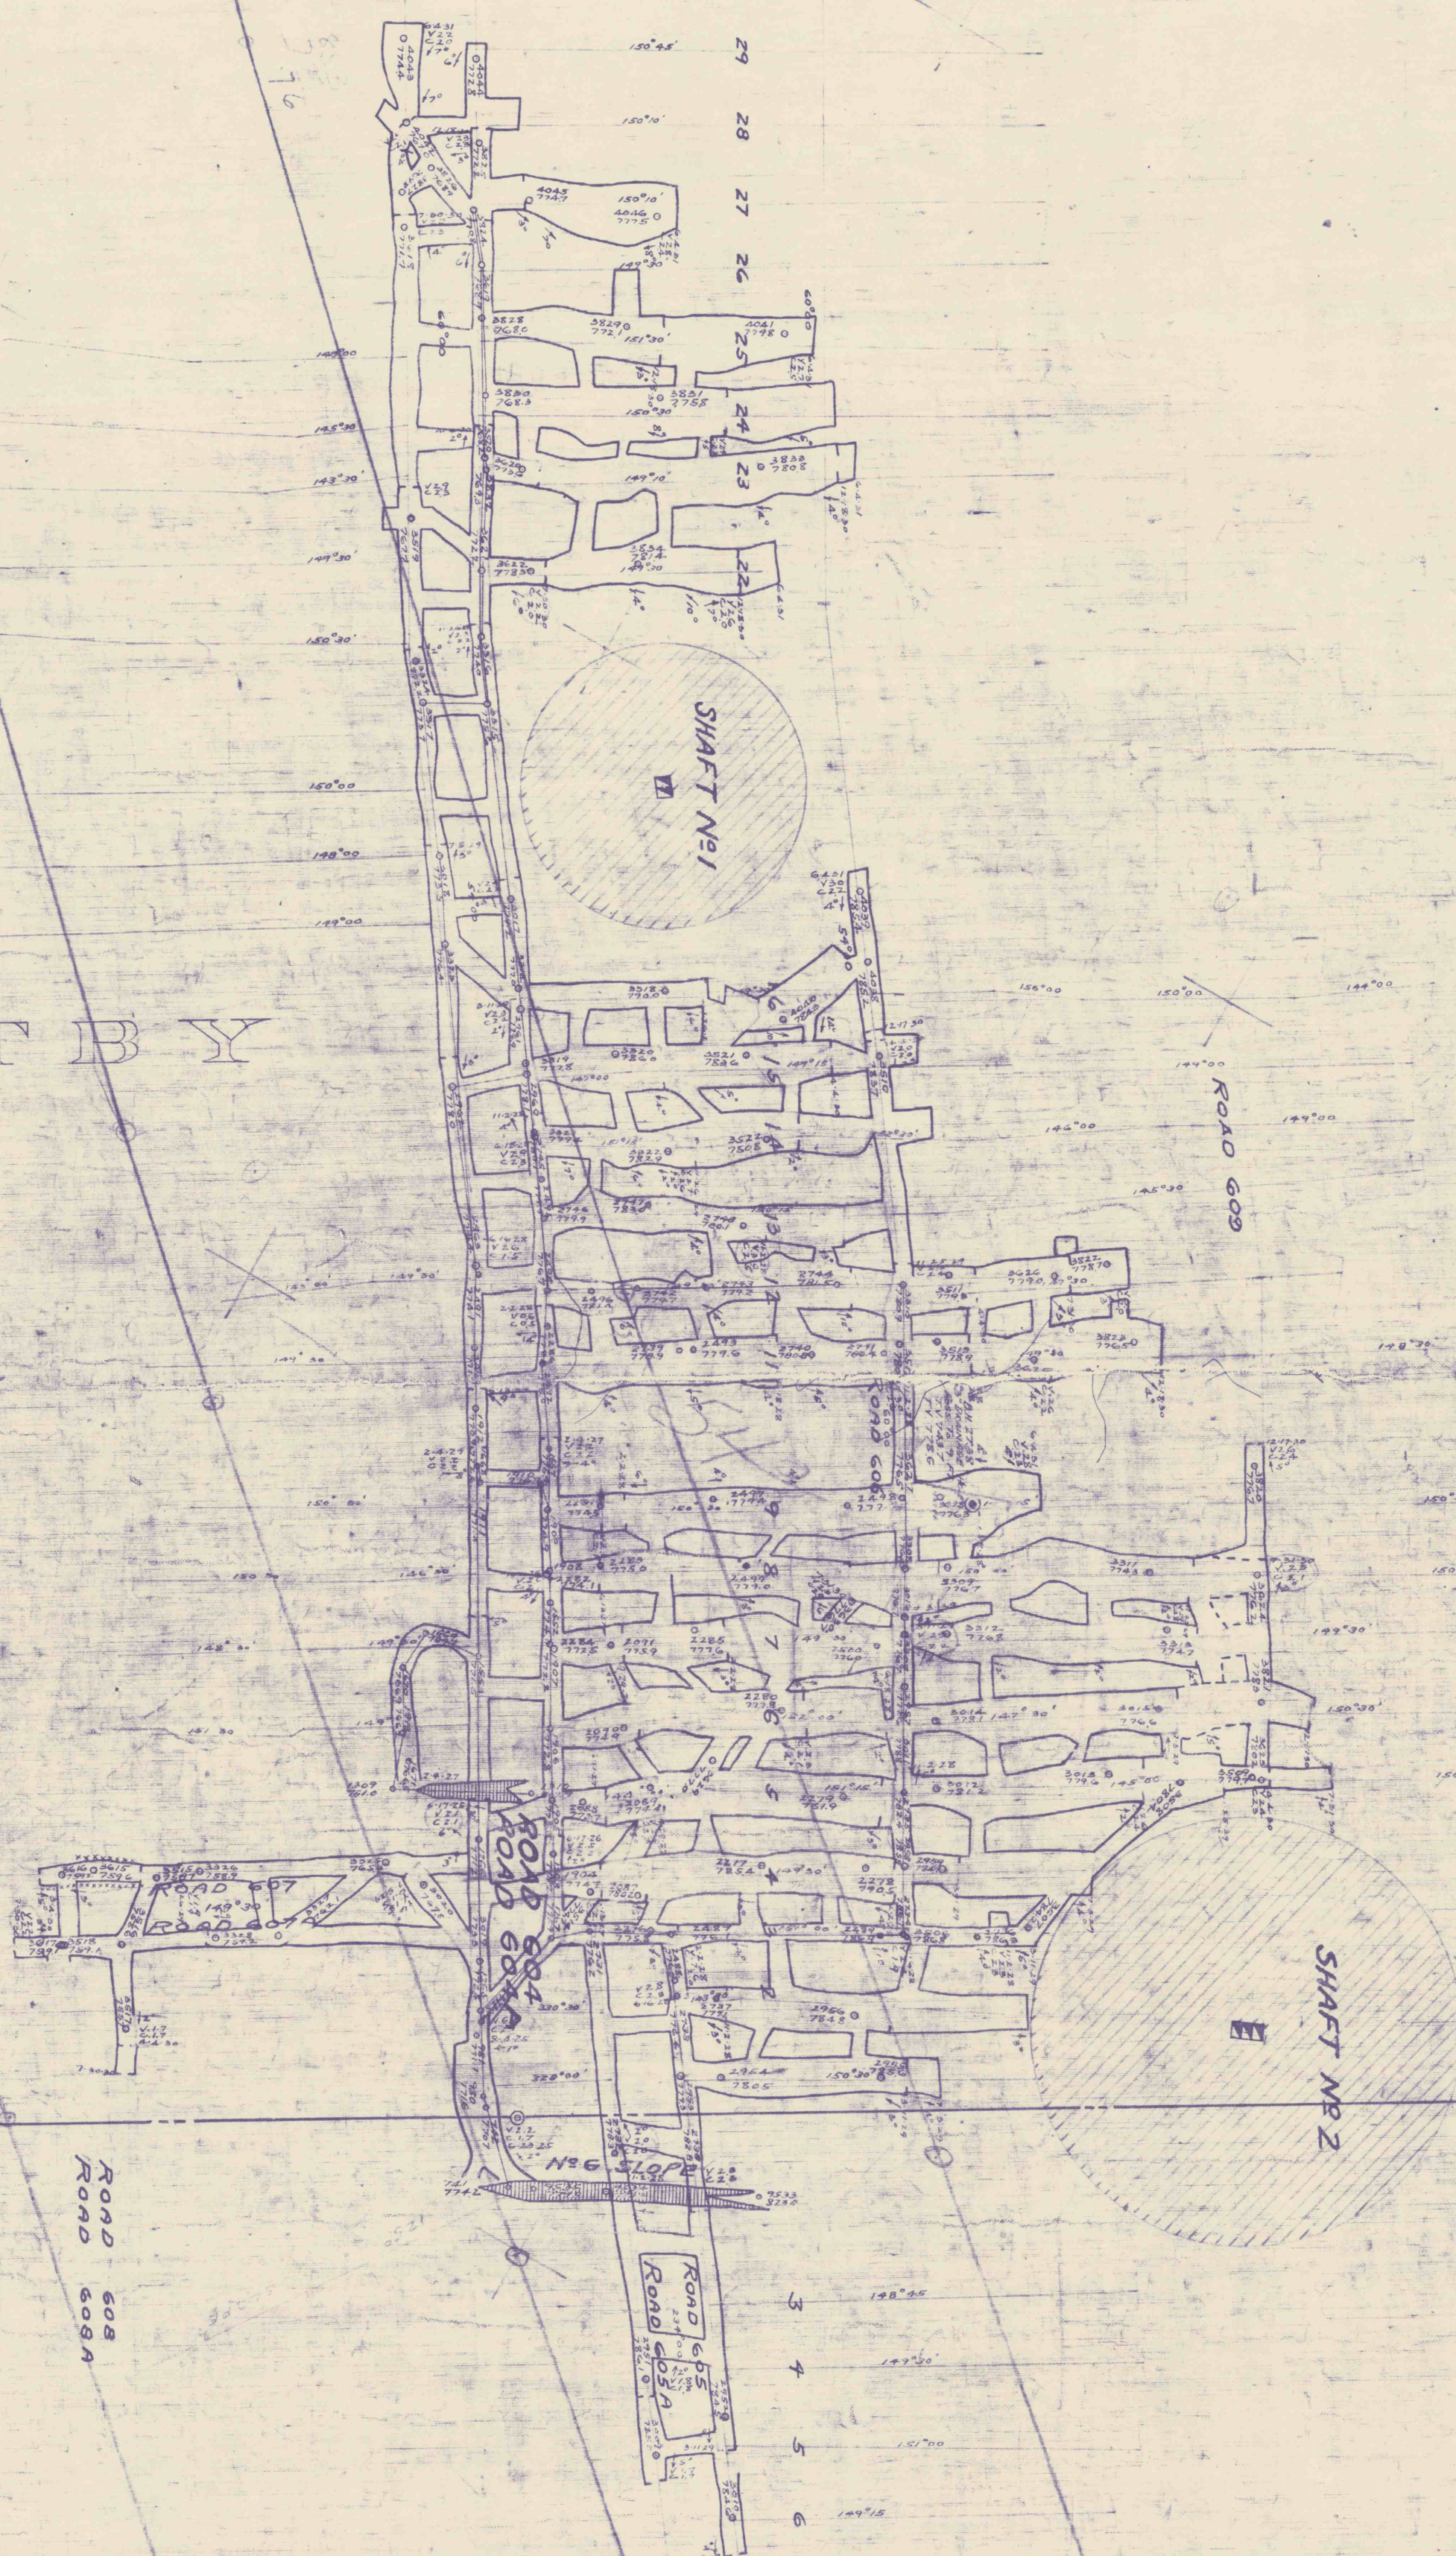

OUTRIG




