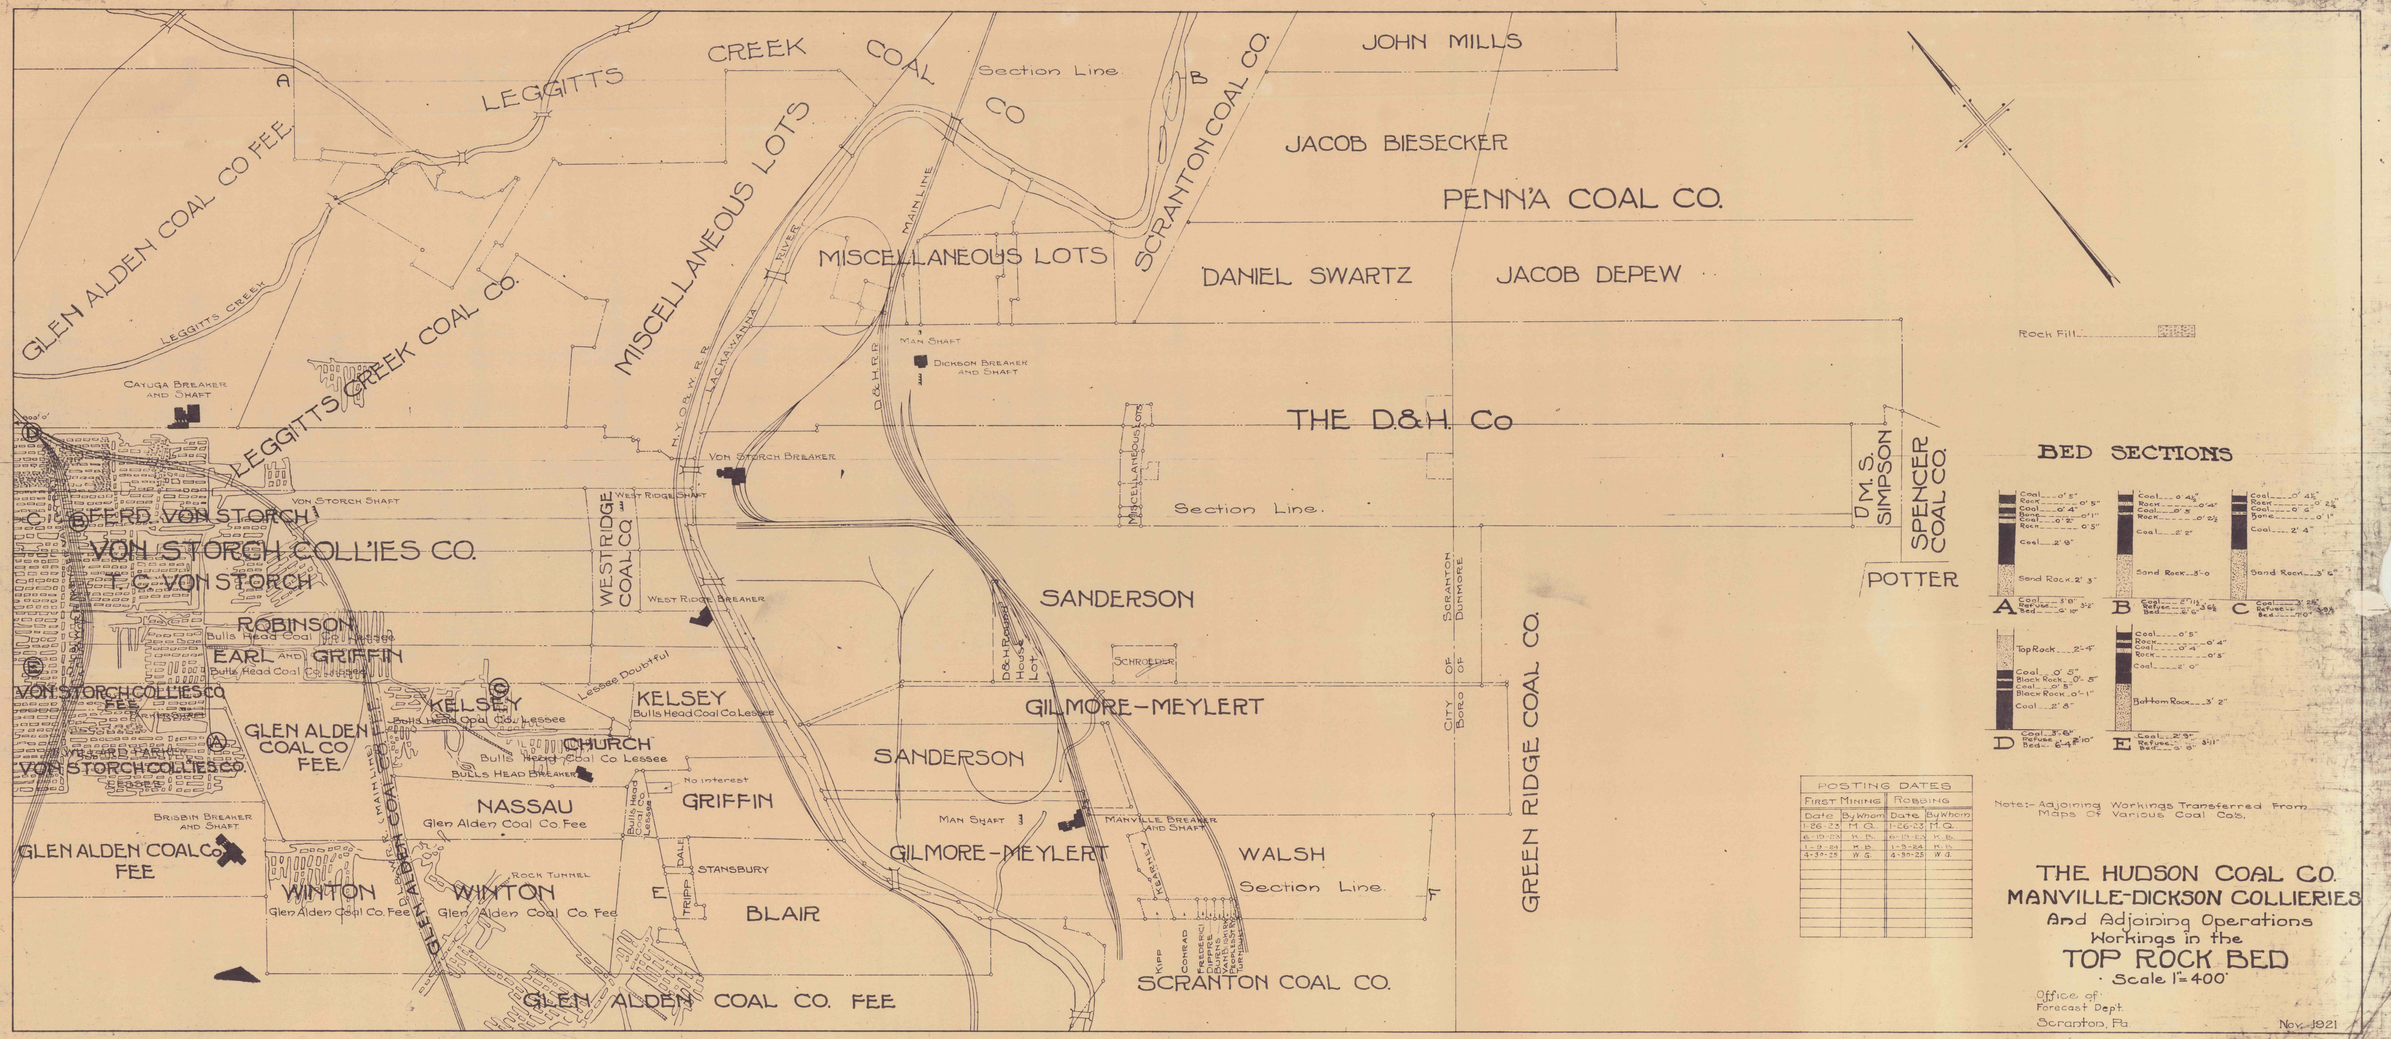
GLEN ALDEN COAL CO FEE
LEGGITTS CREEK COAL CO.
LEGGITTS CREEK
MISCELLANEOUS LOTS
Section Line
SCRANTON COAL CO.
JOHN MILLS
JACOB BIESECKER
PENN'A COAL CO.
DANIEL SWARTZ
JACOB DEPEW
MISCELLANEOUS LOTS
MAIN LINE
D.&H.R.R.
N.Y.O.&W.R.R.
LACKAWANNA RIVER
MAN SHAFT
DICKSON BREAKER AND SHAFT
THE D.&H. Co
Section Line
CAYUGA BREAKER AND SHAFT
VON STORCH BREAKER
VON STORCH SHAFT
C.C. & F.R.D. VON STORCH
VON STORCH COL'IES CO.
T.C. VON STORCH
WESTRIDGE COAL CO.
WEST RIDGE SHAFT
WEST RIDGE BREAKER
ROBINSON
Bulls Head Coal Co Lessee
EARL AND GRIFFIN
Bulls Head Coal Co Lessee
VON STORCH COL'IES CO FEE
VON STORCH COL'IES CO.
GLEN ALDEN COAL CO FEE
KELSEY
Bulls Head Coal Co. Lessee
Lessee Doubtful
KELSEY
Bulls Head Coal Co Lessee
CHURCH
Bulls Head Coal Co Lessee
BULLS HEAD BREAKER
NASSAU
Glen Alden Coal Co. Fee
No interest
GRIFFIN
Bulls Head Coal Co Lessee
BRISBIN BREAKER AND SHAFT
GLEN ALDEN COAL CO FEE
WINTON
Glen Alden Coal Co. Fee
WINTON
Glen Alden Coal Co Fee
ROCK TUNNEL
STANSBURY
DALE
TRIPP
BLAIR
GLEN ALDEN COAL CO. FEE
SANDERSON
D.&H. Roads Hook Lot
SCHROEDER
GILMORE-MEYLERT
SANDERSON
MAN SHAFT
MANVILLE BREAKER AND SHAFT
GILMORE-MEYLERT
WALSH
Section Line
SCRANTON COAL CO.
KIPP
CONRAD
FREDERICK
DIPPRE
WATSON
VAN HORNE
TURPIN
SCRANTON DUNMORE
CITY OF BOR.O
GREEN RIDGE COAL CO.
D.M.S. SIMPSON
SPENCER COAL CO.
POTTER
Rock Fill
BED SECTIONS
A
B
C
D
E
POSTING DATES
First Mining
Robbing
Note:- Adjoining Workings Transferred From Maps Of Various Coal Cos.
THE HUDSON COAL CO.
MANVILLE-DICKSON COLLIERIES
And Adjoining Operations
Workings in the
TOP ROCK BED
Scale 1"=400'
Office of Forecast Dept.
Scranton, Pa.
Nov. 1921