
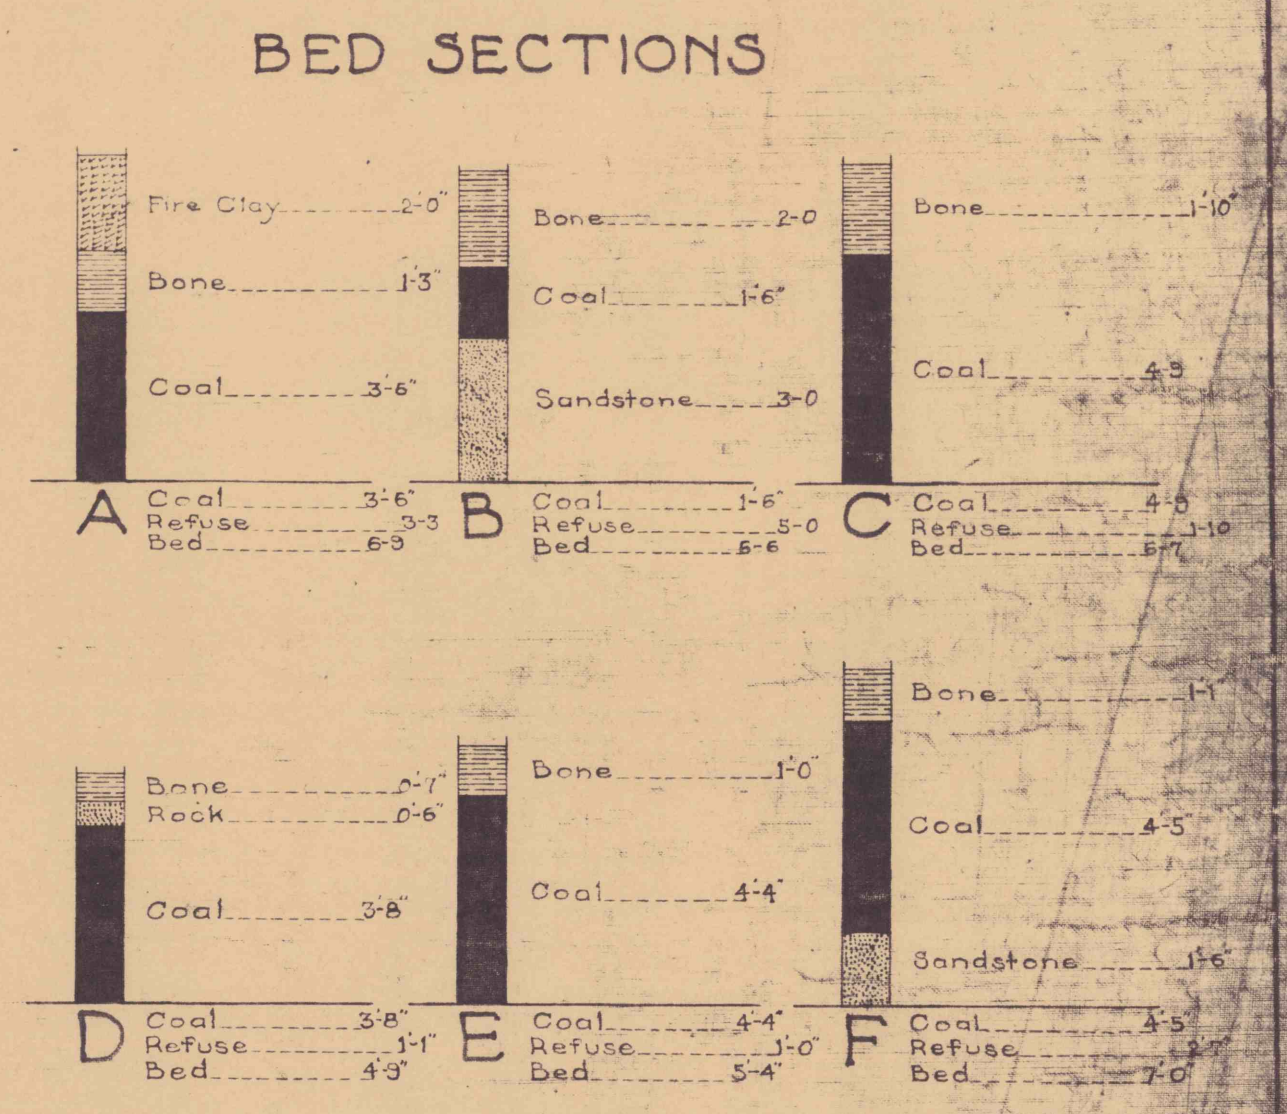


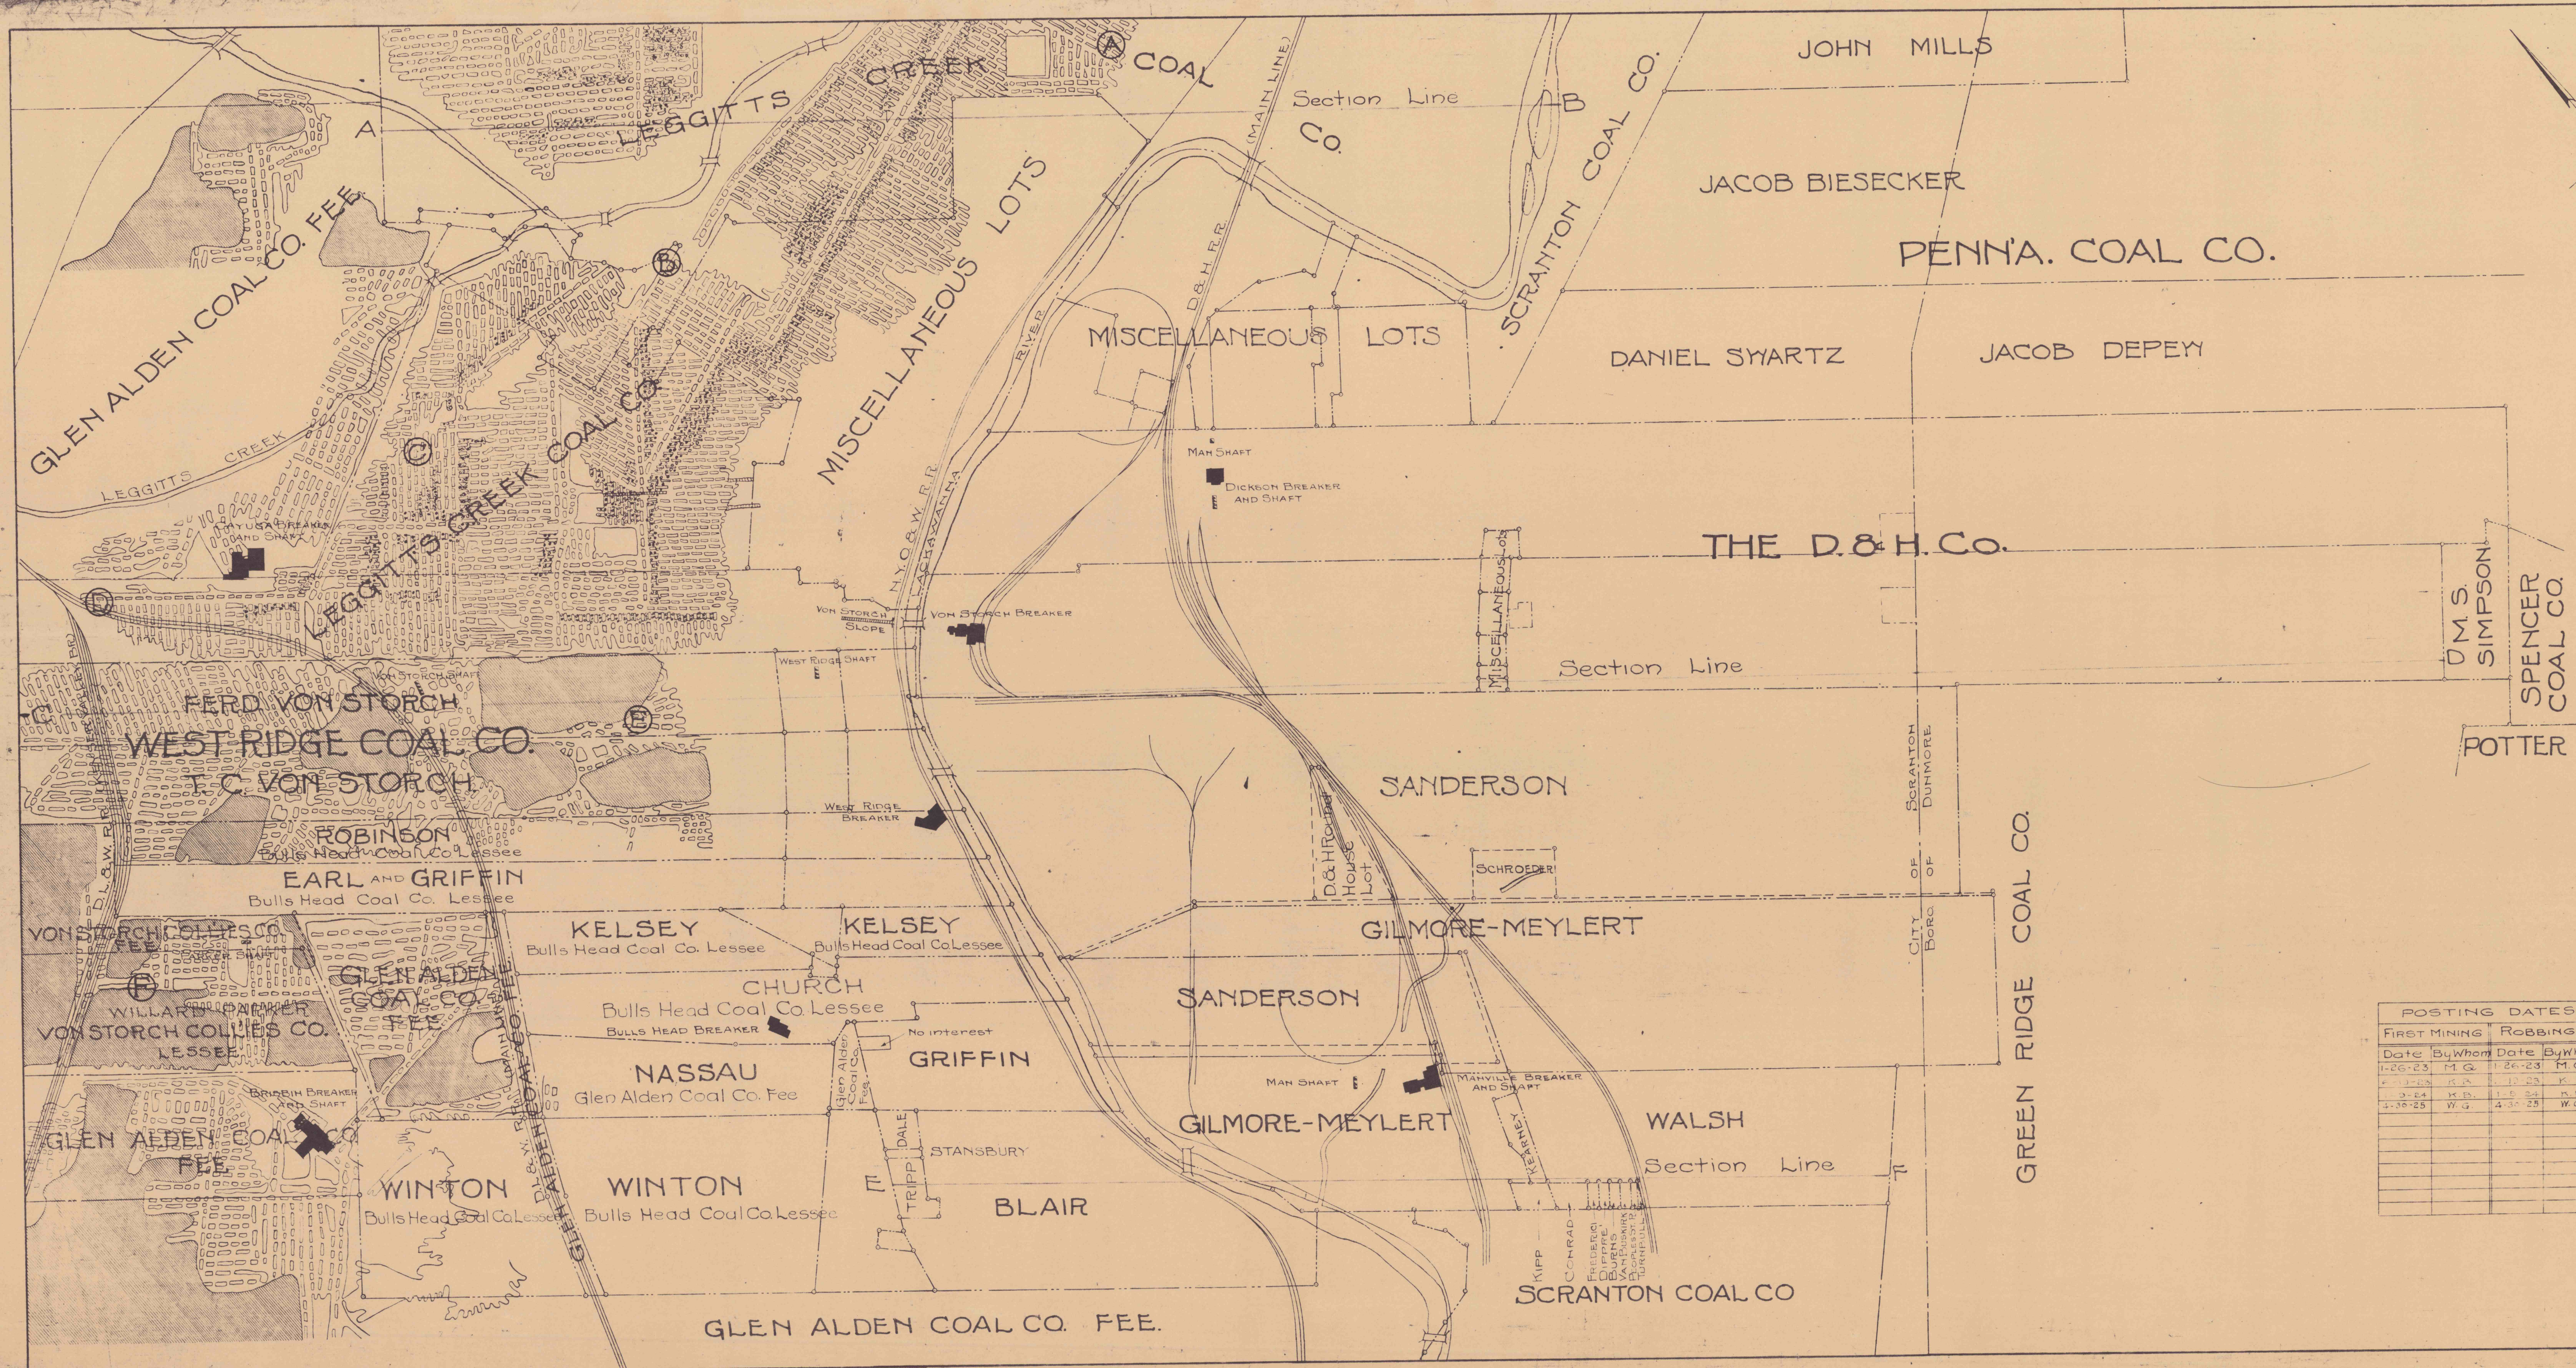

POSTING DATES

FIRST MINING		ROBBING	
Date	By Whom	Date	By Whom
1-26-23	H. G.	1-26-23	H. G.
2-10-23	H. G.	2-23	K. B.
3-24	K. B.	1-5	H. G.
1-25-25	W. G.	4-30	W. G.

Note: Adjoining Workings Transferred From Maps Of Various Coal Co's.

**THE HUDSON COAL CO.
MANVILLE-DICKSON COLLIERIES**
And Adjoining Operations
Workings in the
5 FOOT BED
Scale 1" = 400'

Office of
Forecast Dept.
Scranton, Pa.

Nov. 1924