

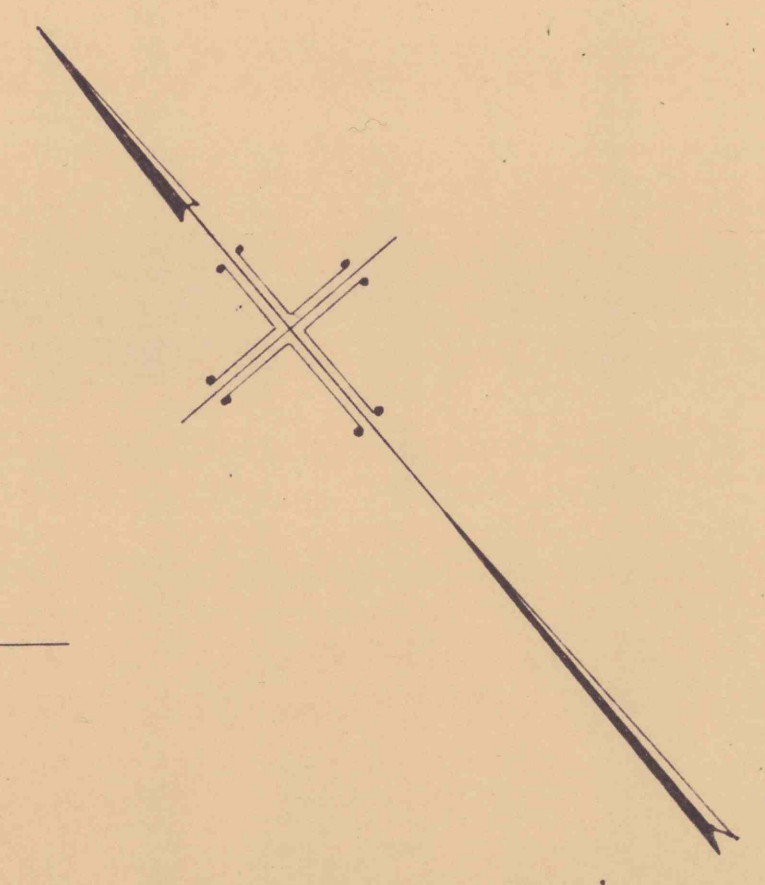


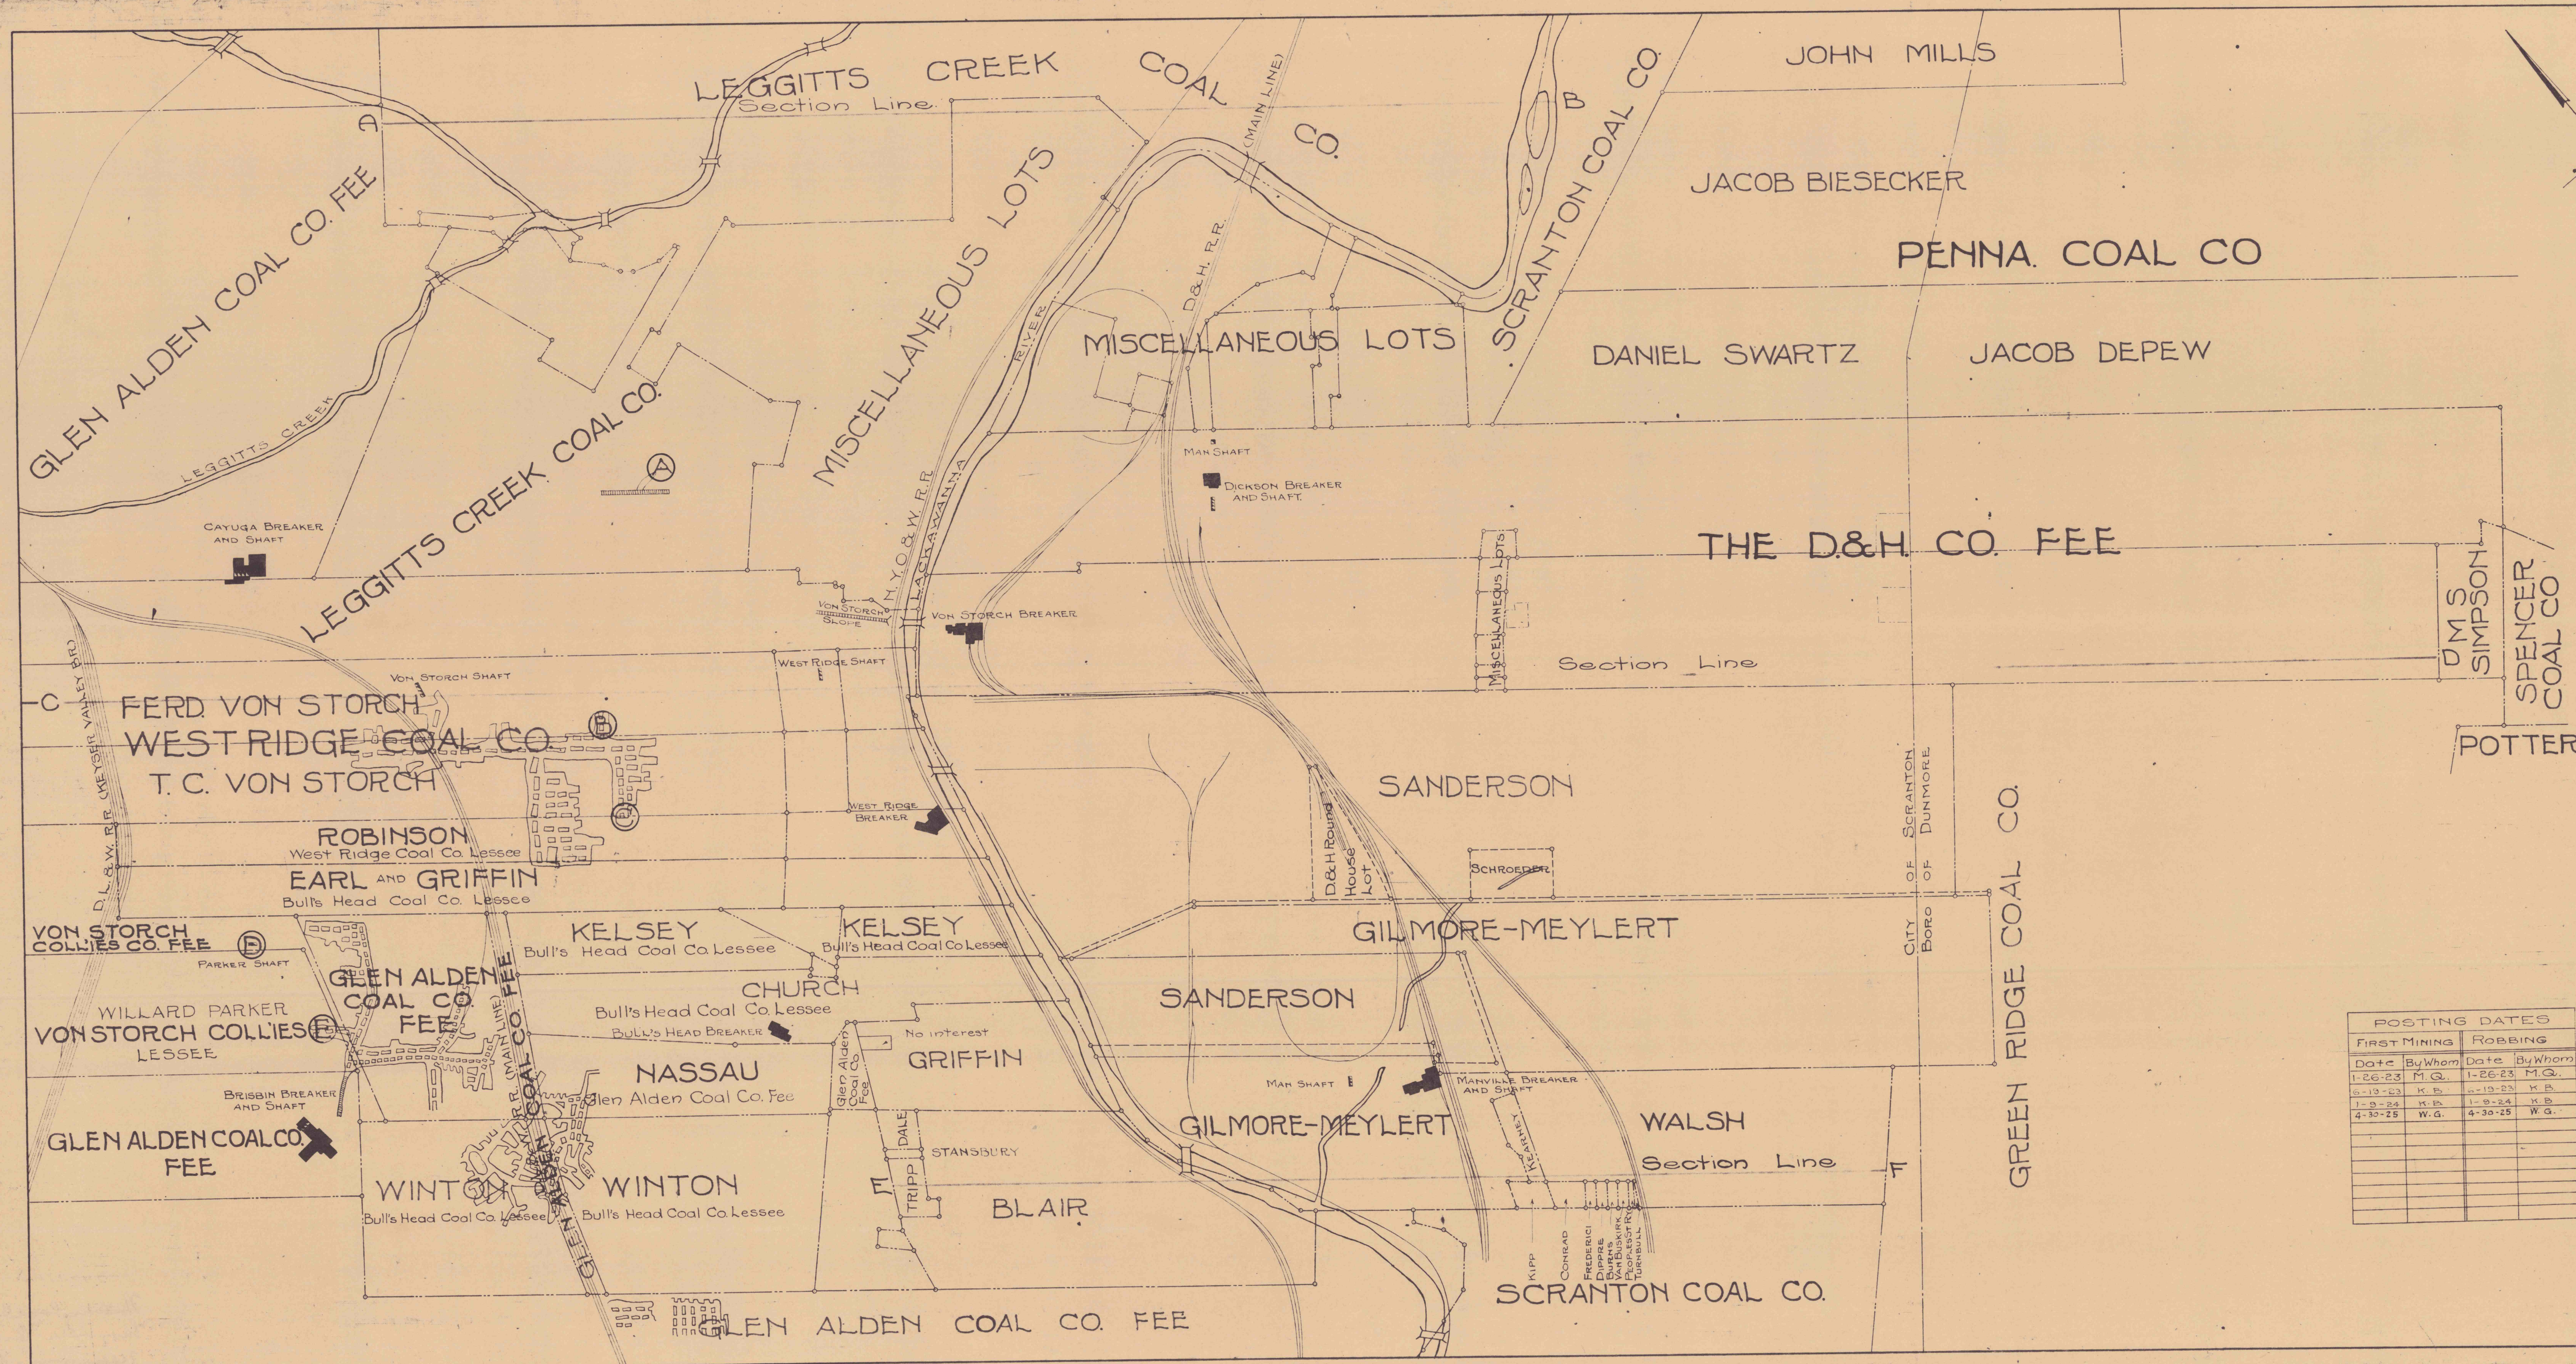

BED SECTIONS

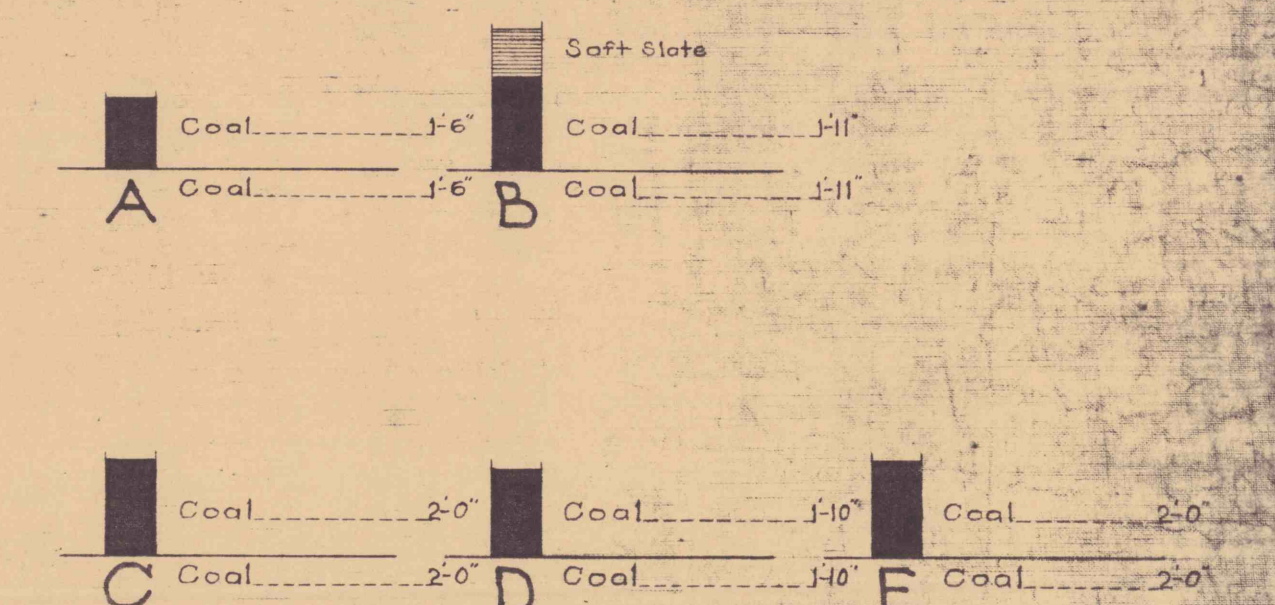

Note: - Adjoining Workings Transferred From Maps Of Various Coal Co's.

POSTING DATES			
FIRST MINING		ROBBING	
Date	By Whom	Date	By Whom
1-26-23	M.G.	1-26-23	M.G.
5-19-23	K.B.	5-19-23	K.B.
1-9-24	K.B.	1-9-24	K.B.
4-30-25	W.G.	4-30-25	W.G.

THE HUDSON COAL CO.
MANVILLE-DICKSON COLLIERIES
 And Adjoining Operations
 Workings in the
UPPER 4 FOOT BED
 Scale 1"=400'

Office of
 Forecast Dept.
 Scranton, Pa.

Nov. 1921