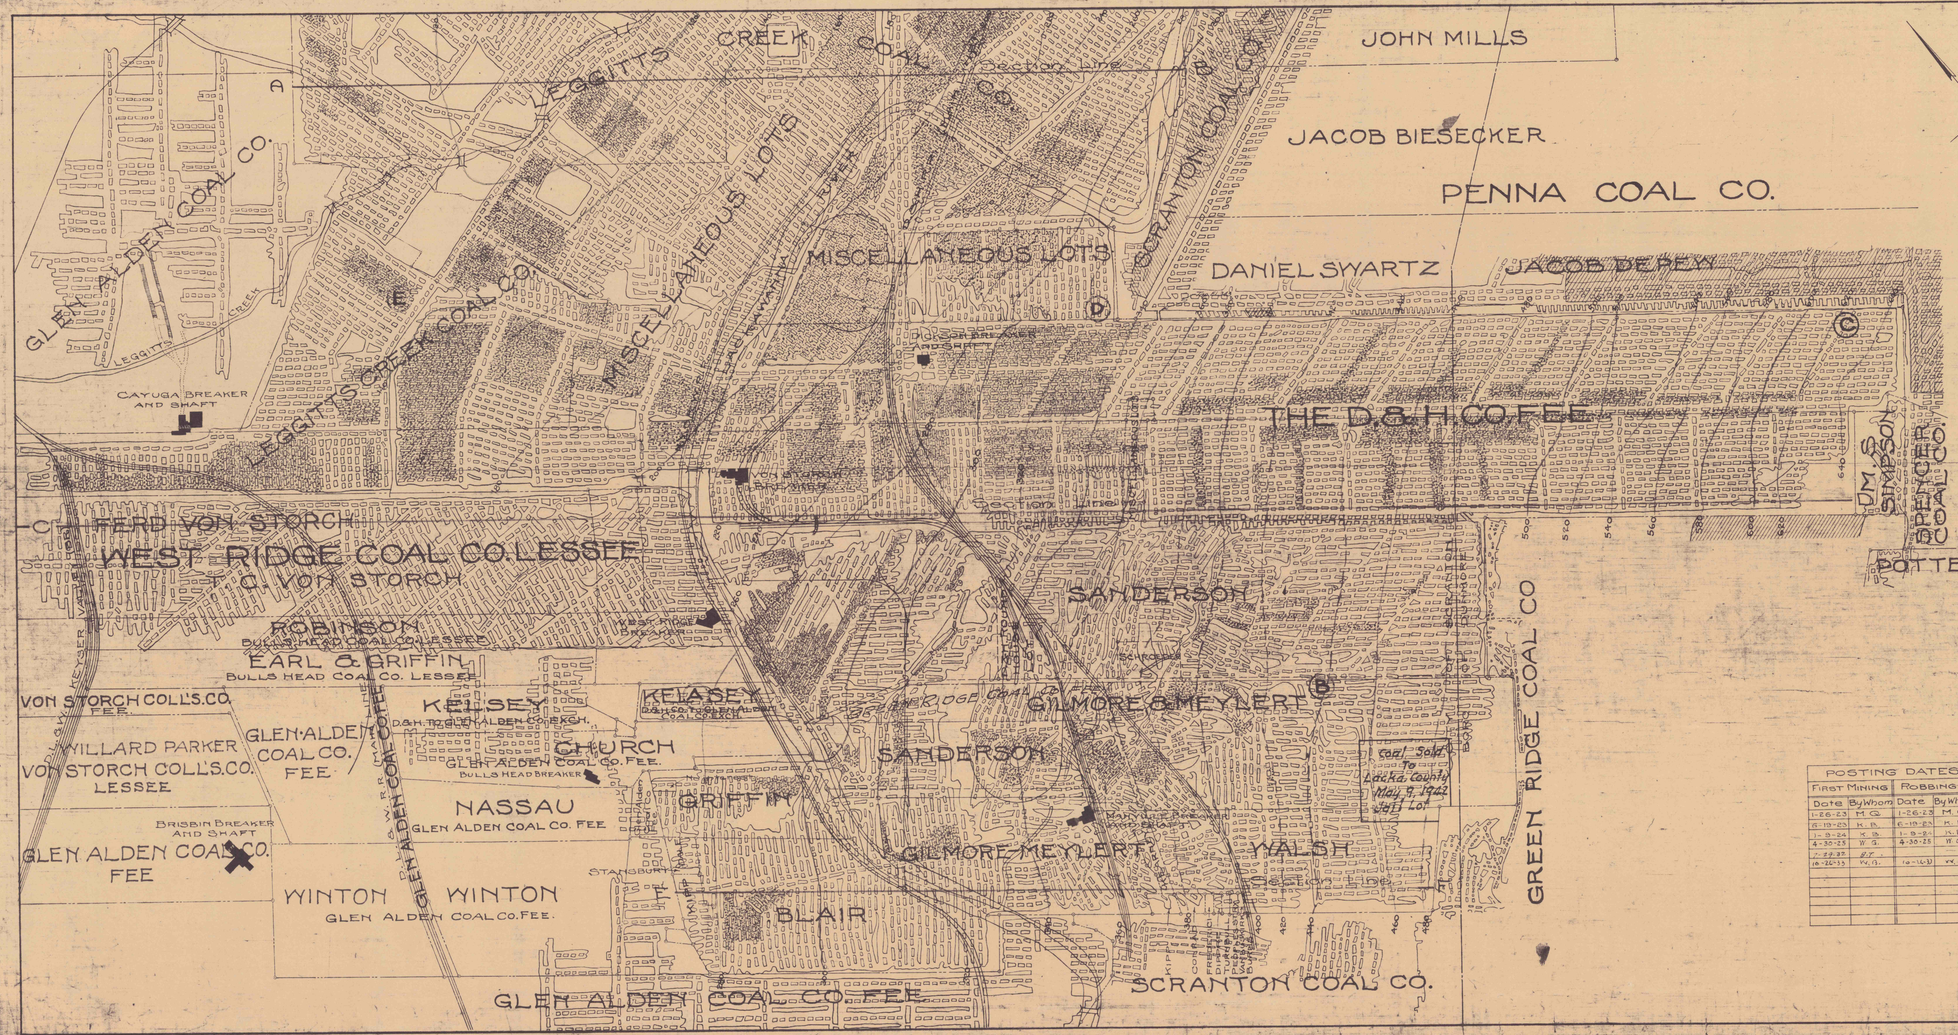

POSTING DATES			
FIRST MINING		ROBBING	
Date	By Whom	Date	By Whom
1-26-23	M.G.	1-26-23	M.G.
6-19-23	H.B.	6-19-23	H.B.
1-9-24	W.B.	1-9-24	H.B.
4-30-25	W.G.	4-30-25	W.G.
1-29-27	B.F.		
10-26-33	W.G.	10-26-33	W.G.