



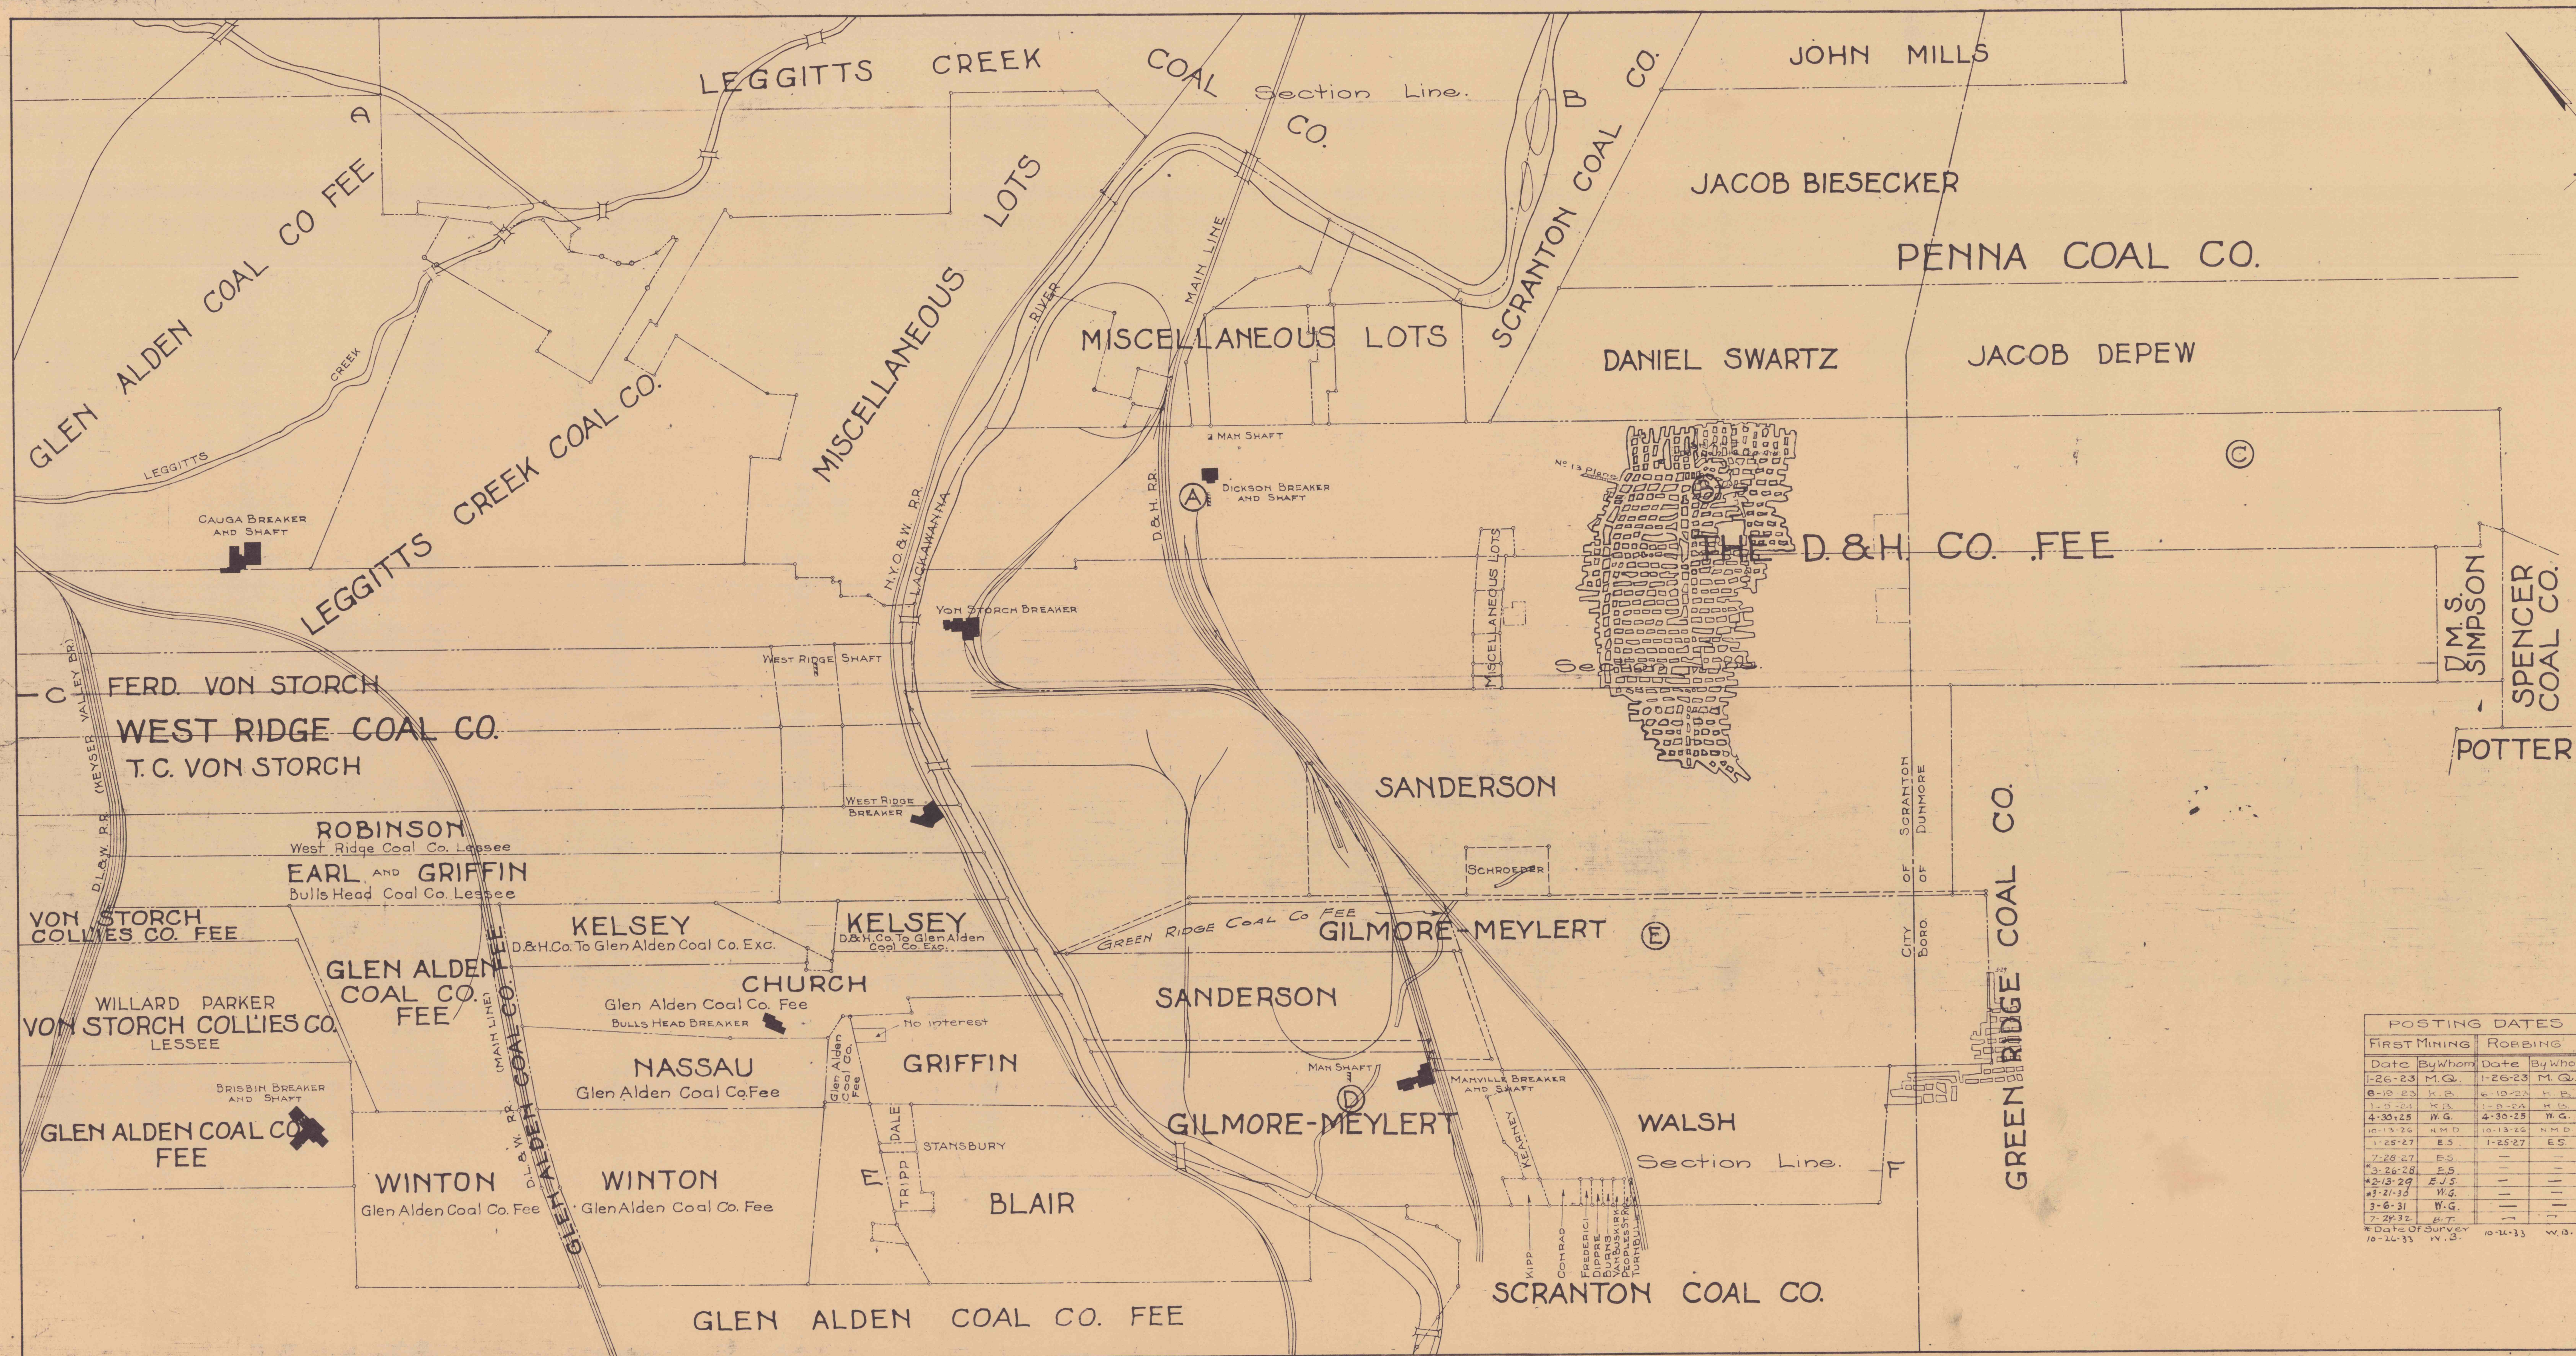

BED SECTIONS

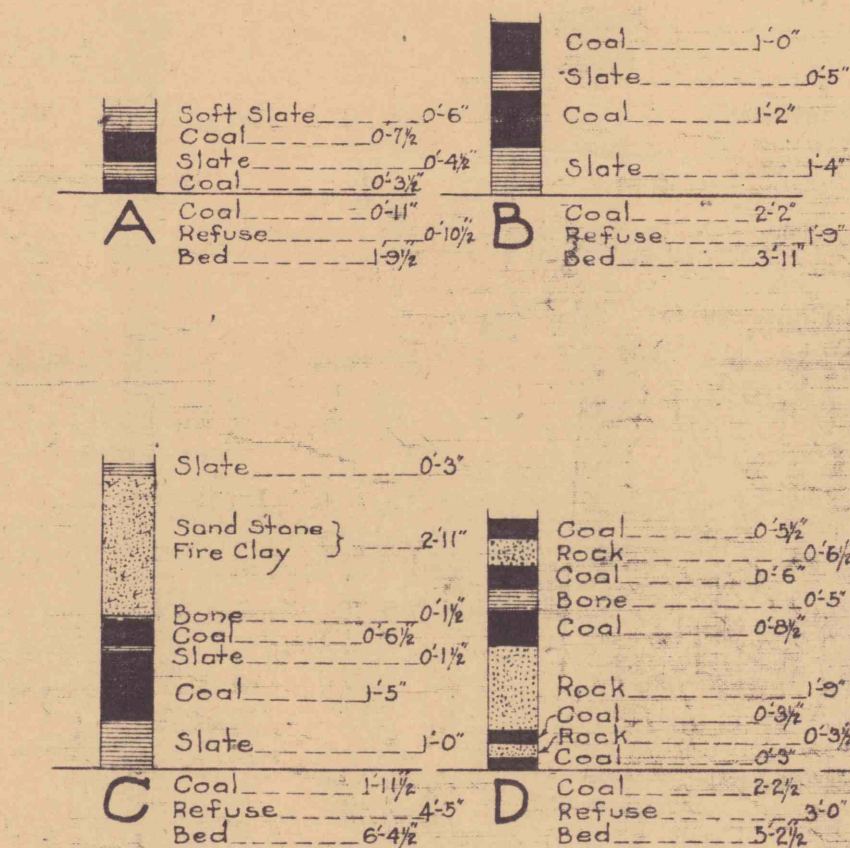

POSTING DATES			
First Mining		Robbing	
Date	By whom	Date	By whom
1-26-23	M.G.	1-26-23	M.G.
6-10-23	K.P.	6-10-23	K.P.
1-10-24	K.P.	1-10-24	K.P.
4-30-25	W.G.	4-30-25	W.G.
10-1-25	N.M.D.	10-1-25	N.M.D.
1-25-27	E.S.	1-25-27	E.S.
7-28-27	E.S.	7-28-27	E.S.
3-26-28	E.S.	3-26-28	E.S.
12-12-29	E.S.	12-12-29	E.S.
3-27-30	W.G.	3-27-30	W.G.
3-6-31	W.G.	3-6-31	W.G.
7-26-32	E.S.	7-26-32	E.S.
* Date of Survey			
10-14-33	W.B.	10-14-33	W.B.

THE HUDSON COAL CO.
MANVILLE-DICKSON COLLIERIES
And Adjoining Operations
Workings in the
No. 1 DUNMORE BED

Office of
Forecast Dept.
Scranton Pa.

Nov. 1921