



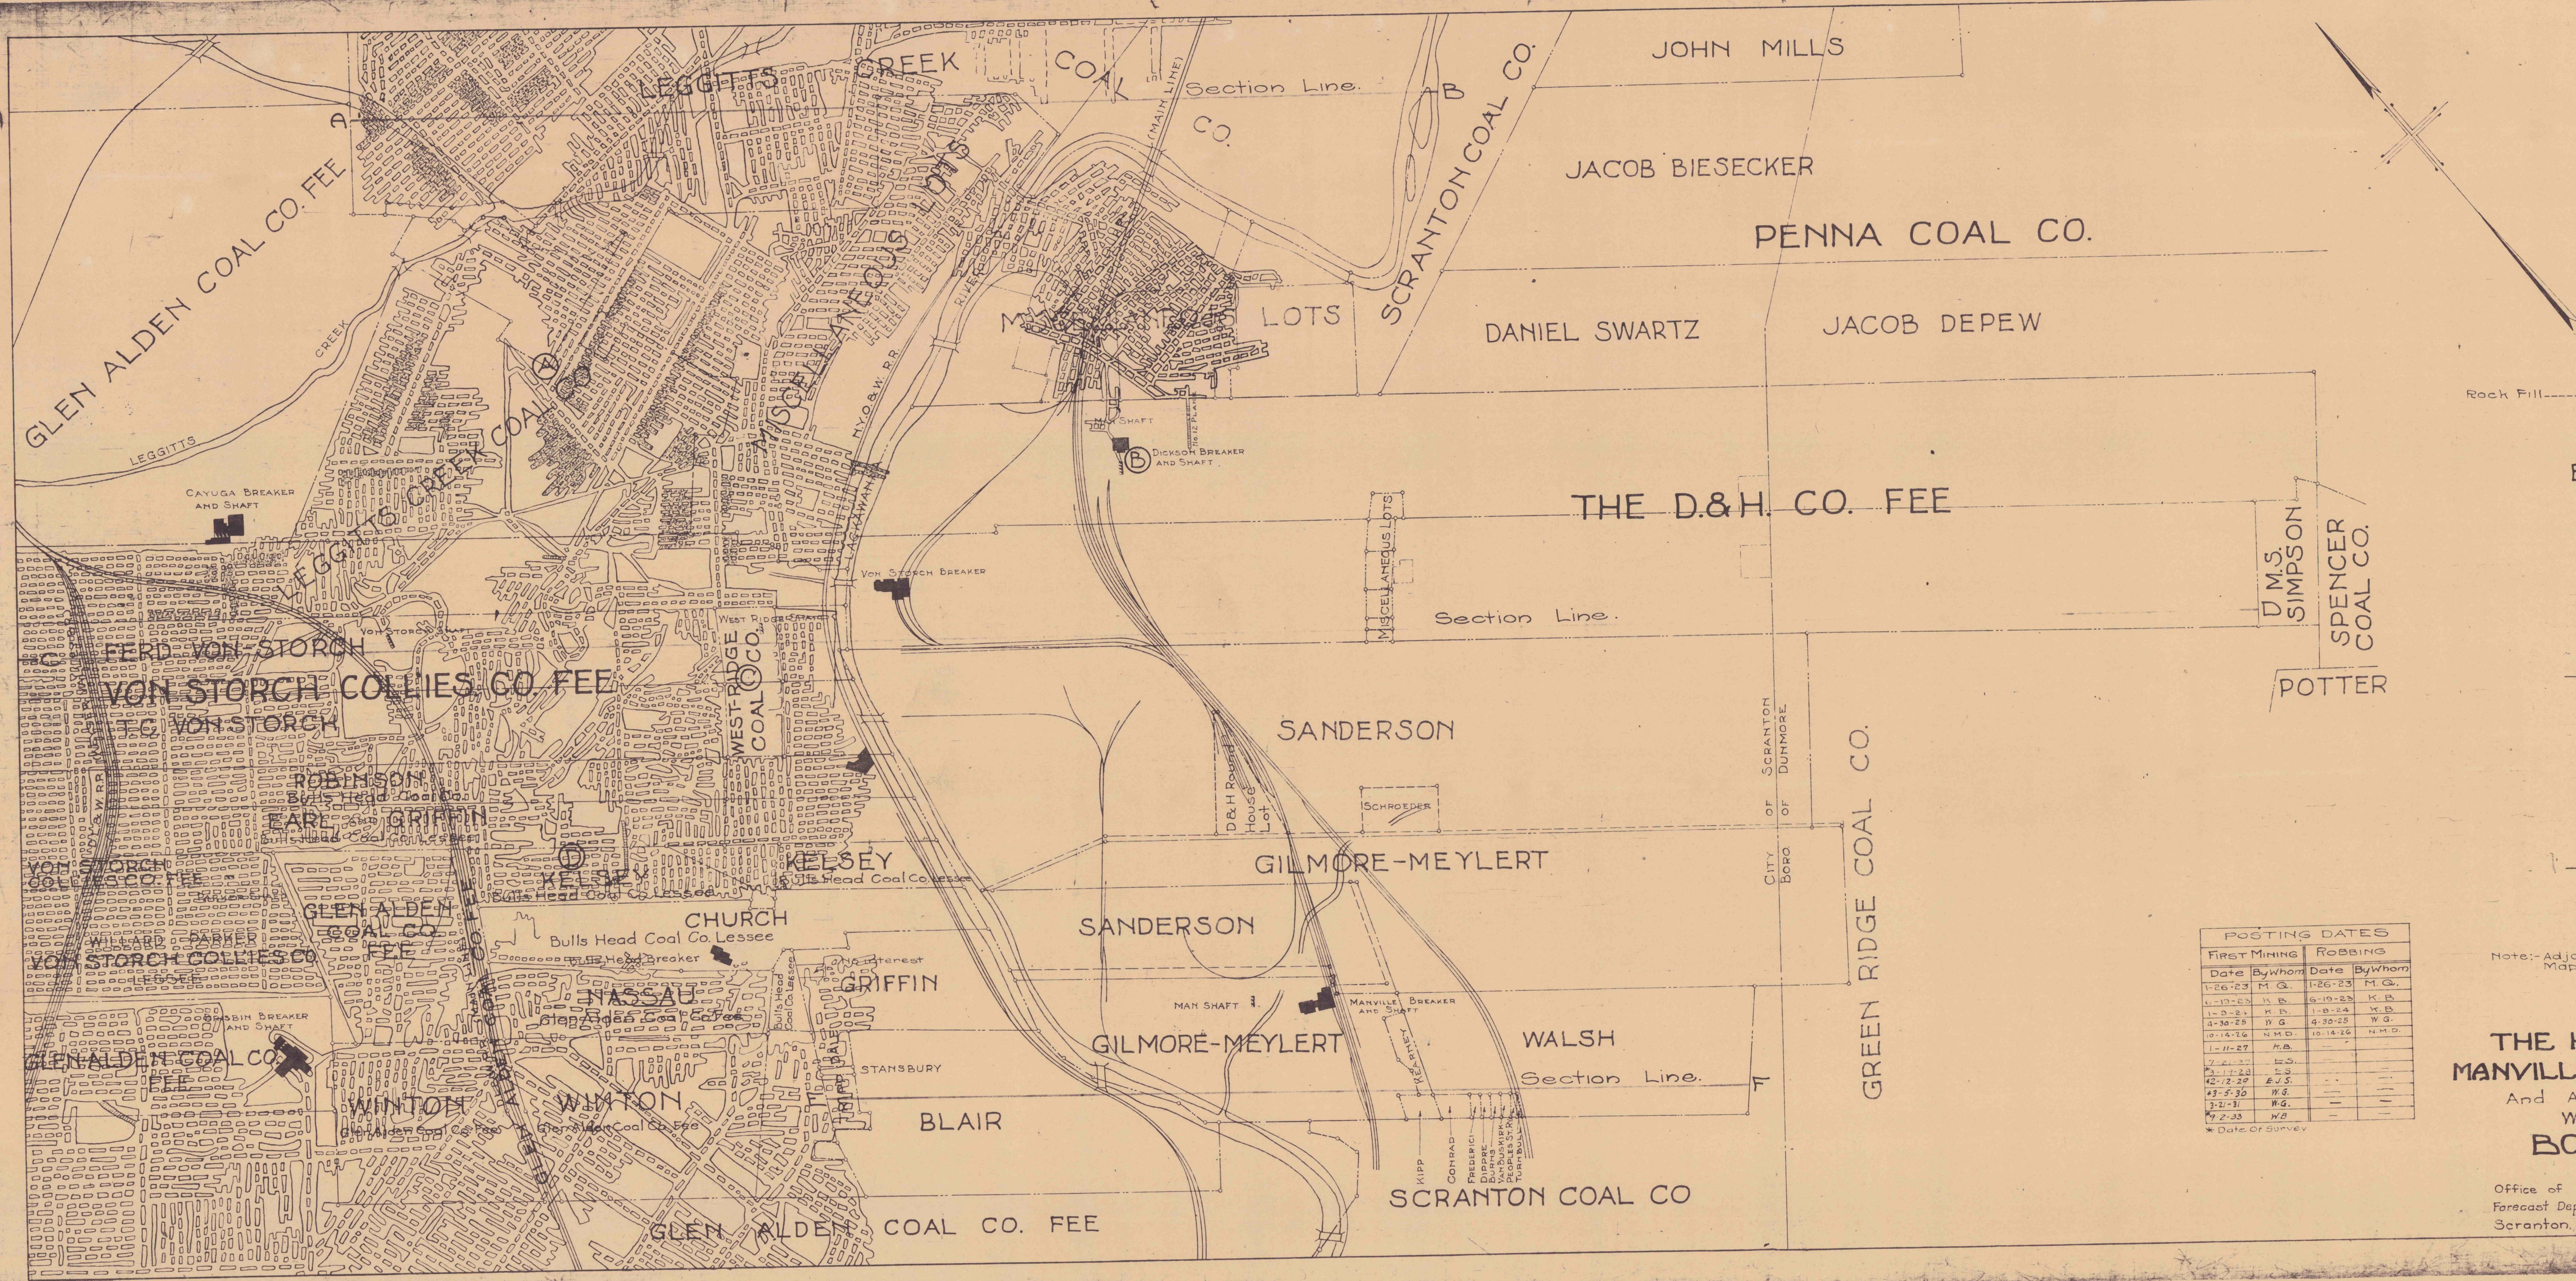

BED SECTIONS

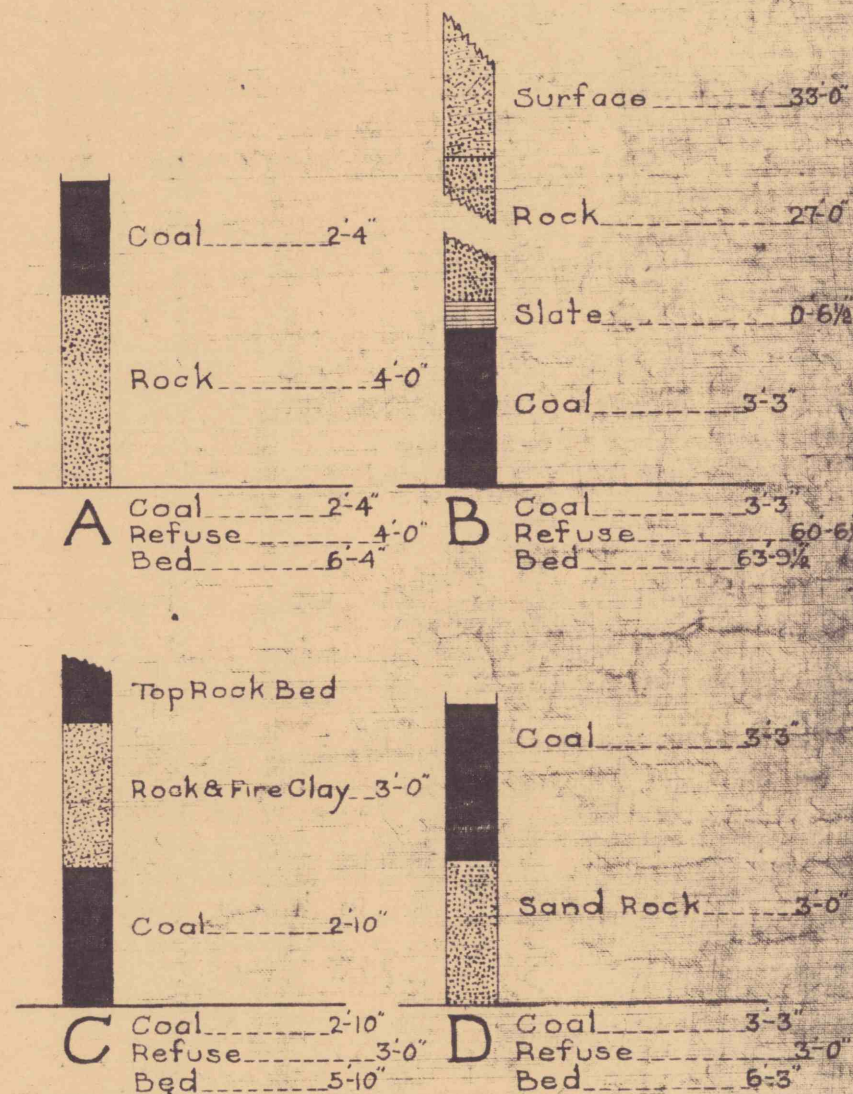

| POSTING DATES |         |          |         |
|---------------|---------|----------|---------|
| FIRST MINING  |         | ROBBING  |         |
| Date          | By Whom | Date     | By Whom |
| 1-26-23       | M.G.    | 1-26-23  | M.G.    |
| 4-10-23       | K.B.    | 6-10-23  | K.B.    |
| 1-5-24        | K.B.    | 1-8-24   | K.B.    |
| 4-30-23       | W.G.    | 4-30-23  | W.G.    |
| 10-14-26      | N.M.D.  | 10-14-26 | N.M.D.  |
| 1-11-27       | K.B.    |          |         |
| 7-2-27        | K.B.    |          |         |
| 12-1-27       | E.U.S.  |          |         |
| 12-1-27       | E.U.S.  |          |         |
| 13-5-30       | W.G.    |          |         |
| 7-2-31        | W.G.    |          |         |
| 7-2-33        | W.B.    |          |         |

Note: Adjoining Workings Transferred From Maps Of Various Coal Co's.

THE HUDSON COAL CO.  
MANVILLE-DICKSON COLLIERIES  
And Adjoining Operations  
Workings in the  
BOTTOM ROCK BED  
Scale 1"=400'

Office of  
Forecast Dept.  
Scranton, Pa.

Nov. 1921