
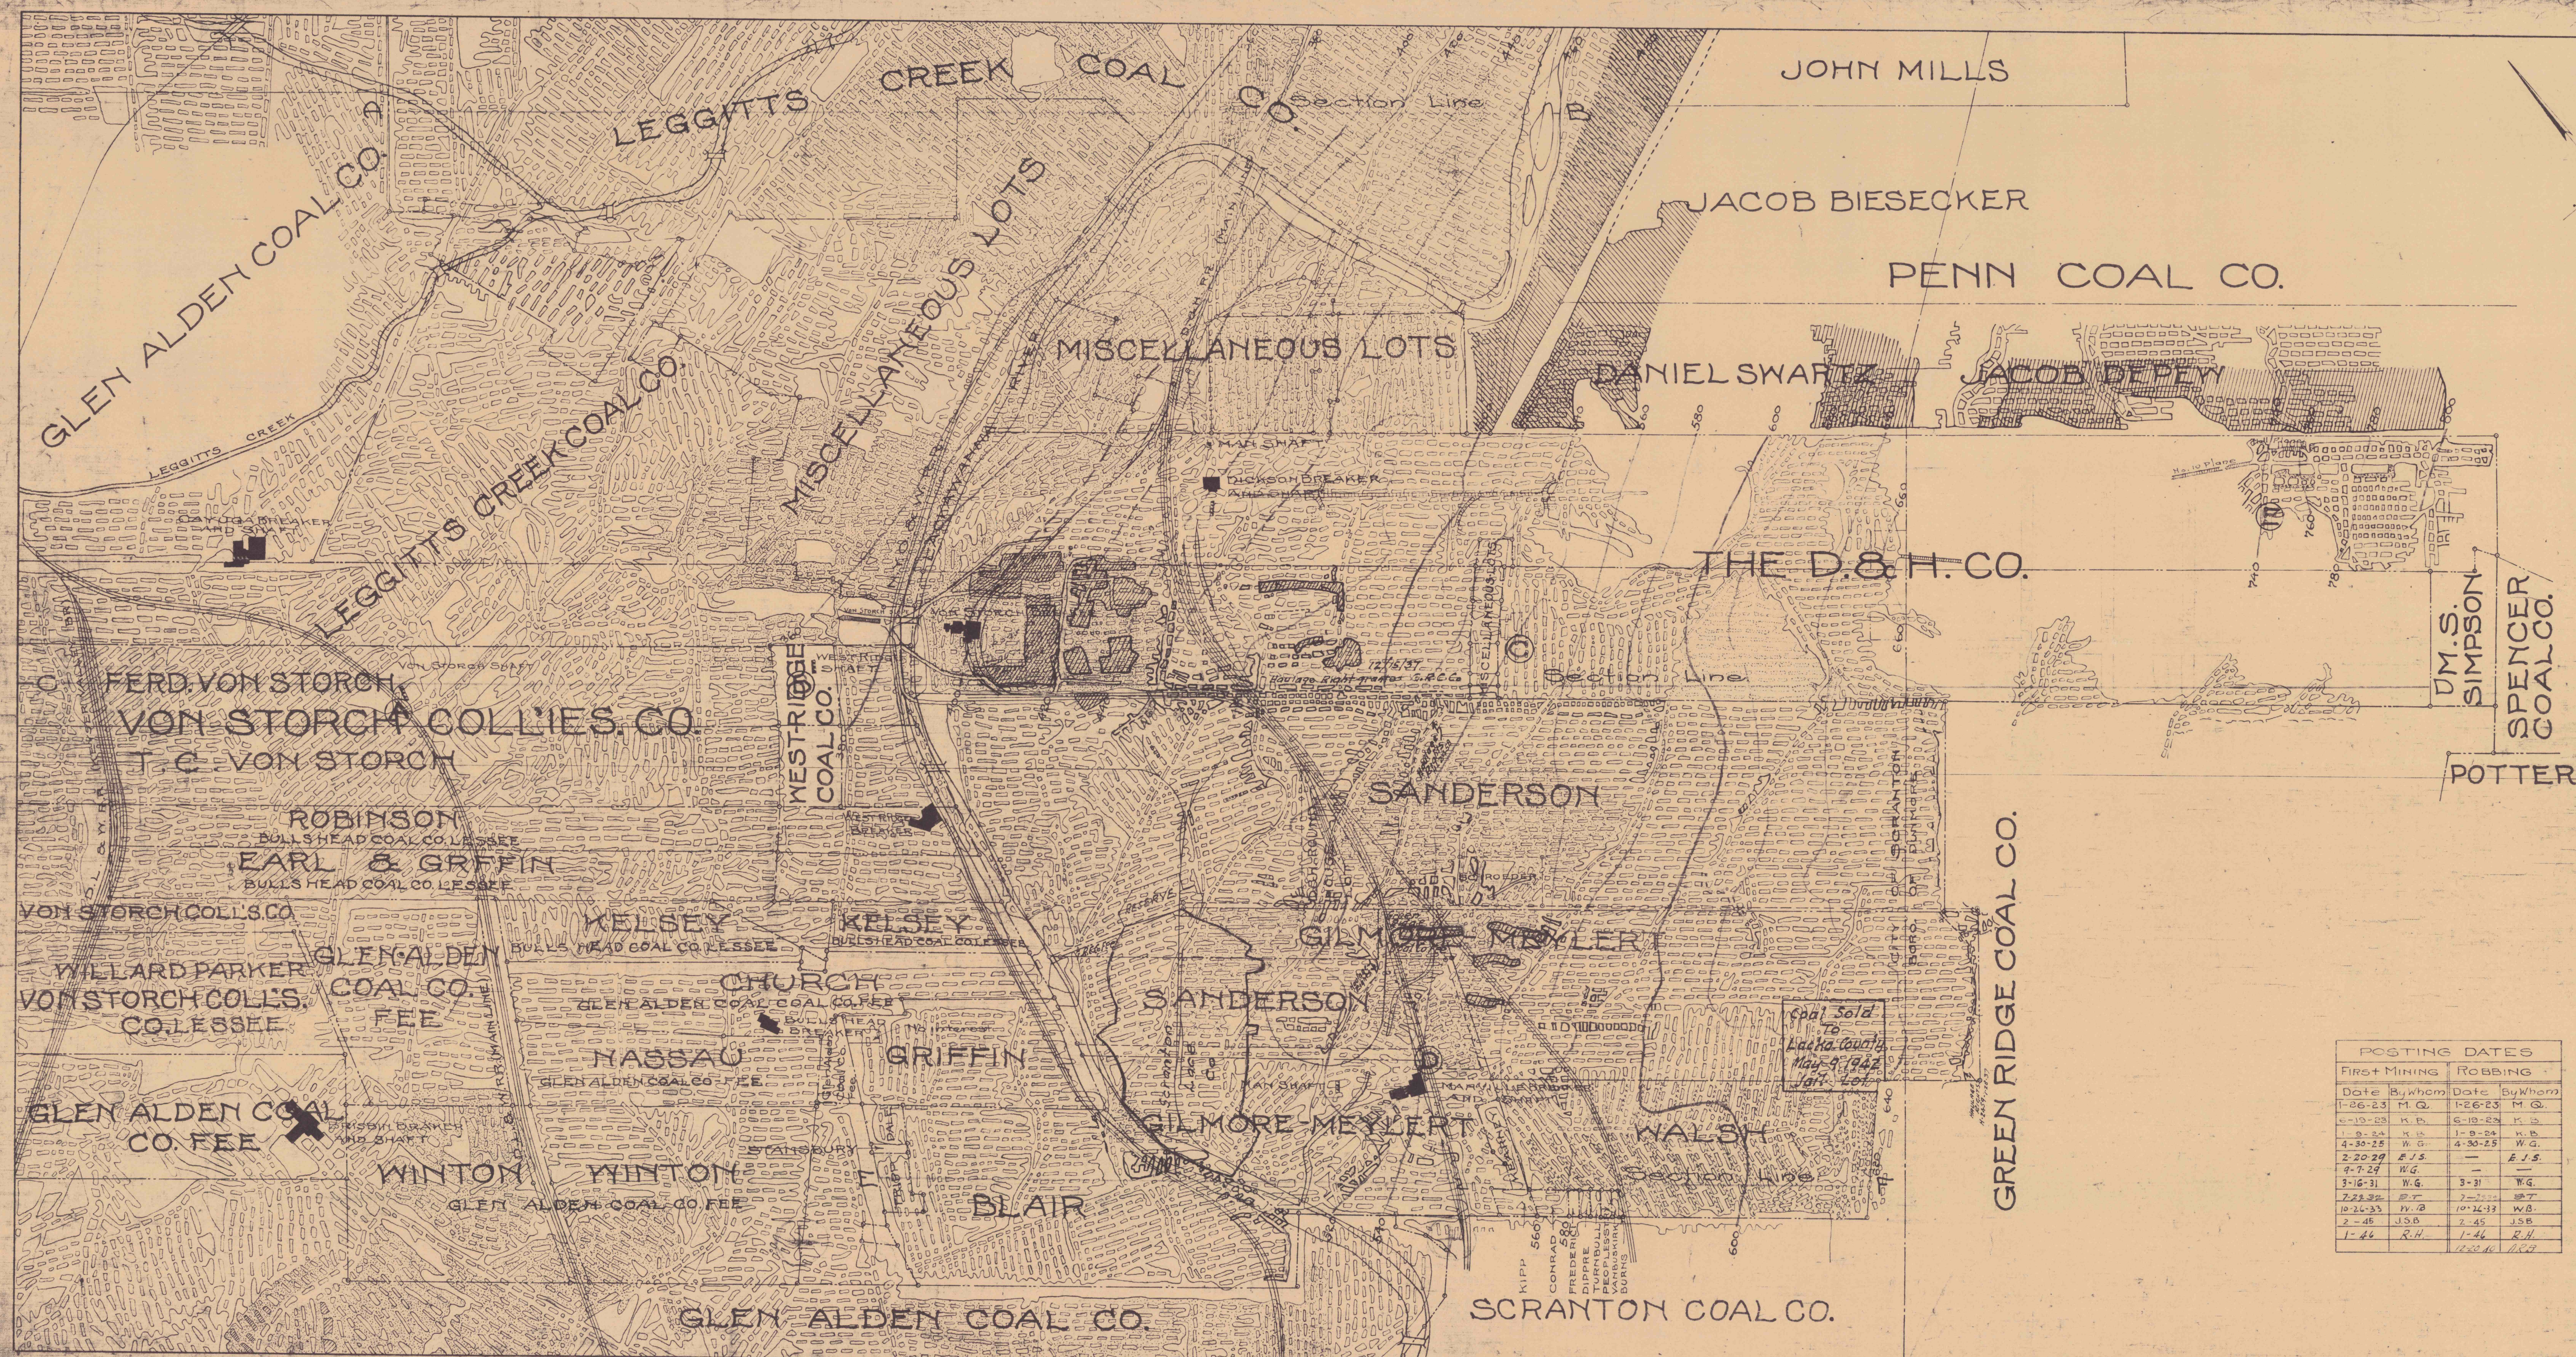


BED SECTIONS

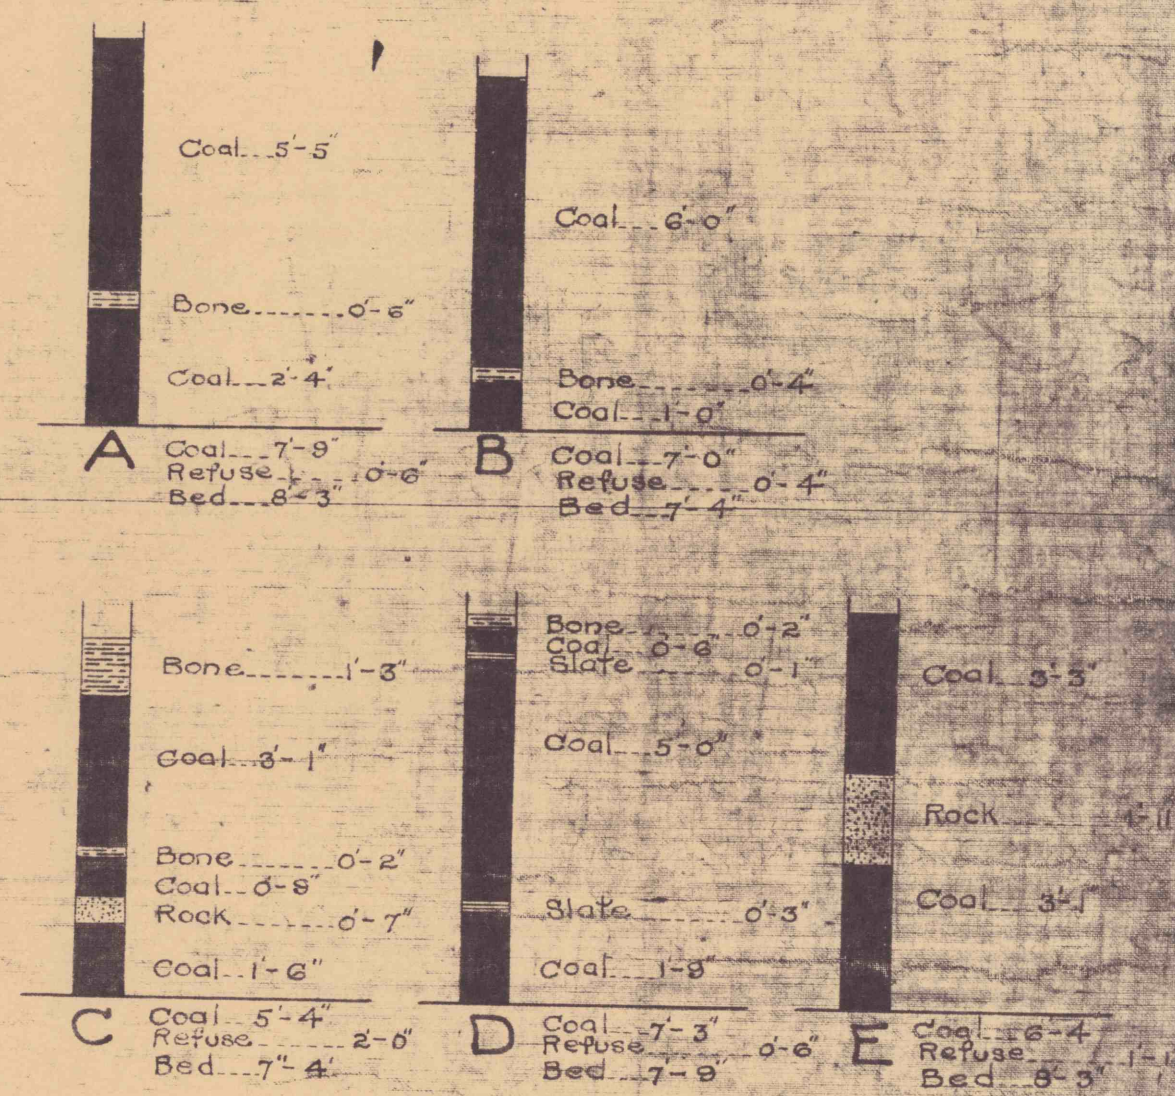

Note: Adjoining Workings Transferred From Maps Of Various Coal Cos.

POSTING DATES			
First Mining		Robbing	
Date	By Whom	Date	By Whom
1-26-23	M. O.	1-26-23	M. O.
2-10-23	K. D.	5-10-23	K. D.
1-8-24	K. D.	1-8-24	K. D.
4-30-25	W. G.	4-30-25	W. G.
2-20-29	R. J. S.	—	R. J. S.
4-7-29	W. G.	—	—
3-16-31	W. G.	3-31	W. G.
7-28-32	W. G.	7-28-32	W. G.
10-24-33	W. B.	10-24-33	W. B.
2-45	W. B.	2-45	W. B.
1-46	R. H.	1-46	R. H.
		10-23-46	W. G.

THE HUDSON COAL CO.
MANVILLE-DICKSON COLLIERIES
 And Adjoining Operations
 Workings in the
CLARK BED
 Scale 1" = 400'

Office of
 Forecast Dept.
 Scranton, Pa.

Nov. 1932