



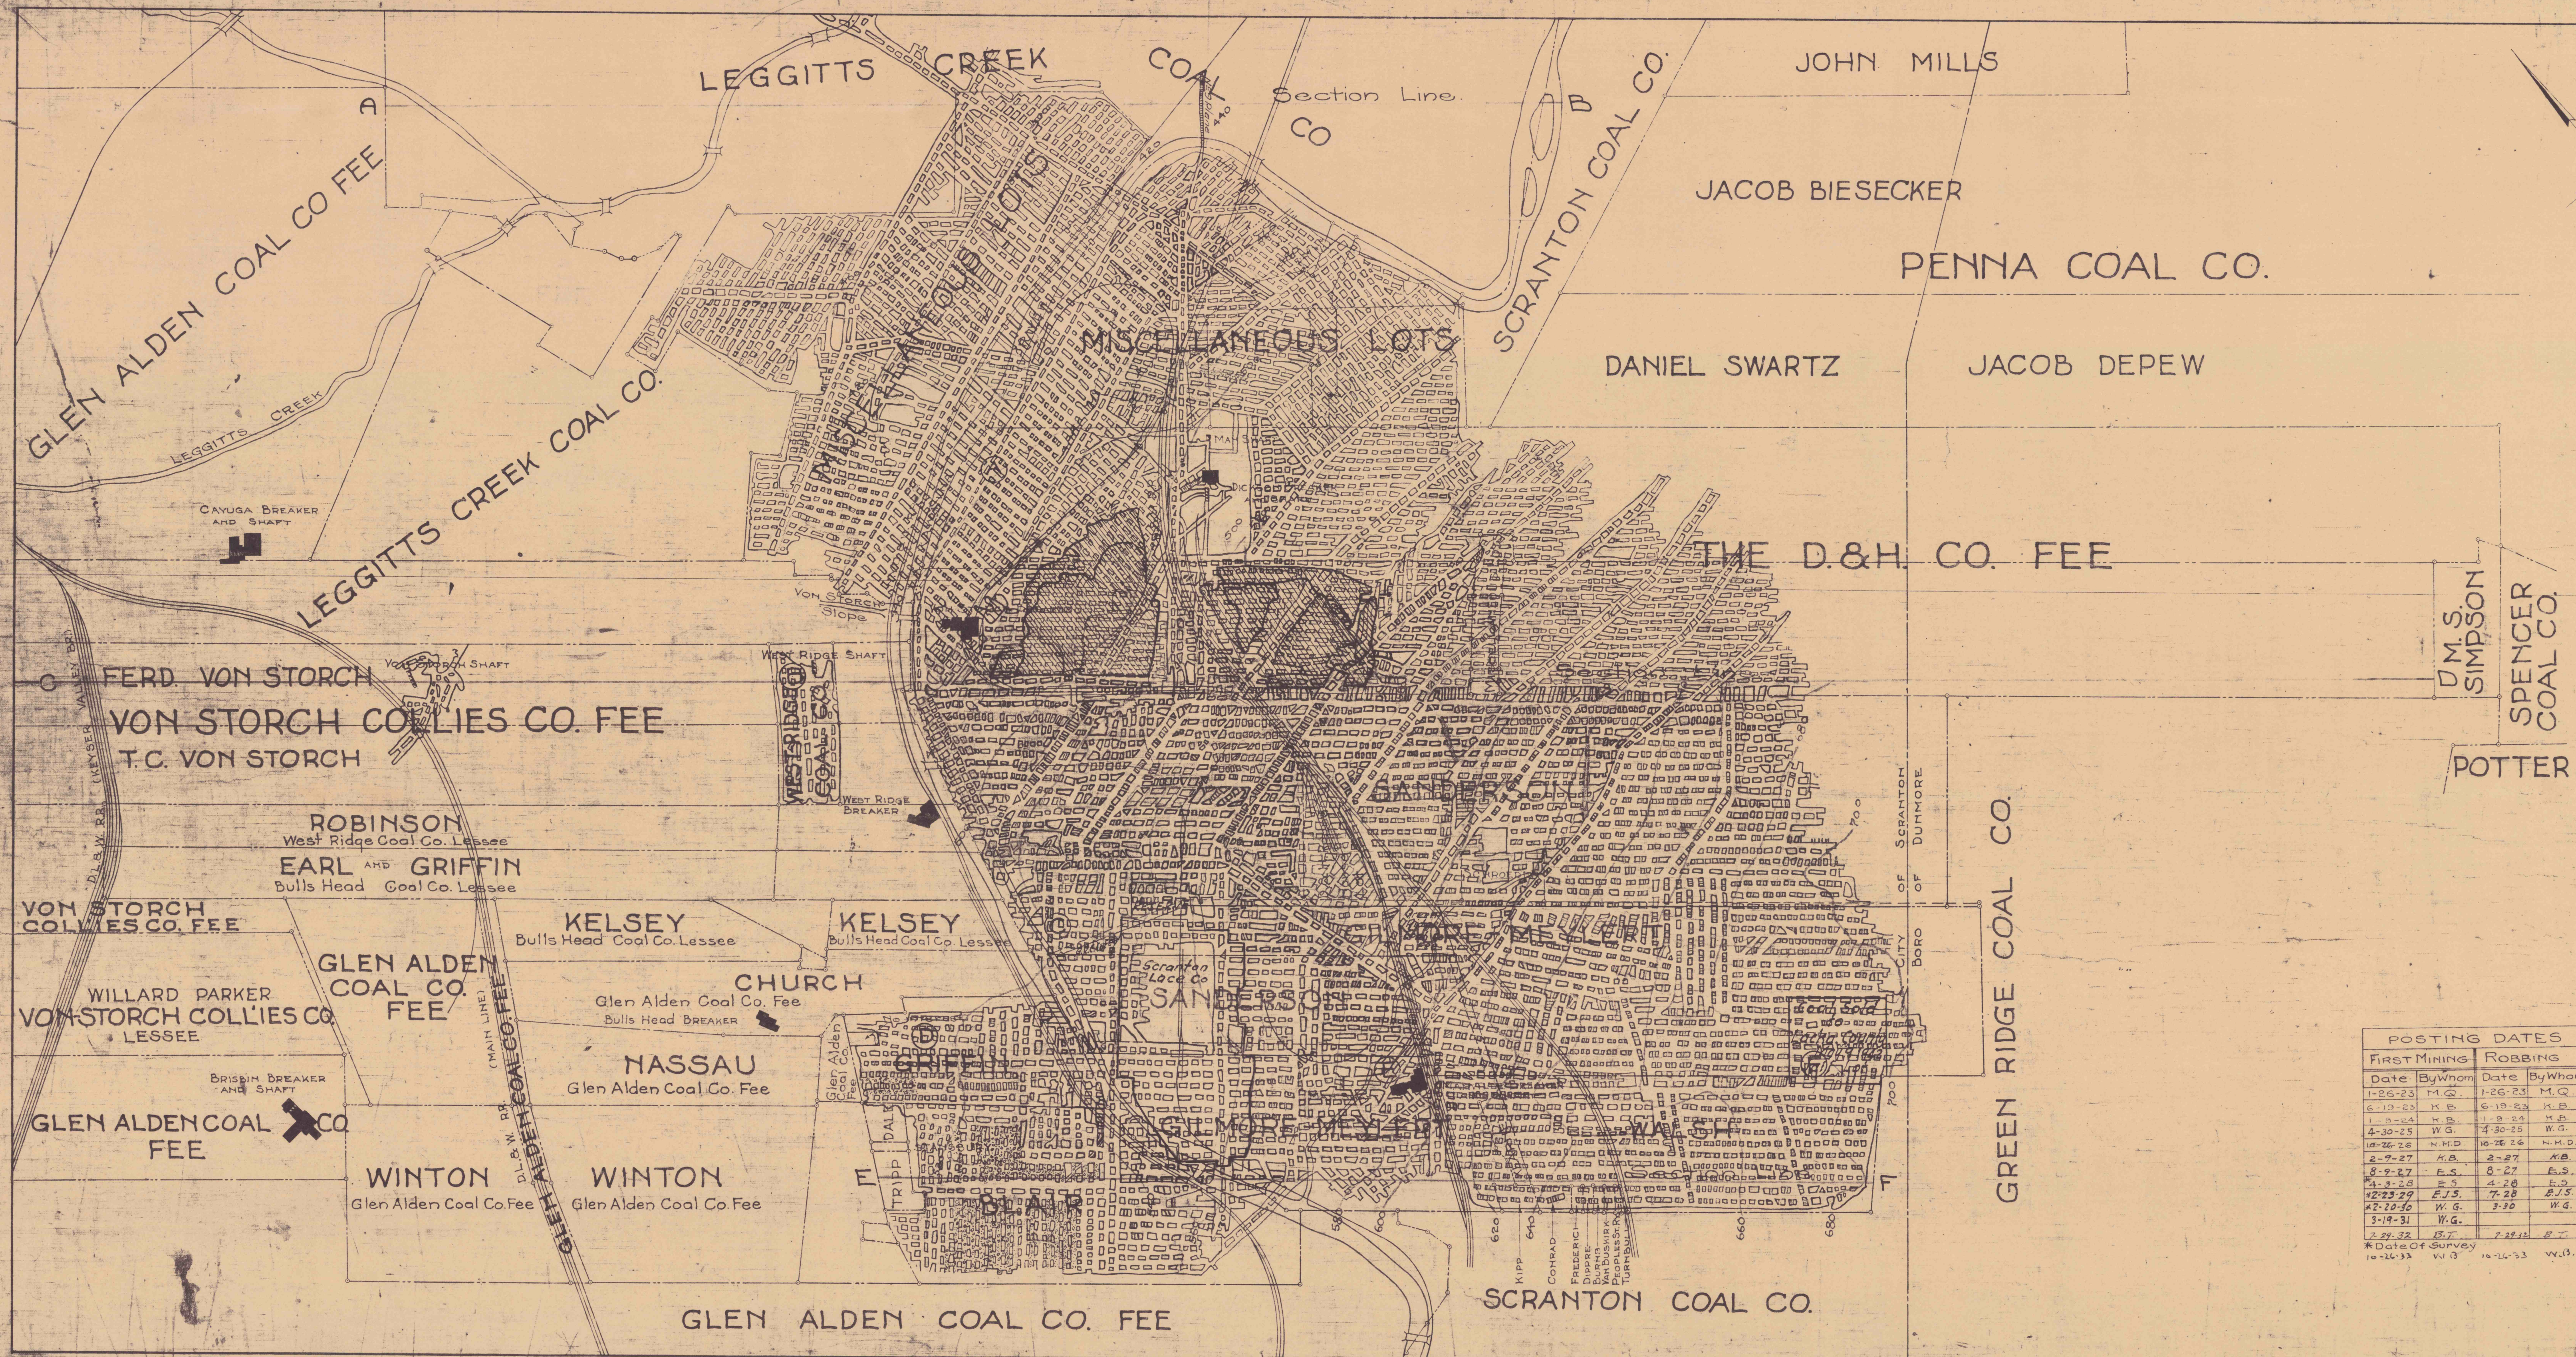

BED SECTIONS

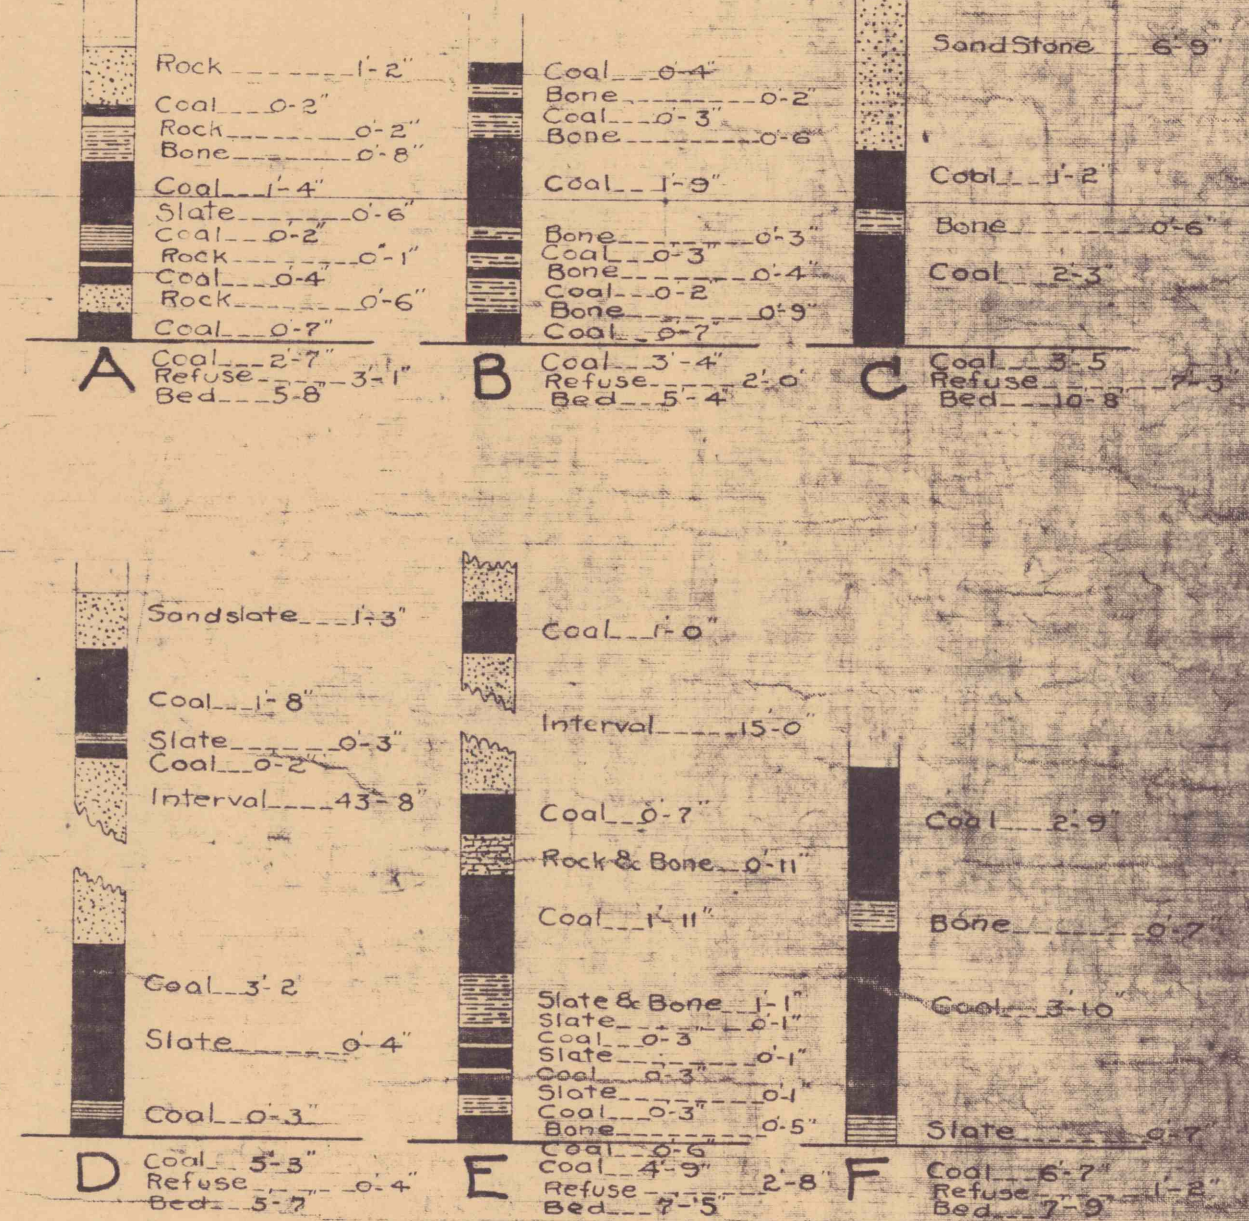

POSTING DATES			
FIRST MINING		ROBBING	
Date	By Whom	Date	By Whom
1-26-23	M.S.	1-26-23	M.Q.
6-19-23	K.B.	6-19-23	K.B.
1-30-24	K.B.	1-30-24	K.B.
4-30-25	W.G.	4-30-25	W.G.
10-26-26	N.H.D.	10-26-26	N.H.D.
2-9-27	K.B.	2-9-27	K.B.
8-9-27	E.S.	8-9-27	E.S.
4-3-28	E.S.	4-3-28	E.S.
12-23-29	E.S.	12-23-29	E.S.
7-12-30	W.G.	7-12-30	W.G.
3-19-31	W.G.	3-19-31	W.G.
2-29-32	B.T.	2-29-32	B.T.
10-16-33	W.B.	10-16-33	W.B.

Note:—Adjoining Workings Transferred From Maps Of Various Coal Cos.

THE HUDSON COAL CO.
MANYVILLE-DICKSON COLLIERIES
 And Adjoining Operations
 Workings in the
NEW COUNTY BED
 Scale 1"=400'

Office of
 Forecast Dept.
 Scranton, Pa.

Nov 1921