


LANCE COLLY
Red Ash Vn.
SHEET - N-1001A

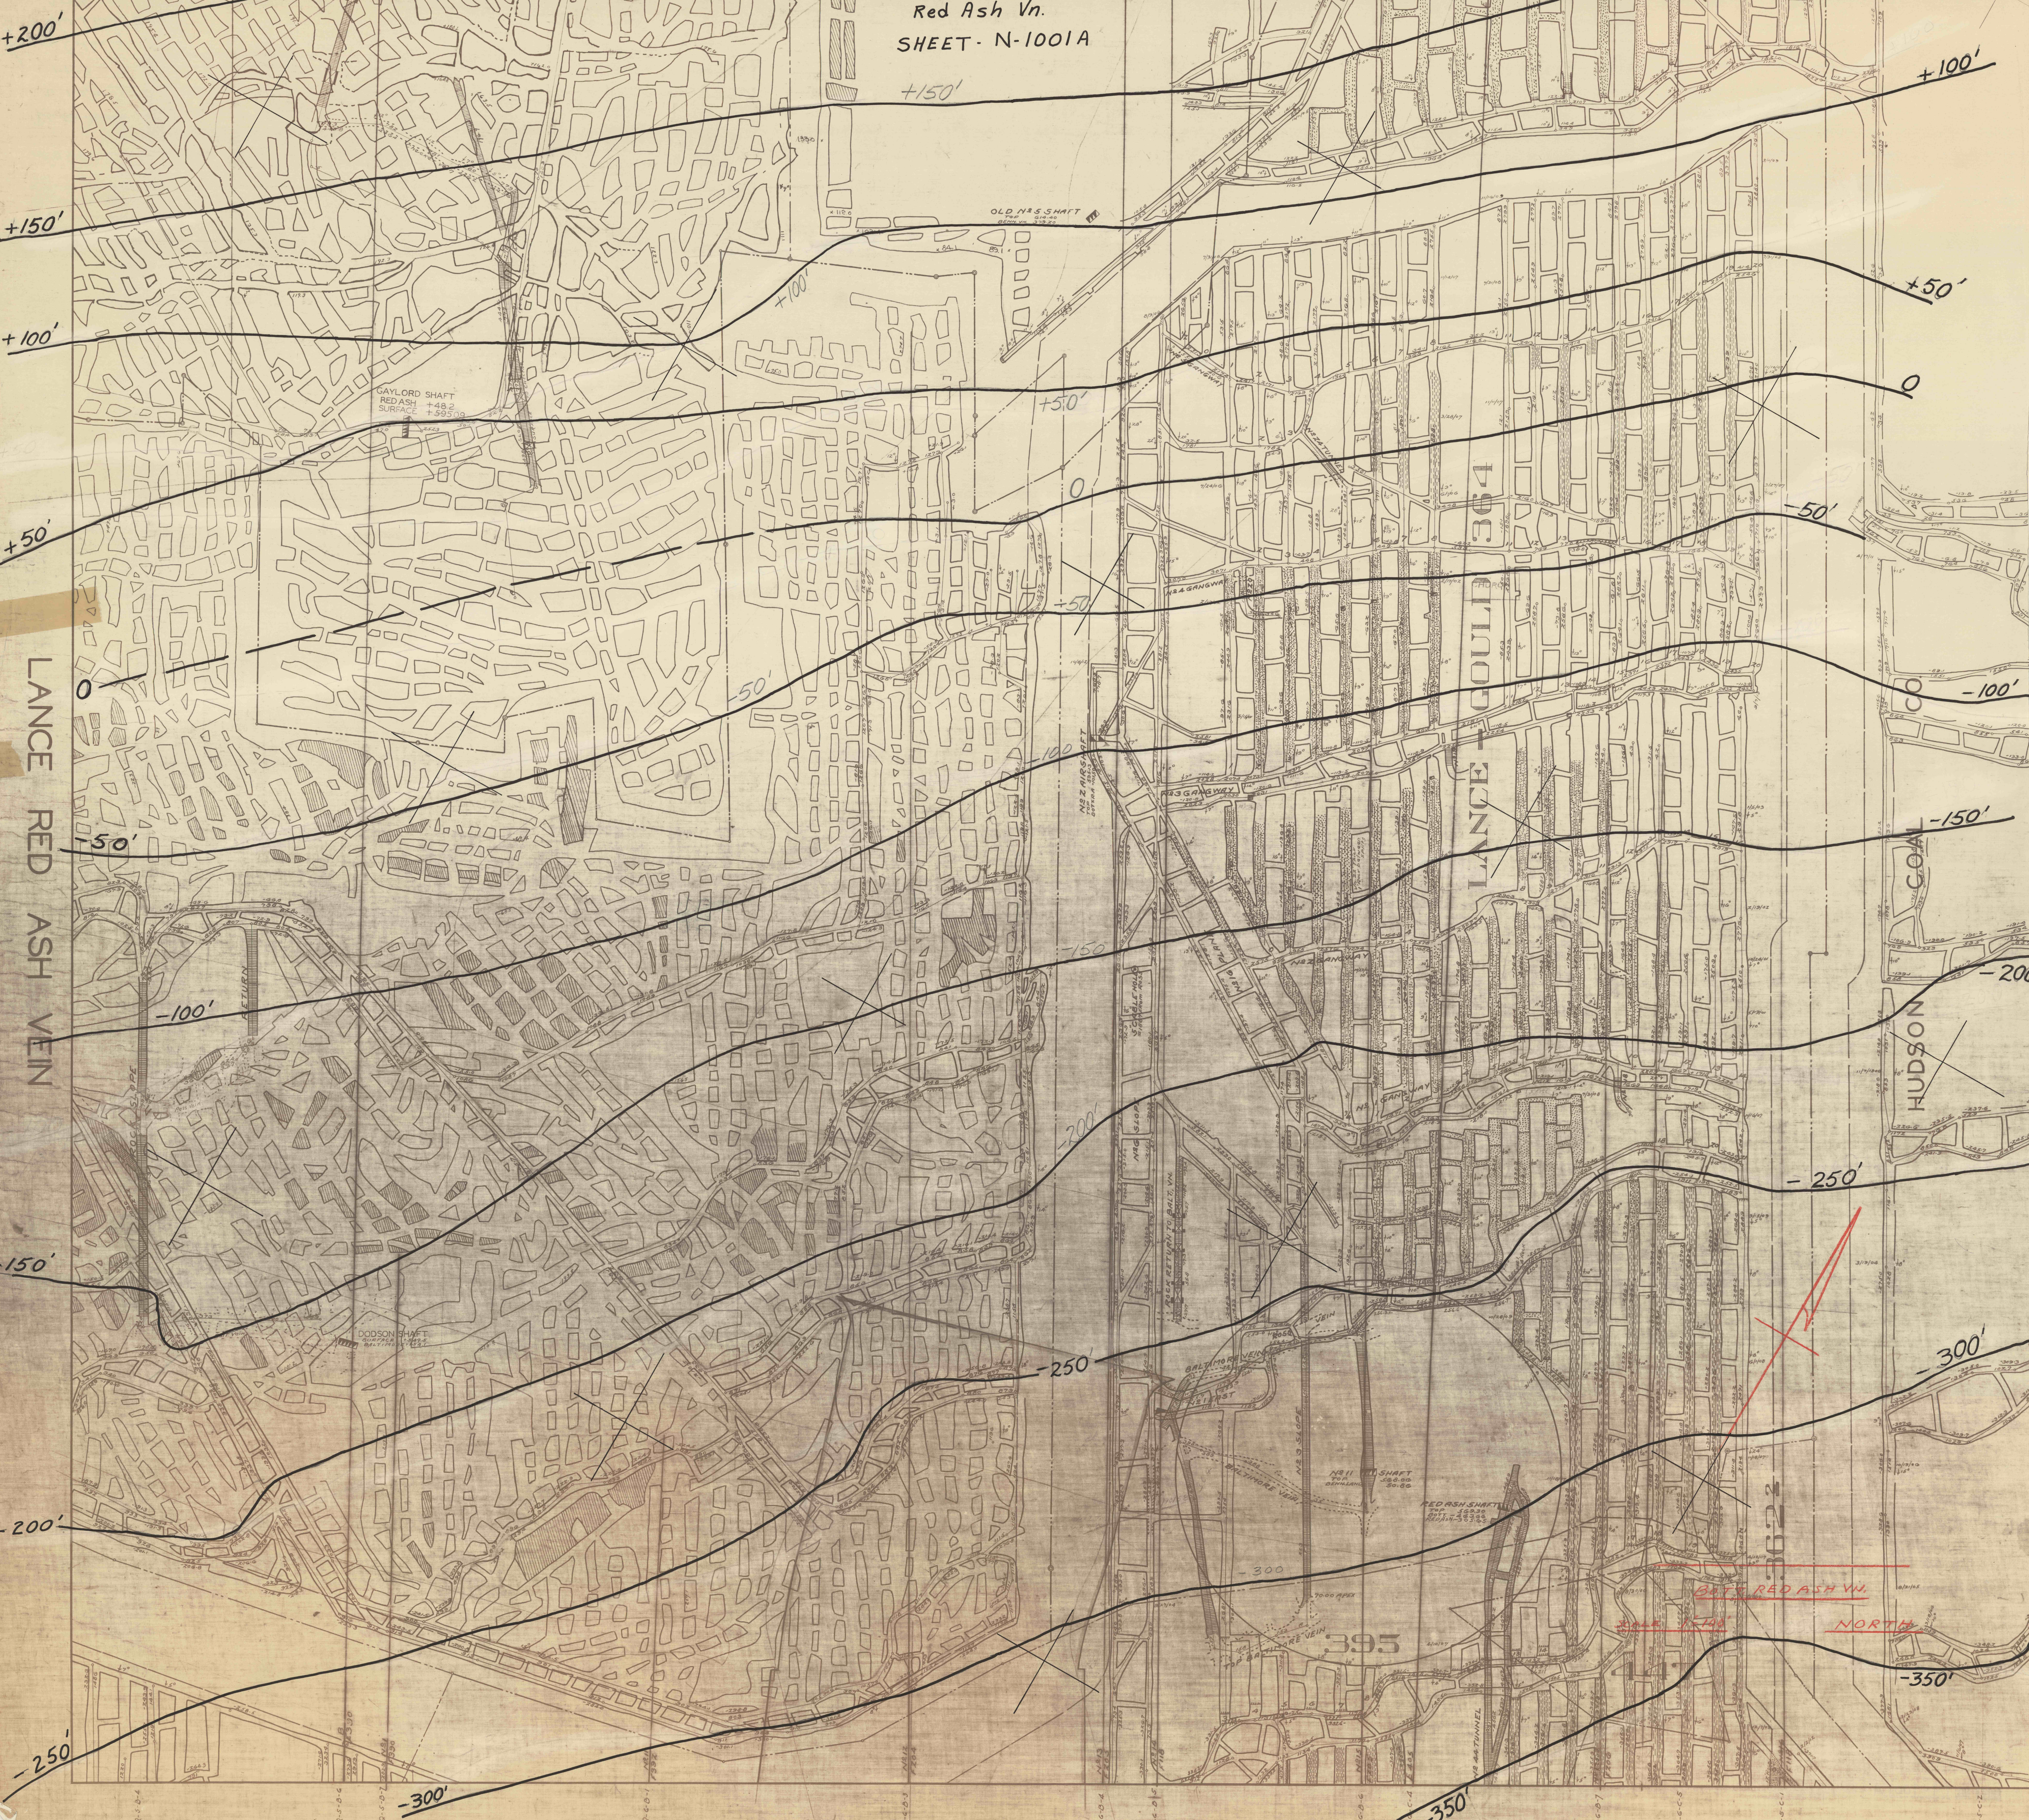

LANCE RED ASH VEIN

LANCE + COULD

HUDSON COAL

RED RED ASH VN.

NORTH