


OAK HILL #8

Section No. 8 - 2360 Feet West of Oak Hill Shaft
Scale 1" = 100' Jan. 1-1920 W. G. Parke & Son
N. 18° 50' W.

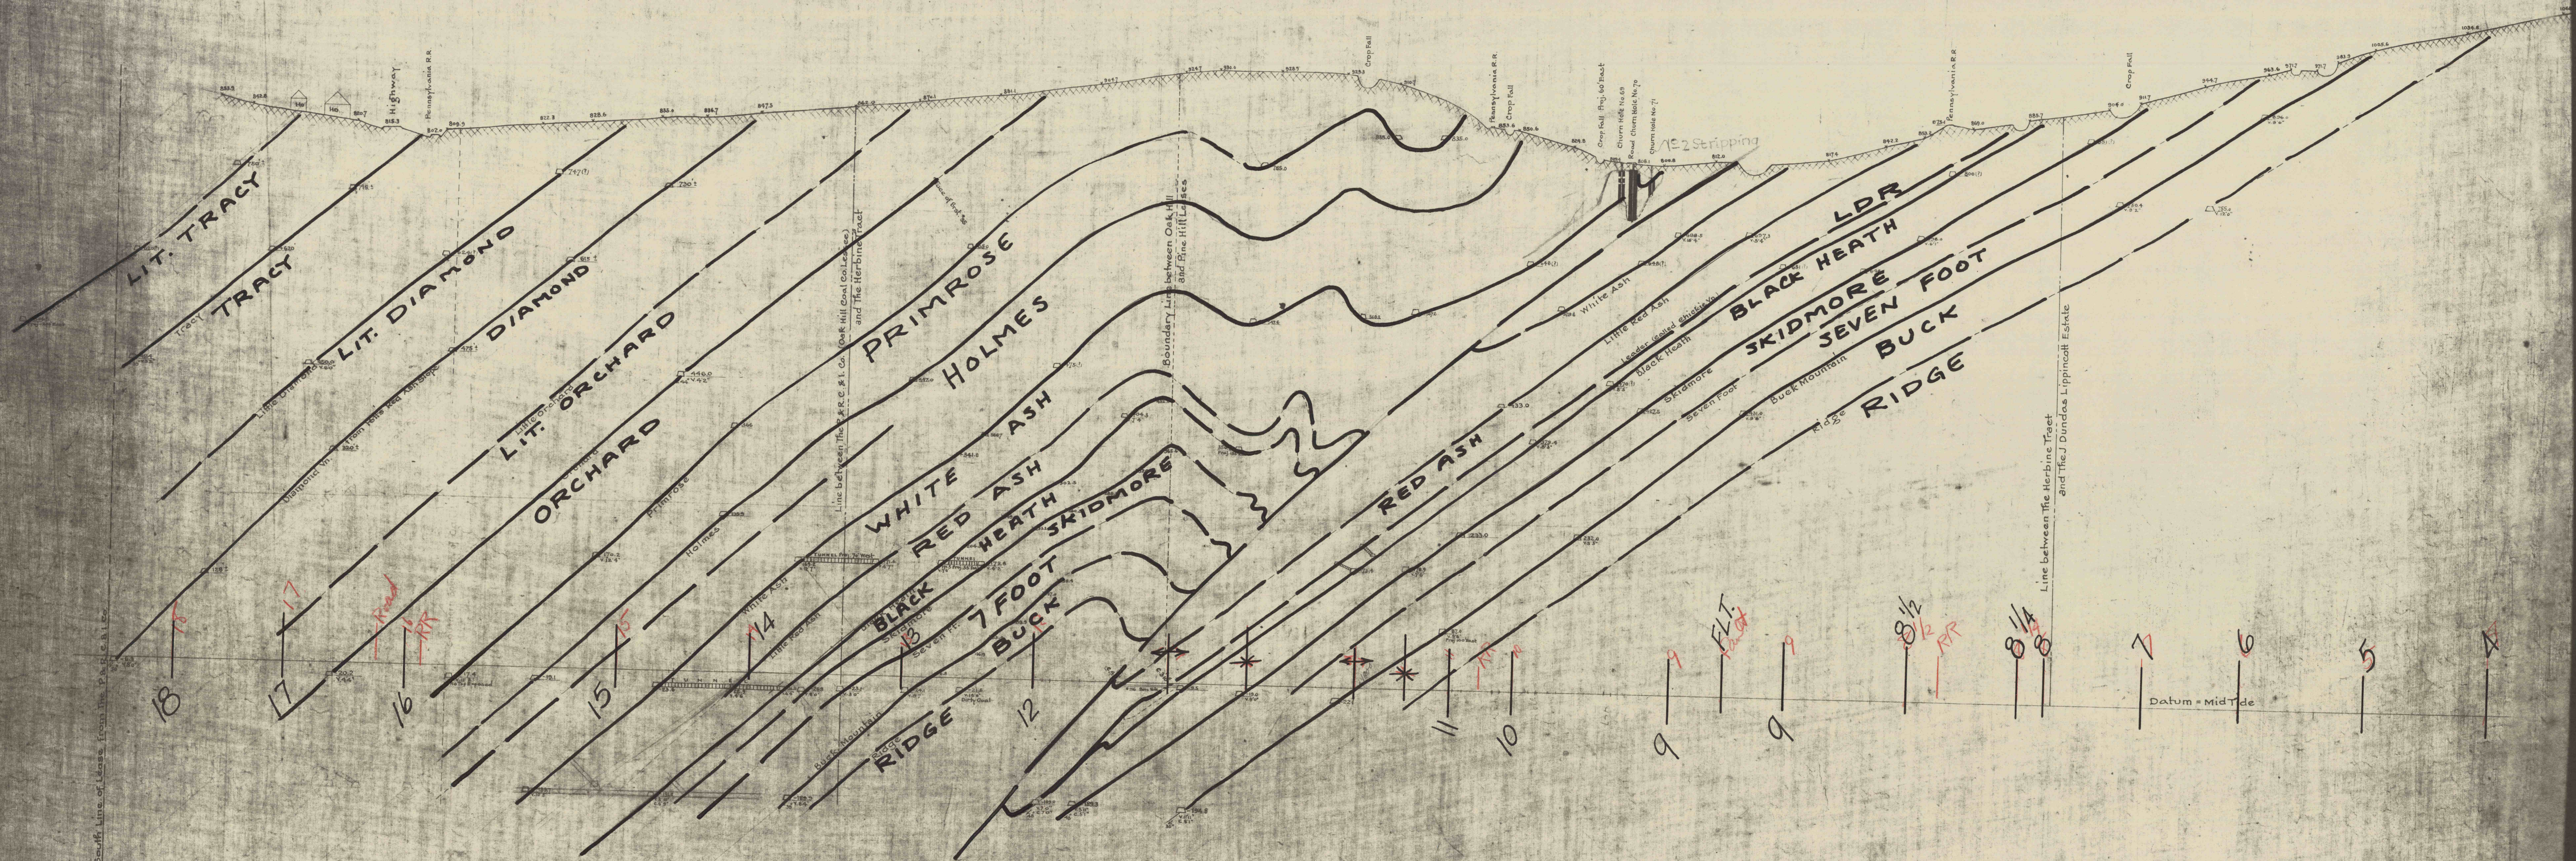

Oak Hill #8