
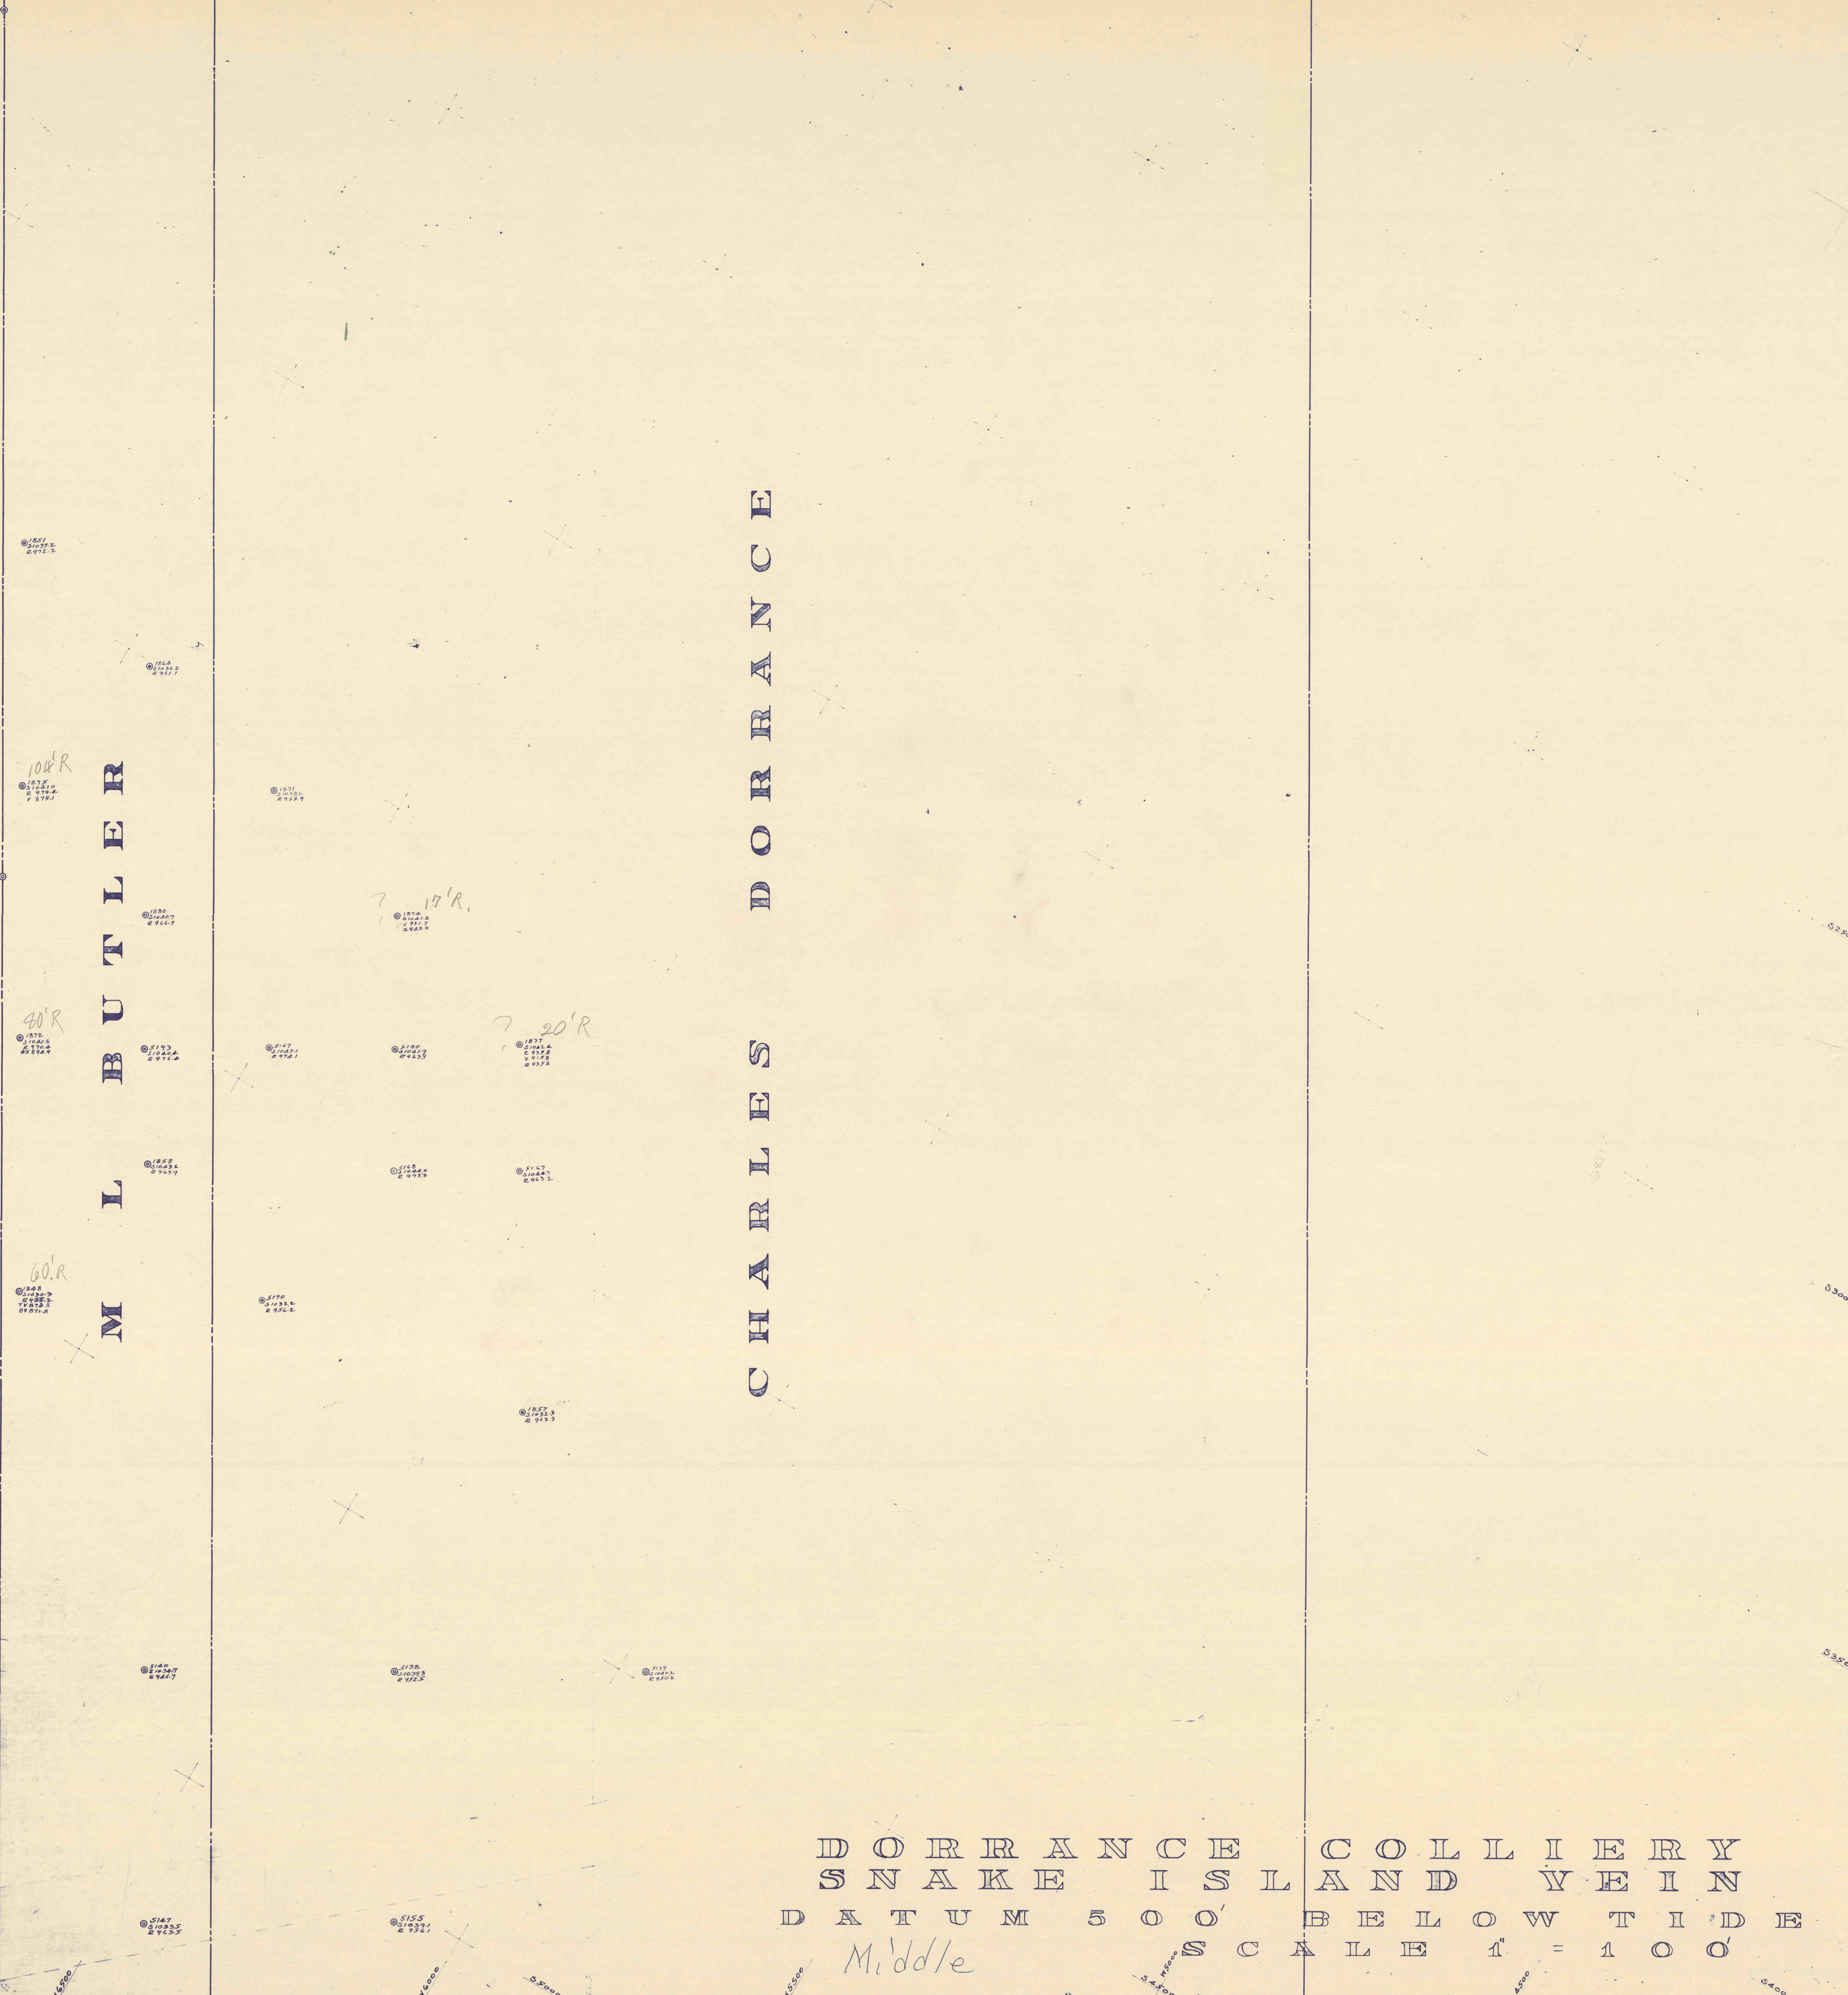


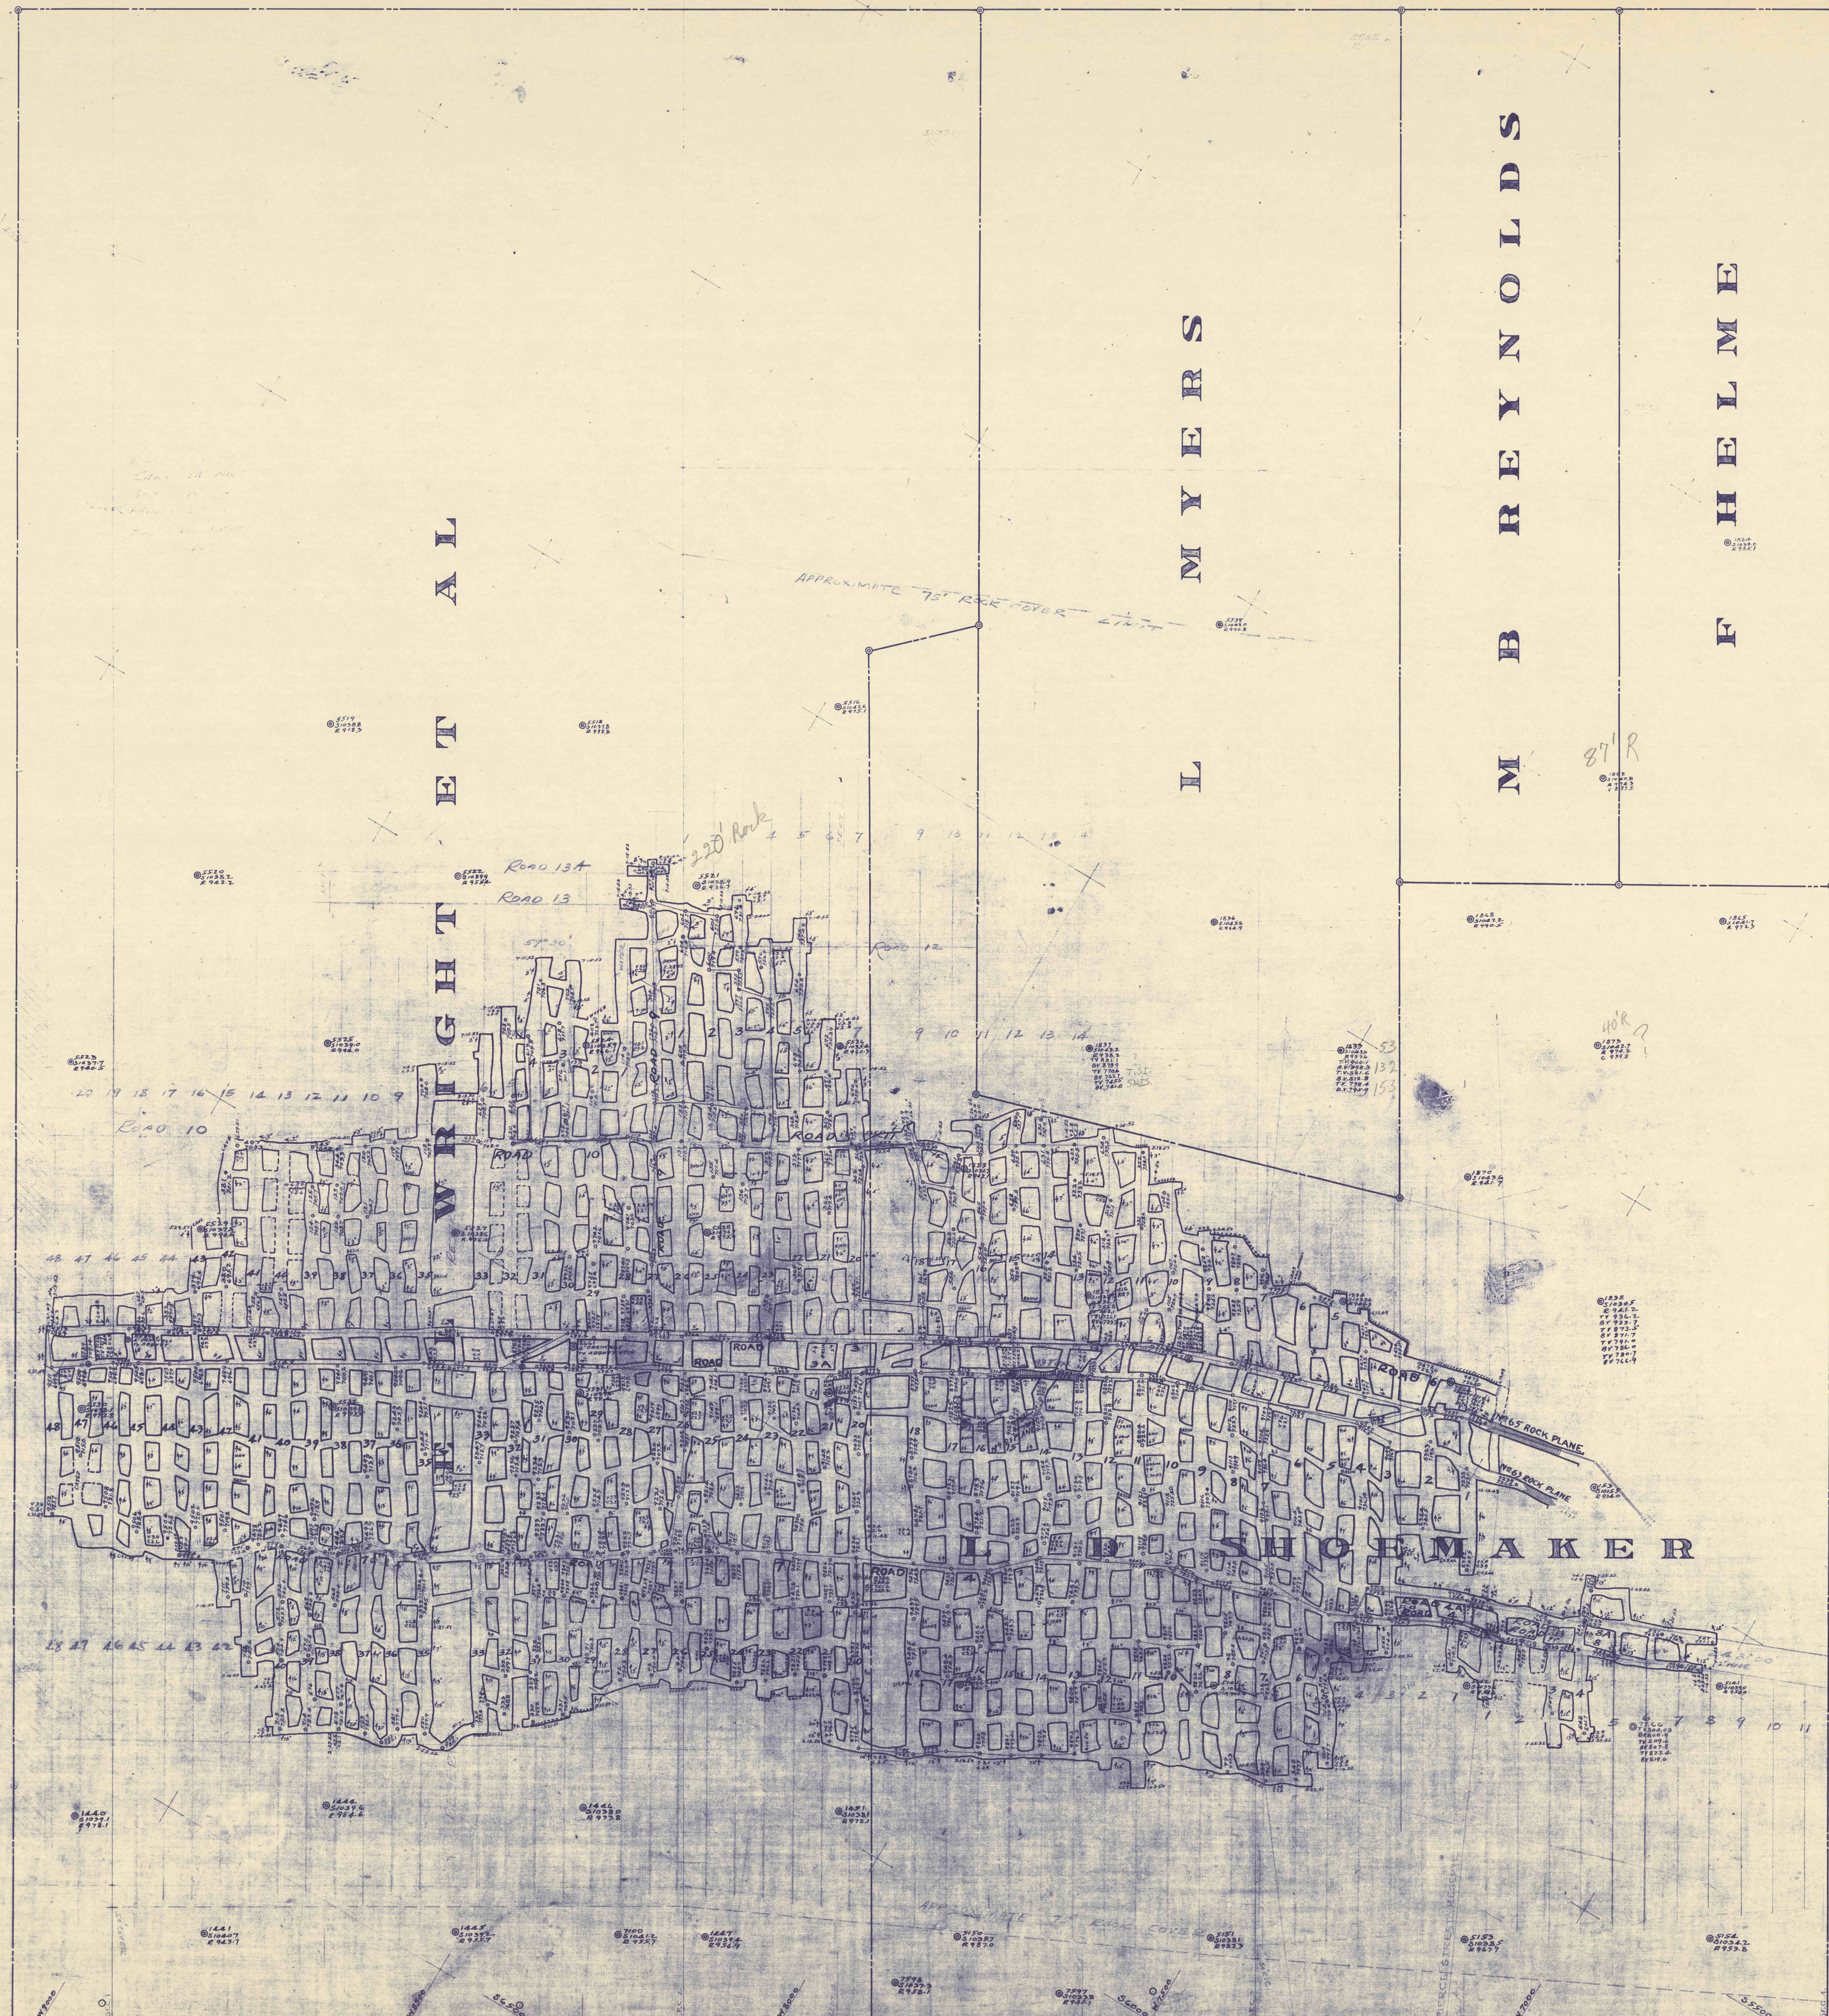

DORRANCE COLLIERY
SNAKE ISLAND VEIN
DATUM 500' BELOW TIDE
SCALE 1" = 100'
Middle