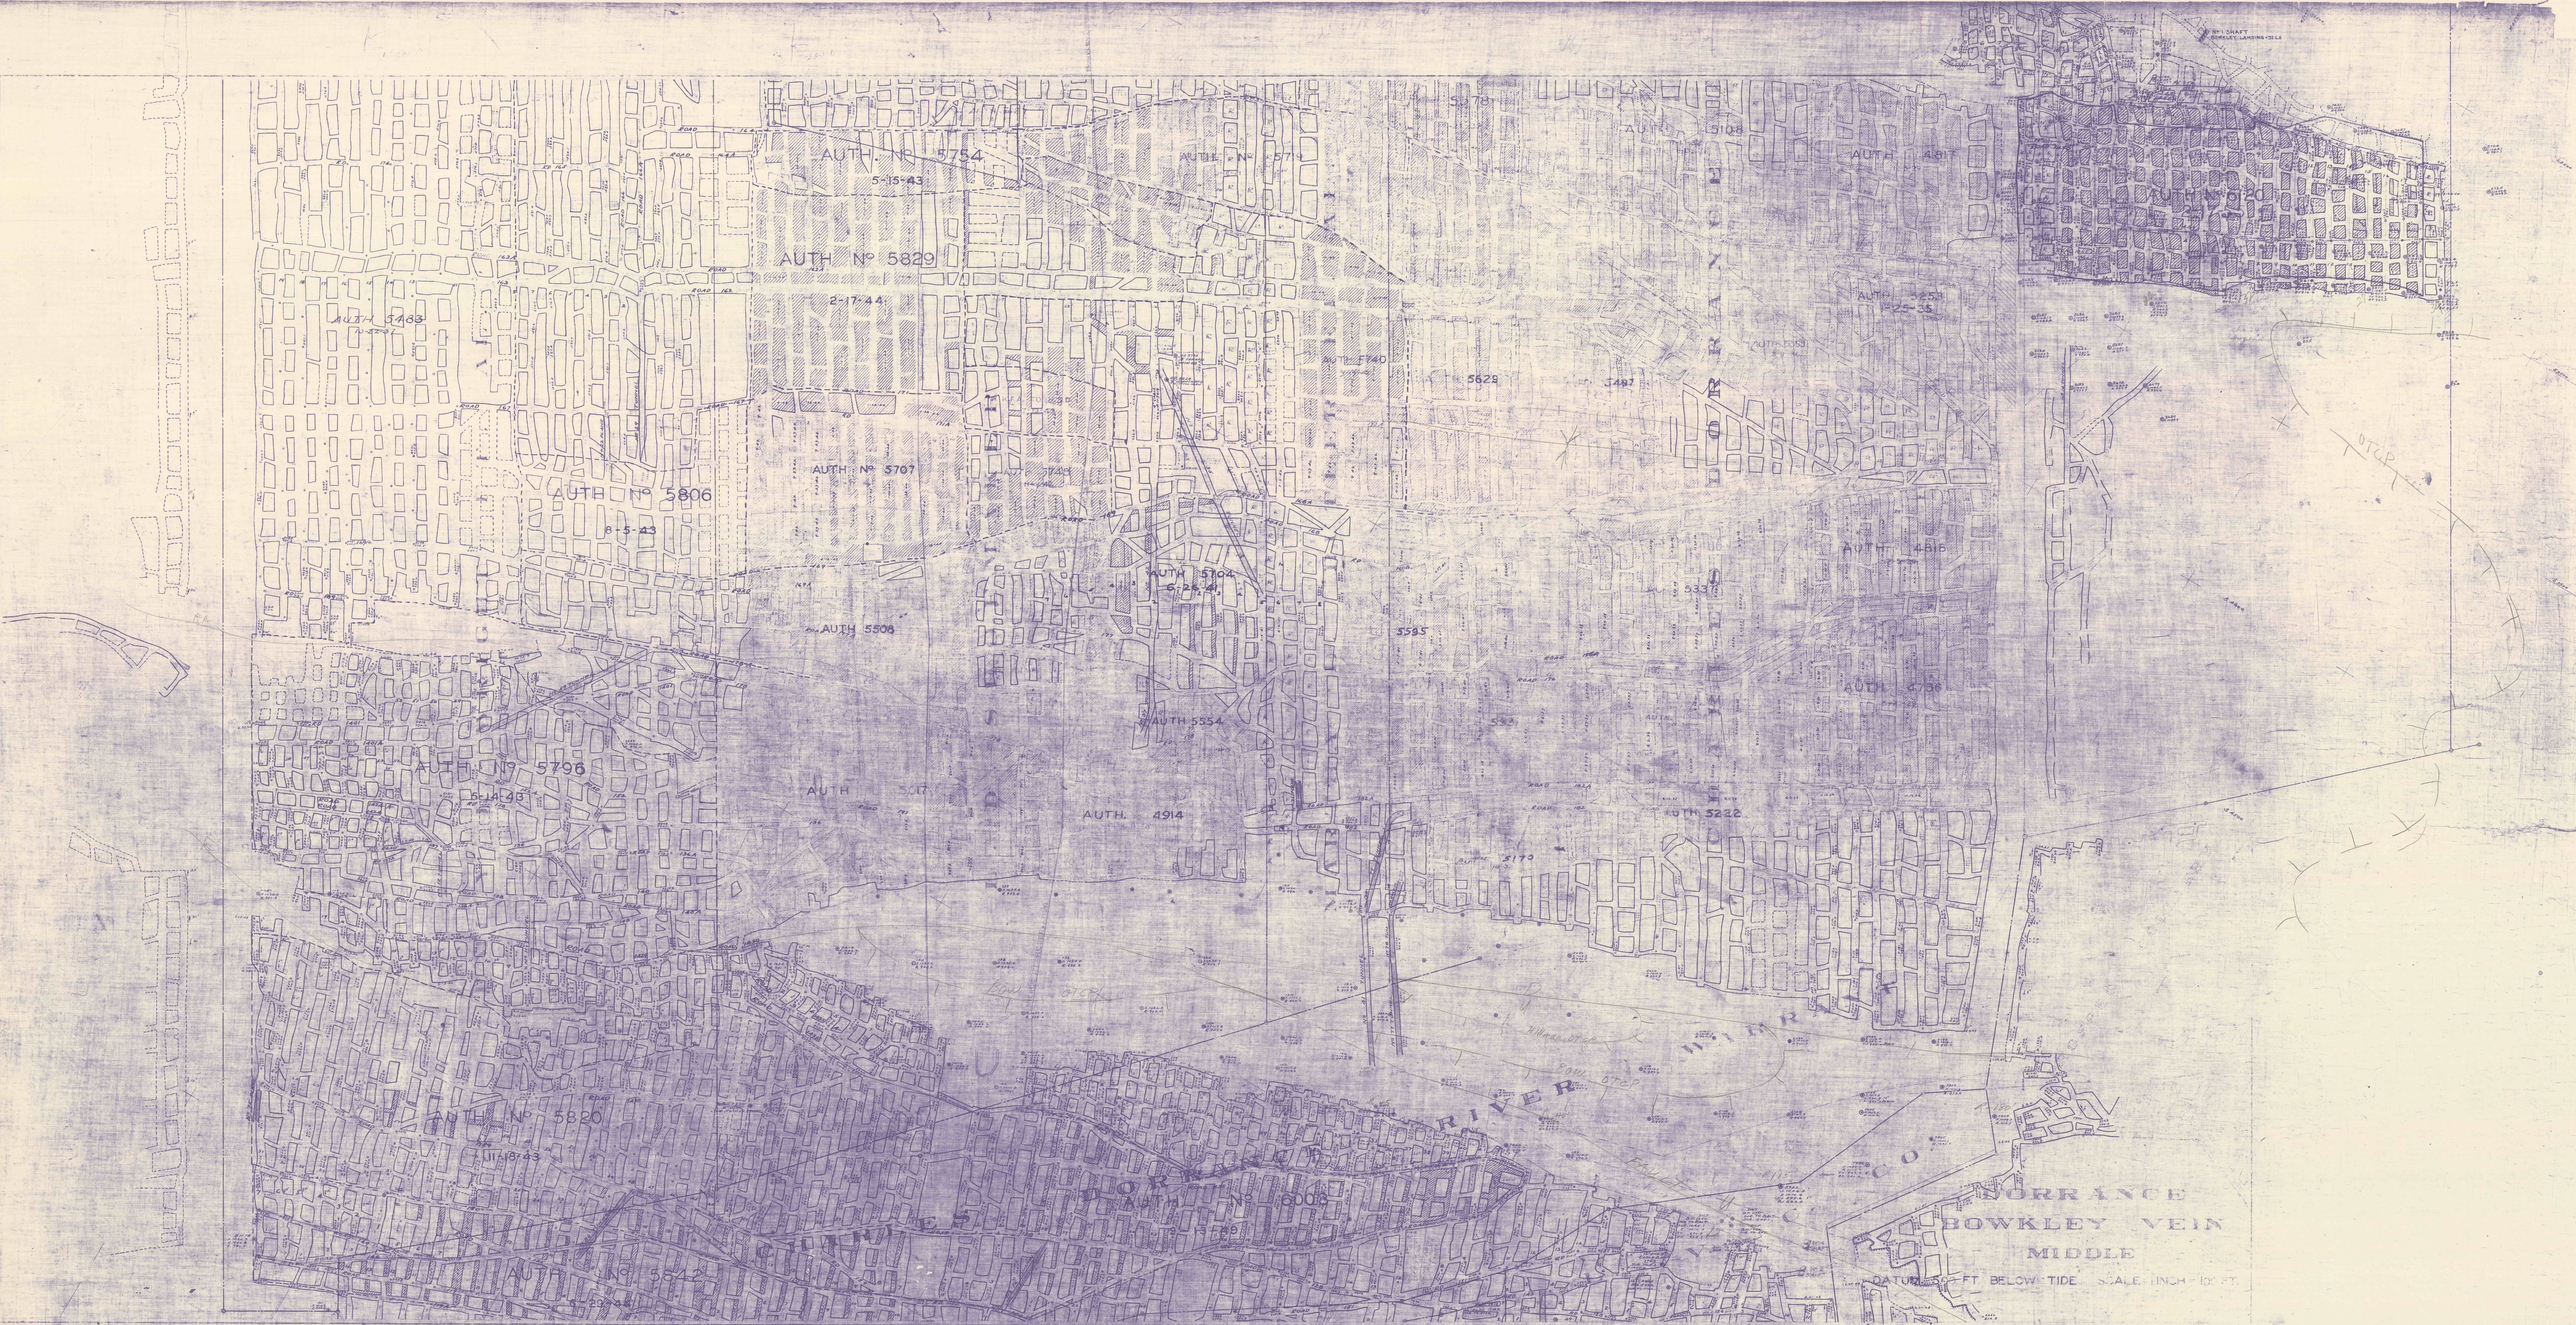

DORRANCE

BOWKLEY VEIN

MIDDLE

DATUM 500 FT. BELOW TIDE SCALE 1 INCH = 100 FT.

AUTH. Nº 5754
5-15-43
AUTH Nº 5829
2-17-44
AUTH. Nº 5719
5178
AUTH 5108
AUTH 4817
AUTH Nº 6120
AUTH 5483
10-22-37
AUTH Nº 5806
8-5-43
AUTH Nº 5707
AUTH 5748
AUTH 5740
AUTH 5629
5497
AUTH 5253
1-25-35
AUTH 5359
AUTH 5704
6-26-41
AUTH 5508
5595
AUTH 5337
AUTH 4816
AUTH 4736
AUTH 5554
AUTH 5017
AUTH. 4914
AUTH 5222
AUTH 5170
AUTH Nº 5796
5-14-43
AUTH Nº 5820
11-18-43
AUTH Nº 5842
6-29-44
AUTH Nº 6008
9-13-49
Nº 1 SHAFT
BOWKLEY LANDING +326.8
Nº 4 SHAFT
Nº 2 SHAFT
ROAD 164
ROAD 164A
RD 165
ROAD 166
ROAD 163A
ROAD 163
ROAD 162
ROAD 167
ROAD 169
ROAD 178-A
ROAD 178
ROAD 168A
ROAD 168
ROAD 176
ROAD 182A
ROAD 182
RD 1401
ROAD 1401A
ROAD 136
ROAD 136A
ROAD 138
ROAD 140
ROAD 140A
ROAD 1429
ROAD 1430
ROAD 1435
TUNNEL
Nº 59 TUNNEL
Nº 12 TUNNEL
Nº 29 TUNNEL
Nº 41 TUNNEL
Nº 77 TUNNEL
Nº 78 TUNNEL
BOW OTCP
Hillman OTCP
OTCP
R 40'
R-180'
R 115'
FAULT
RIVER
DORRANCE
CHARLES
WILKES-BARRE
PEOPLES COAL CO.