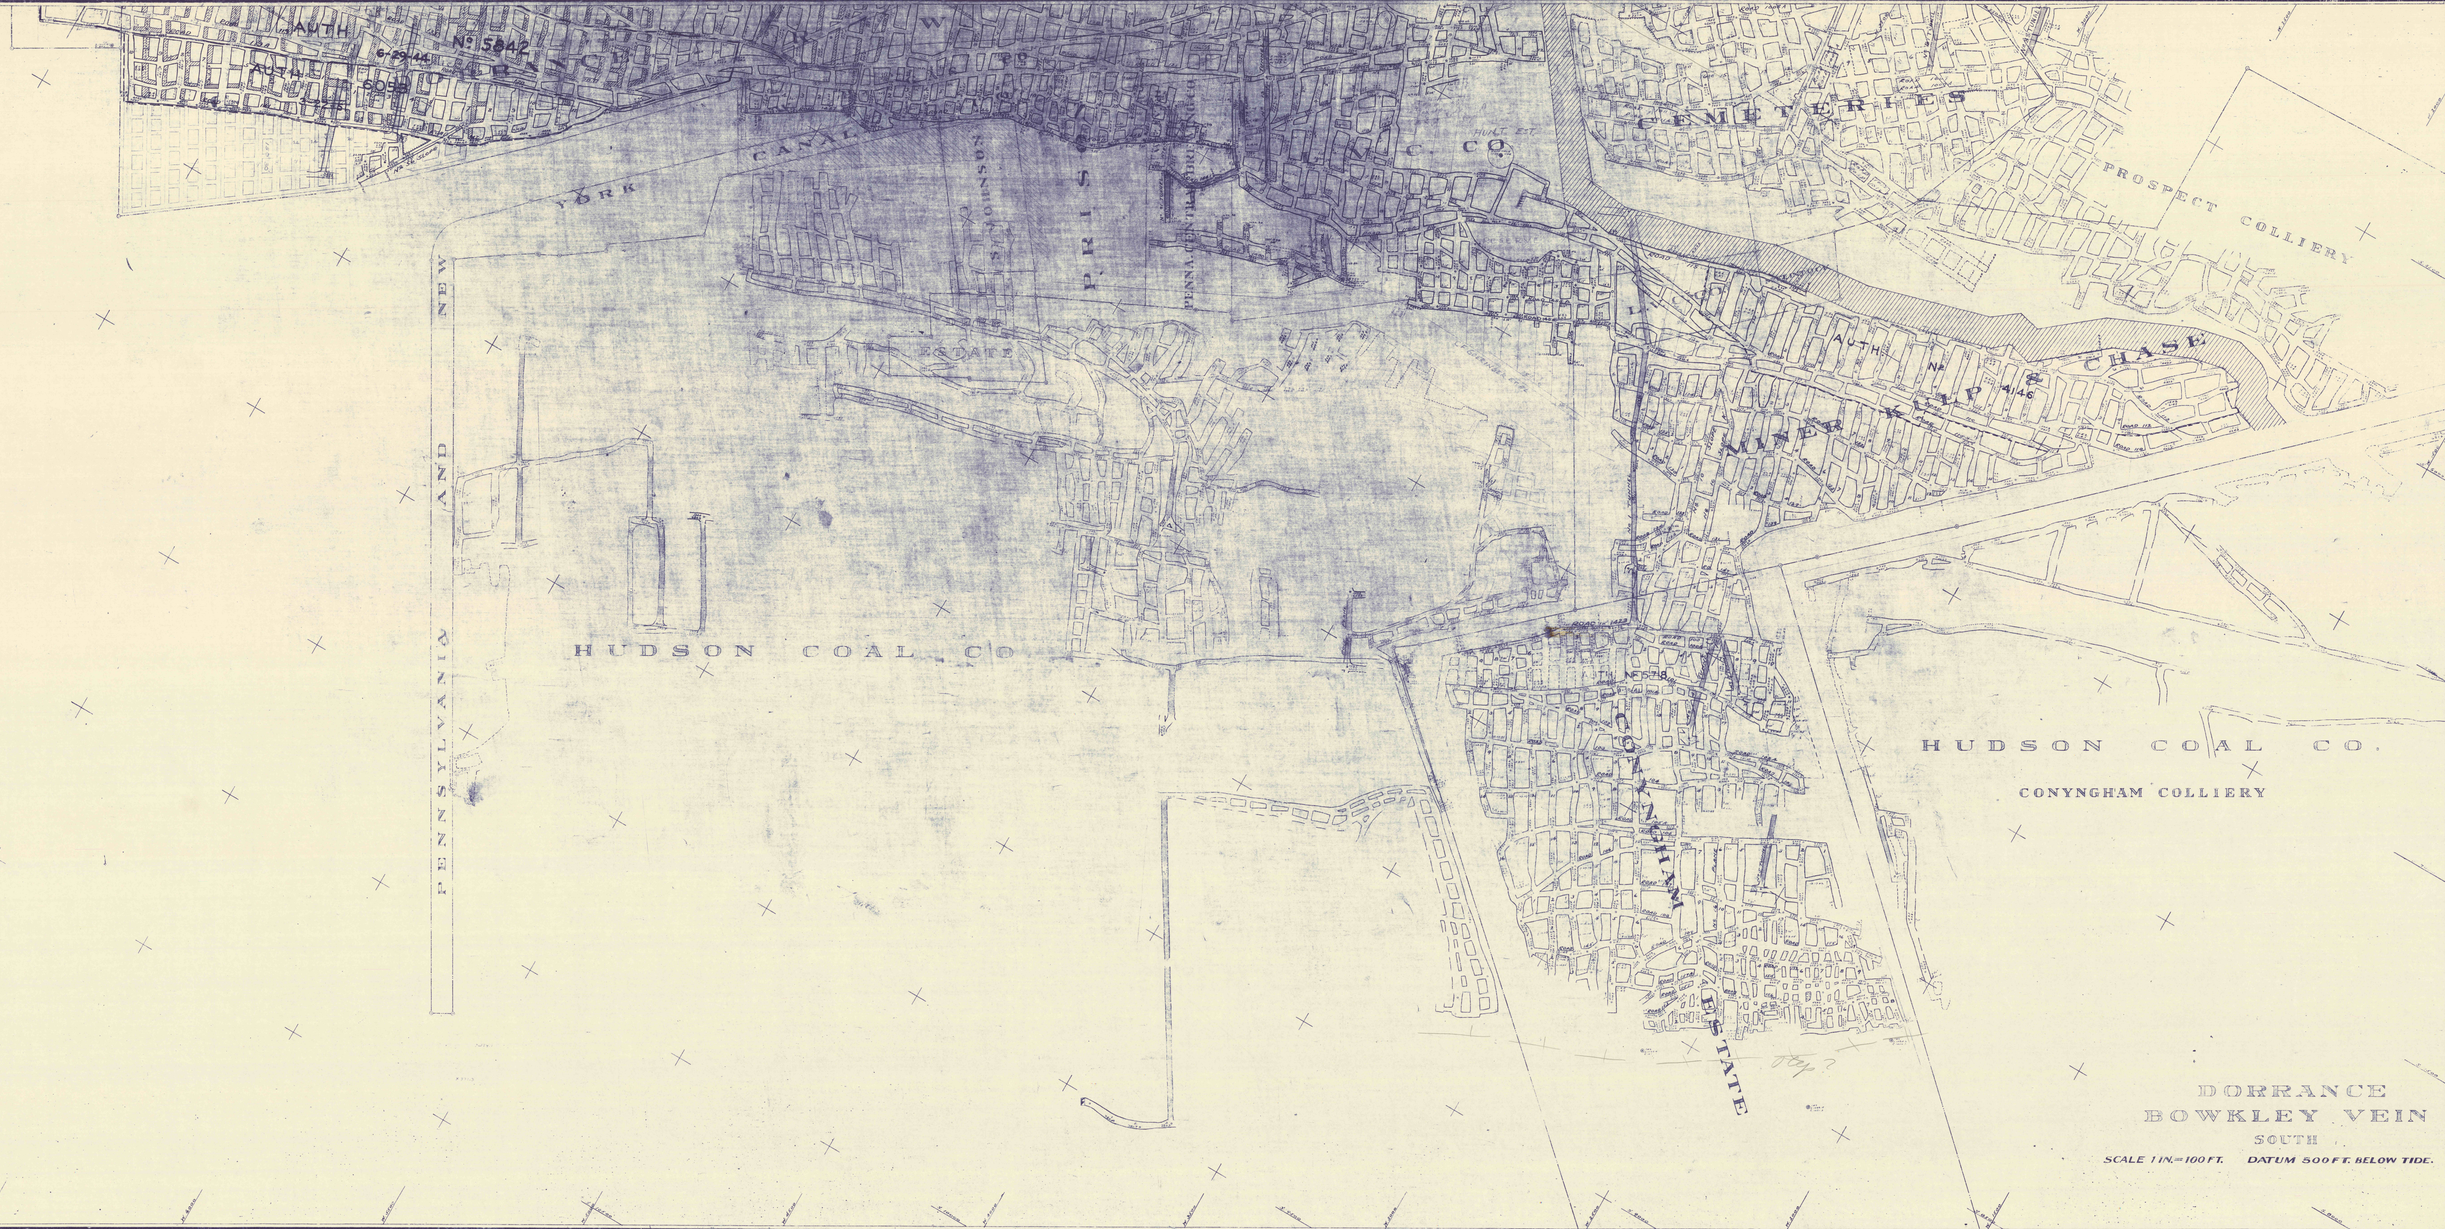

AUTH
6-29-44
No 5842
AUTH
6053
3-22-5
No 56 SLOPE
NEW YORK CANAL
PENNSYLVANIA AND
S. JOHNSON
PRIS
PENNA. CENTRAL BREWING CO.
No 1 TUNNEL
HUNT EST.
C. CO.
DERR ESTATE
C.F. GOERINGER EST.
RESERVE
HUDSON COAL CO
CEMETERIES
PROSPECT COLLIERY
CHASE
MINER KULP &
AUTH
No
4146
SLOPE
ROAD 1423
AUTH No 5718
CONYNGHAM ESTATE
HUDSON COAL CO.
CONYNGHAM COLLIERY
W 6500
W 6000
W 5500
W 5000
S 10500
W 4500
S 10000
W 4000
W 3500
S 9500
W 3000
W 2500
S 9000
W 2000
S 8500
W 1500
S 8000
W 7000
W 7500
S 10000

DORRANCE
BOWKLEY VEIN
SOUTH

SCALE 1 IN.=100 FT. DATUM 500 FT. BELOW TIDE.