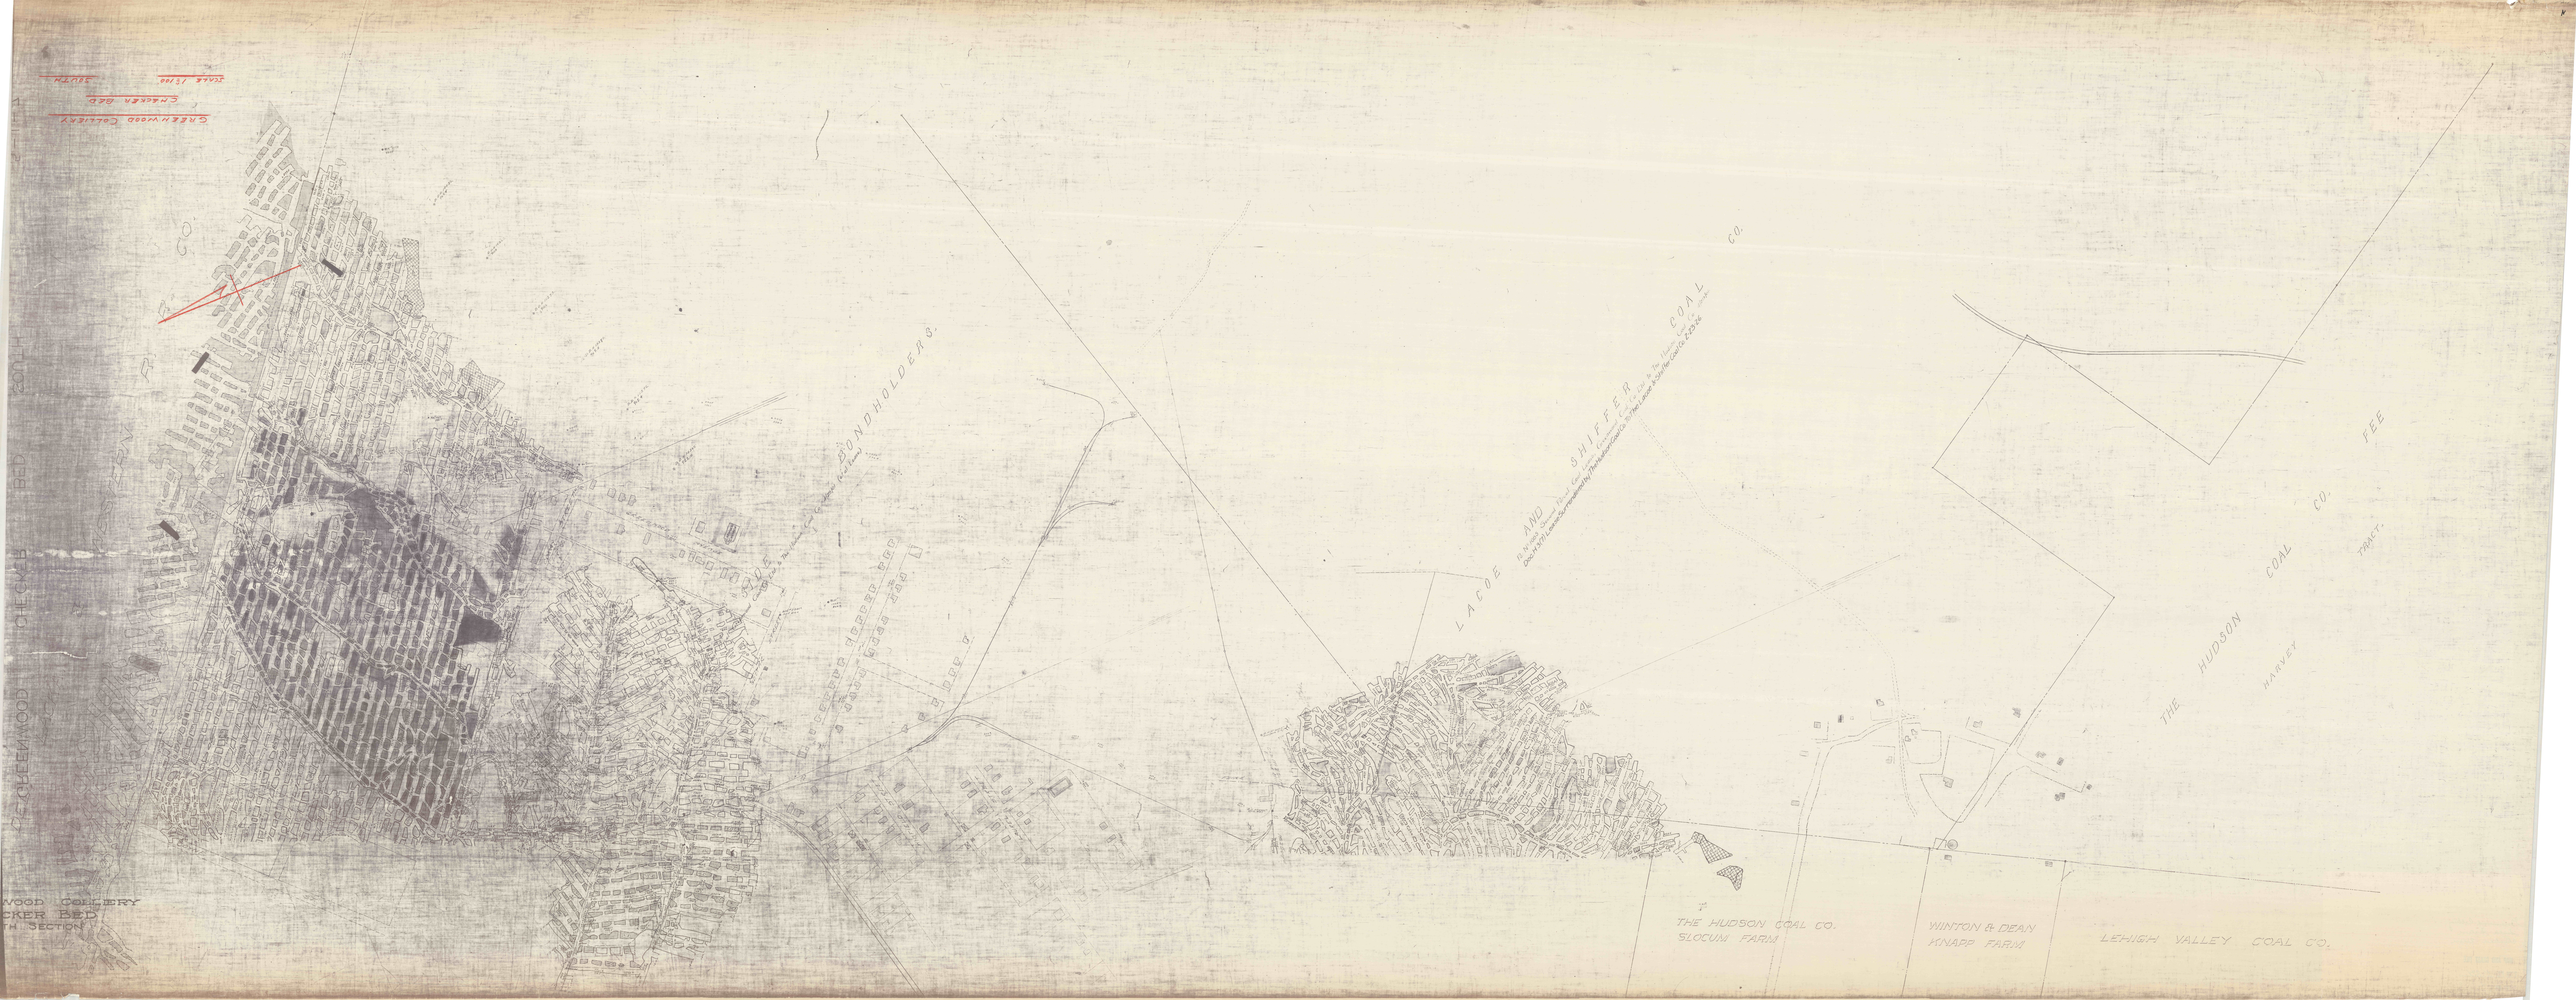
GREENWOOD COLLIERY
CHECKER BED
SOUTH
SCALE 1/100
BONDHOLDERS
LACOE AND SHIFFER COAL CO.
THE HUDSON COAL CO.
HARVEY TRACT.
FEE
THE HUDSON COAL CO.
SLOCUM FARM
WINTON & DEAN
KNAPP FARM
LEHIGH VALLEY COAL CO.