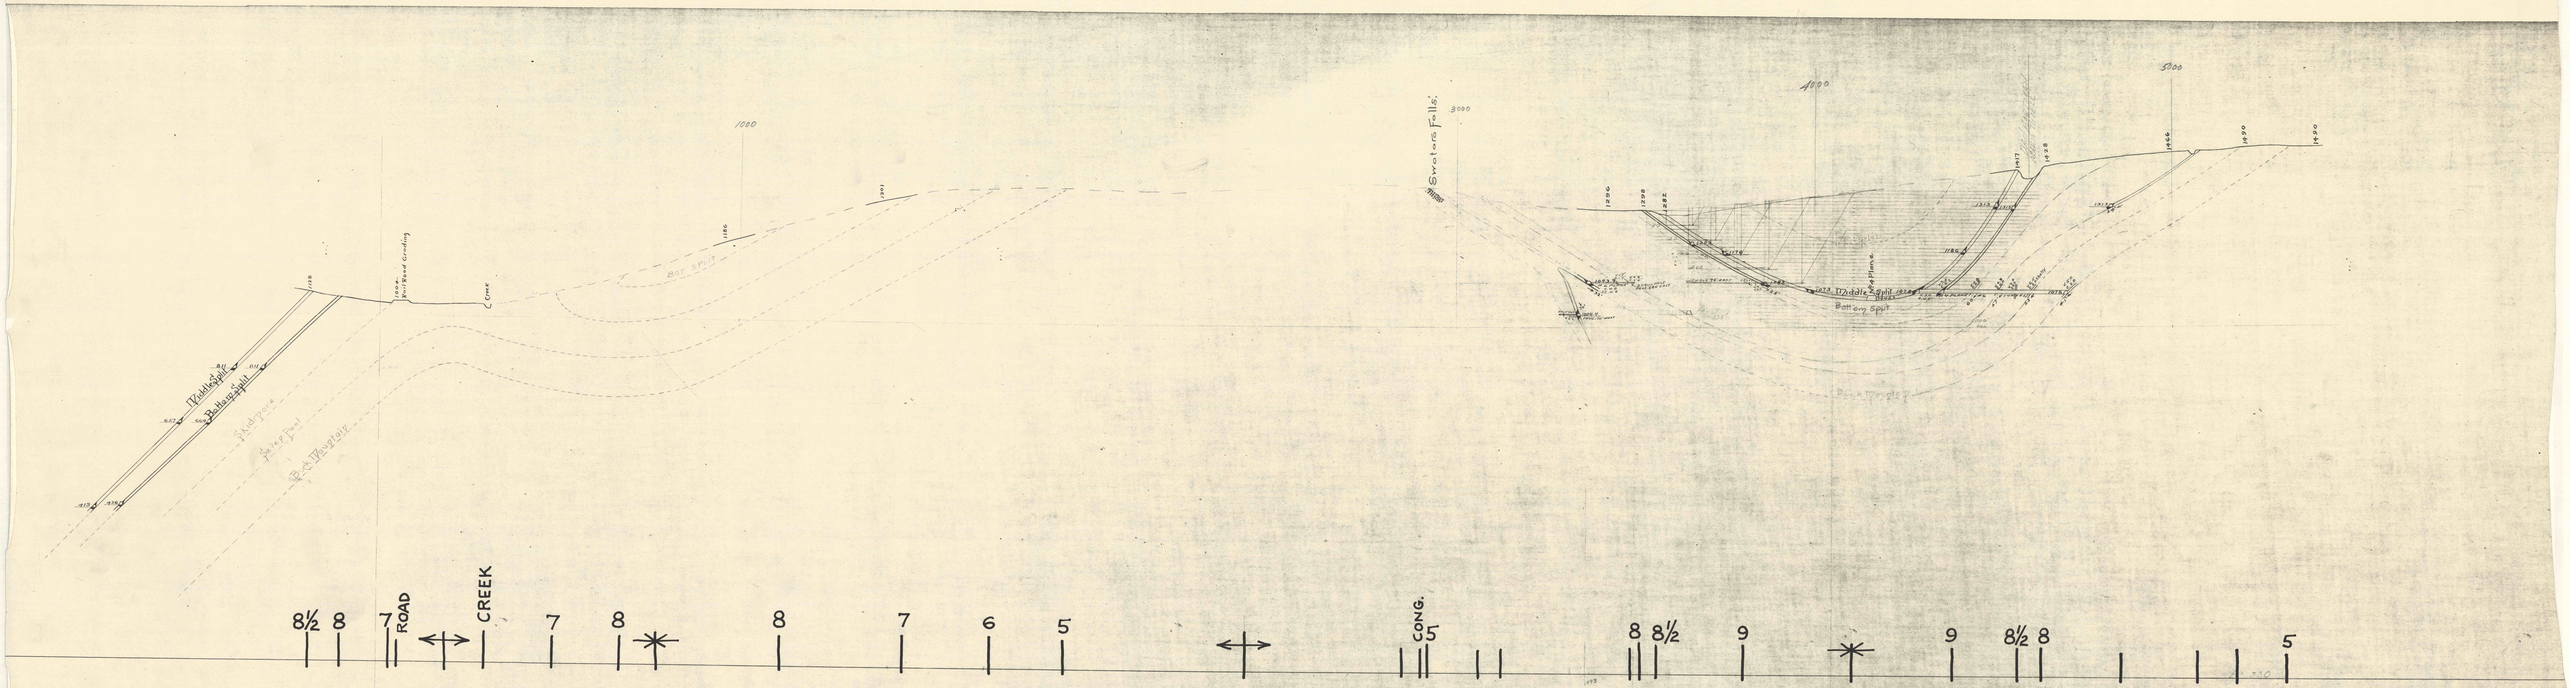

CROSS-SECTION #35

AT OTTO COLLIERY

SCALE 1"-100' THRU MOUTH OF SWATARA SLOPE

LOOKING WEST POTTSVILLE PA.

C. E. Mc GHEE DIV. ENGR. MARCH-1924

OTTO #35

OTTO #35