OTTO #17

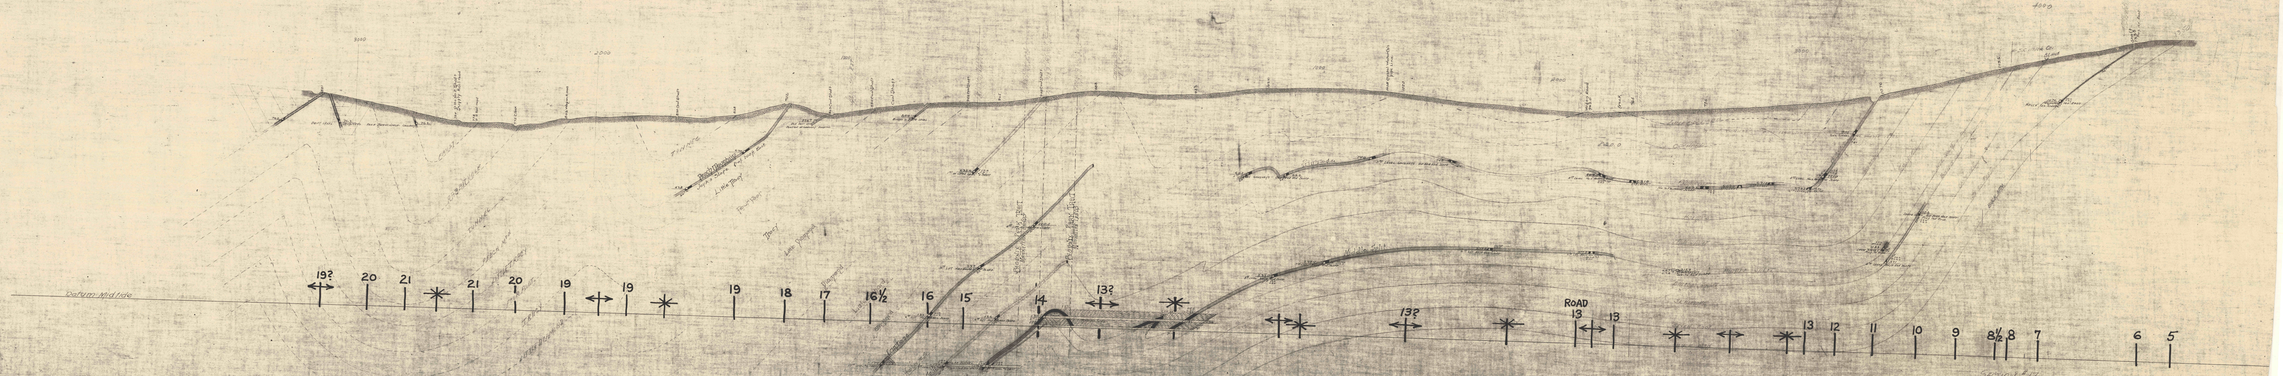

#17

OTTO-COLLIERY

SECTION THRU "50 TUNNEL-EAST MIDDLE SPLIT GANG & LEVEL SHAFT WORKINGS

Scale 1:1200

Feby. 1932

OTTO #17