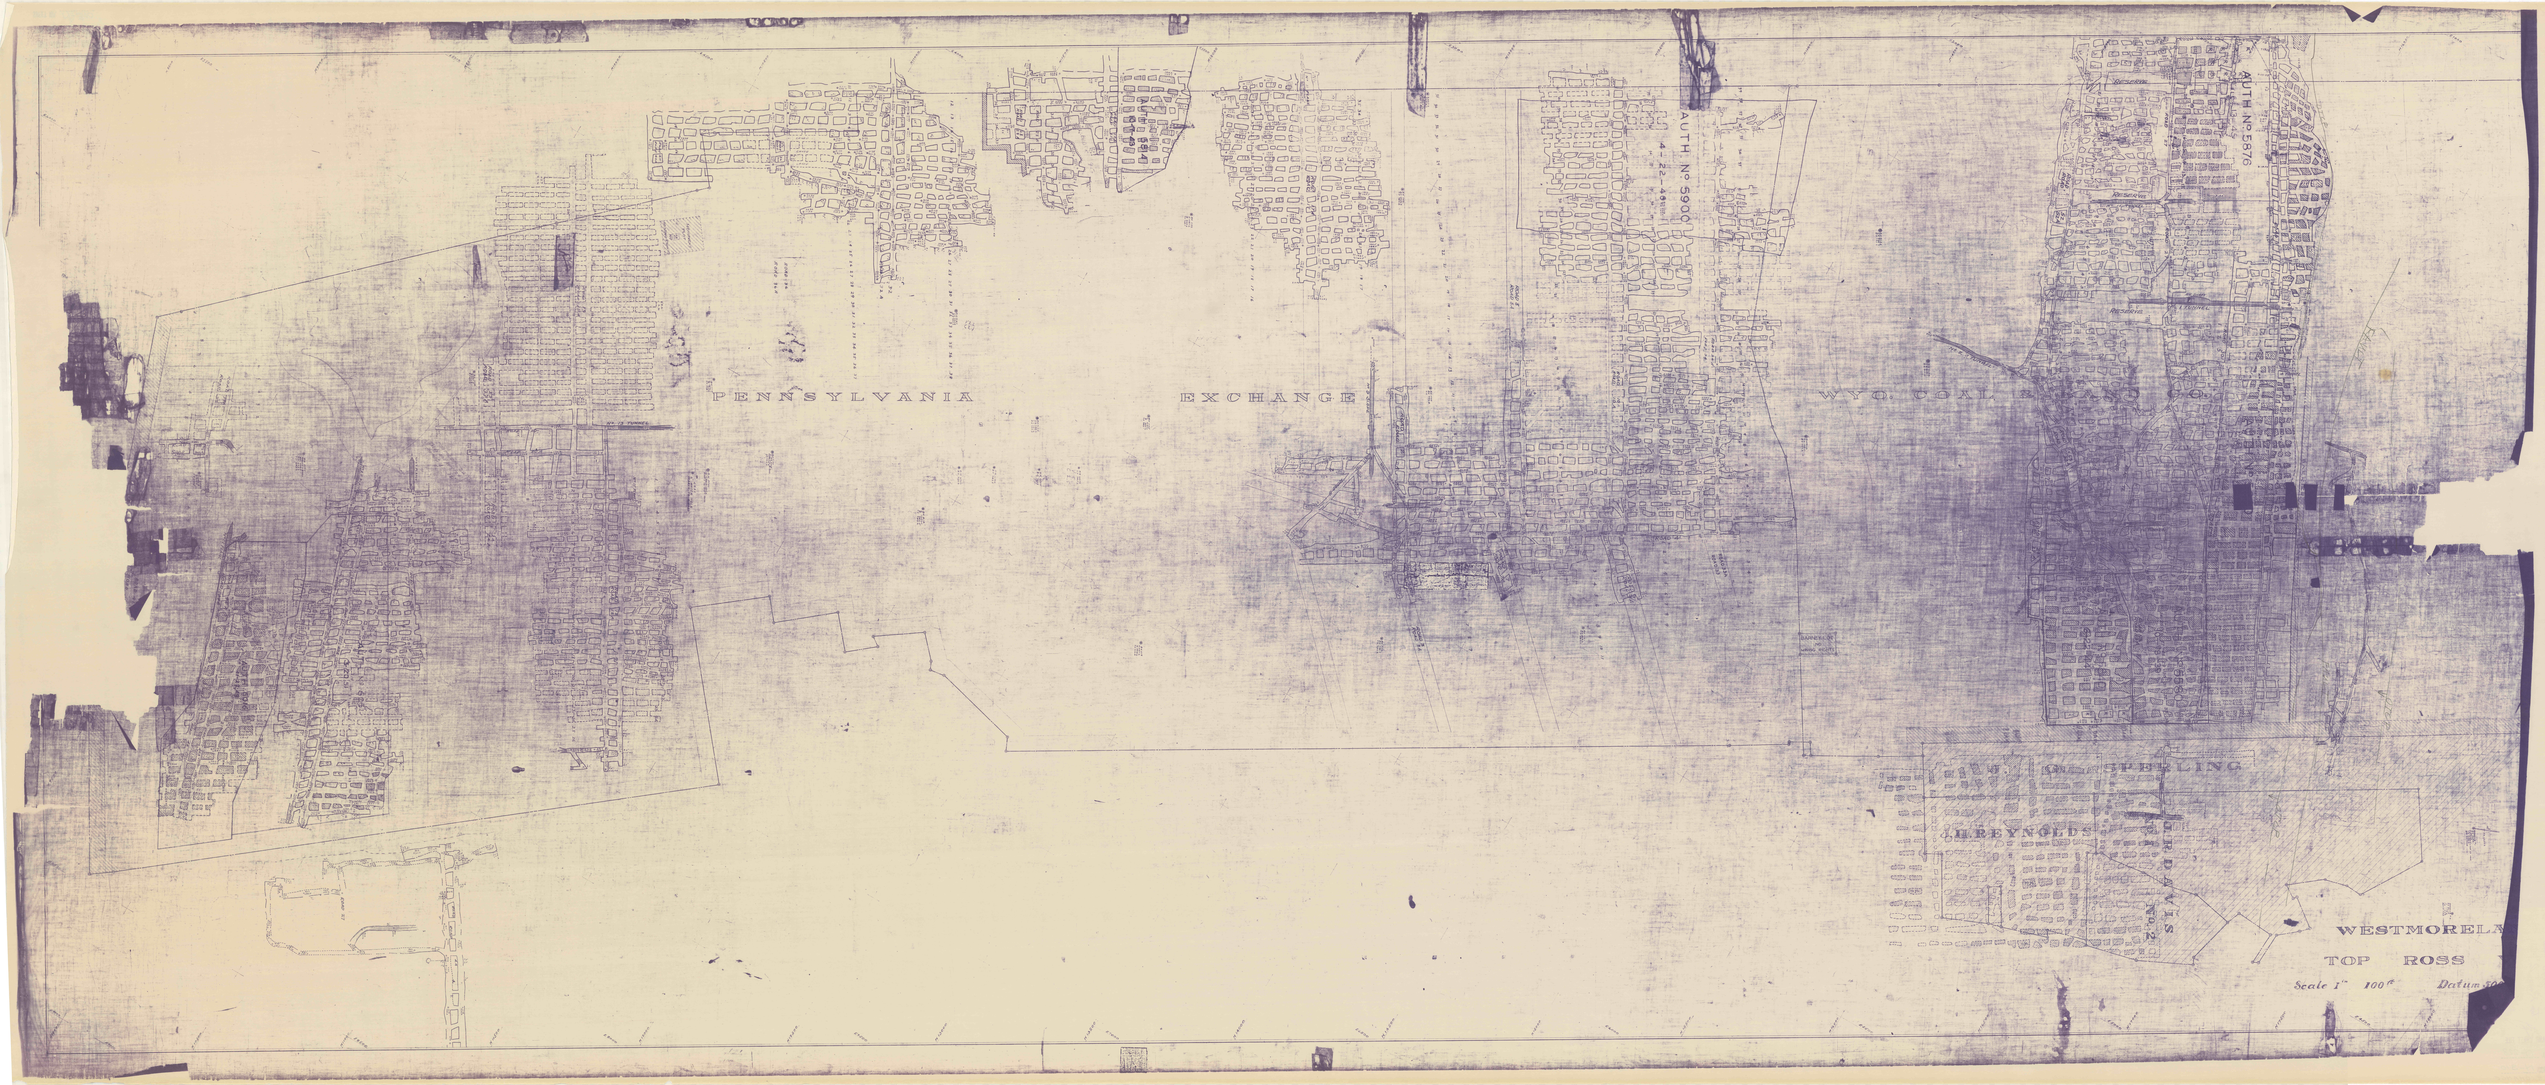

PENNSYLVANIA EXCHANGE
WYO. COAL & LAND CO.
AUTH. Nº 5900
4-22-40
AUTH Nº 5876
RESERVE
RESERVE
RESERVE
Nº 2 TUNNEL
1 TUNNEL
AIR SHAFT
J. G. SPERLING
J. H. REYNOLDS
J. R. DAVIS
NO. 2
WESTMORELA
TOP ROSS
Scale 1" 100ft
Datum 50
N16000
E5500
N16500
E5000
N17000
N17500
E4500
N18000