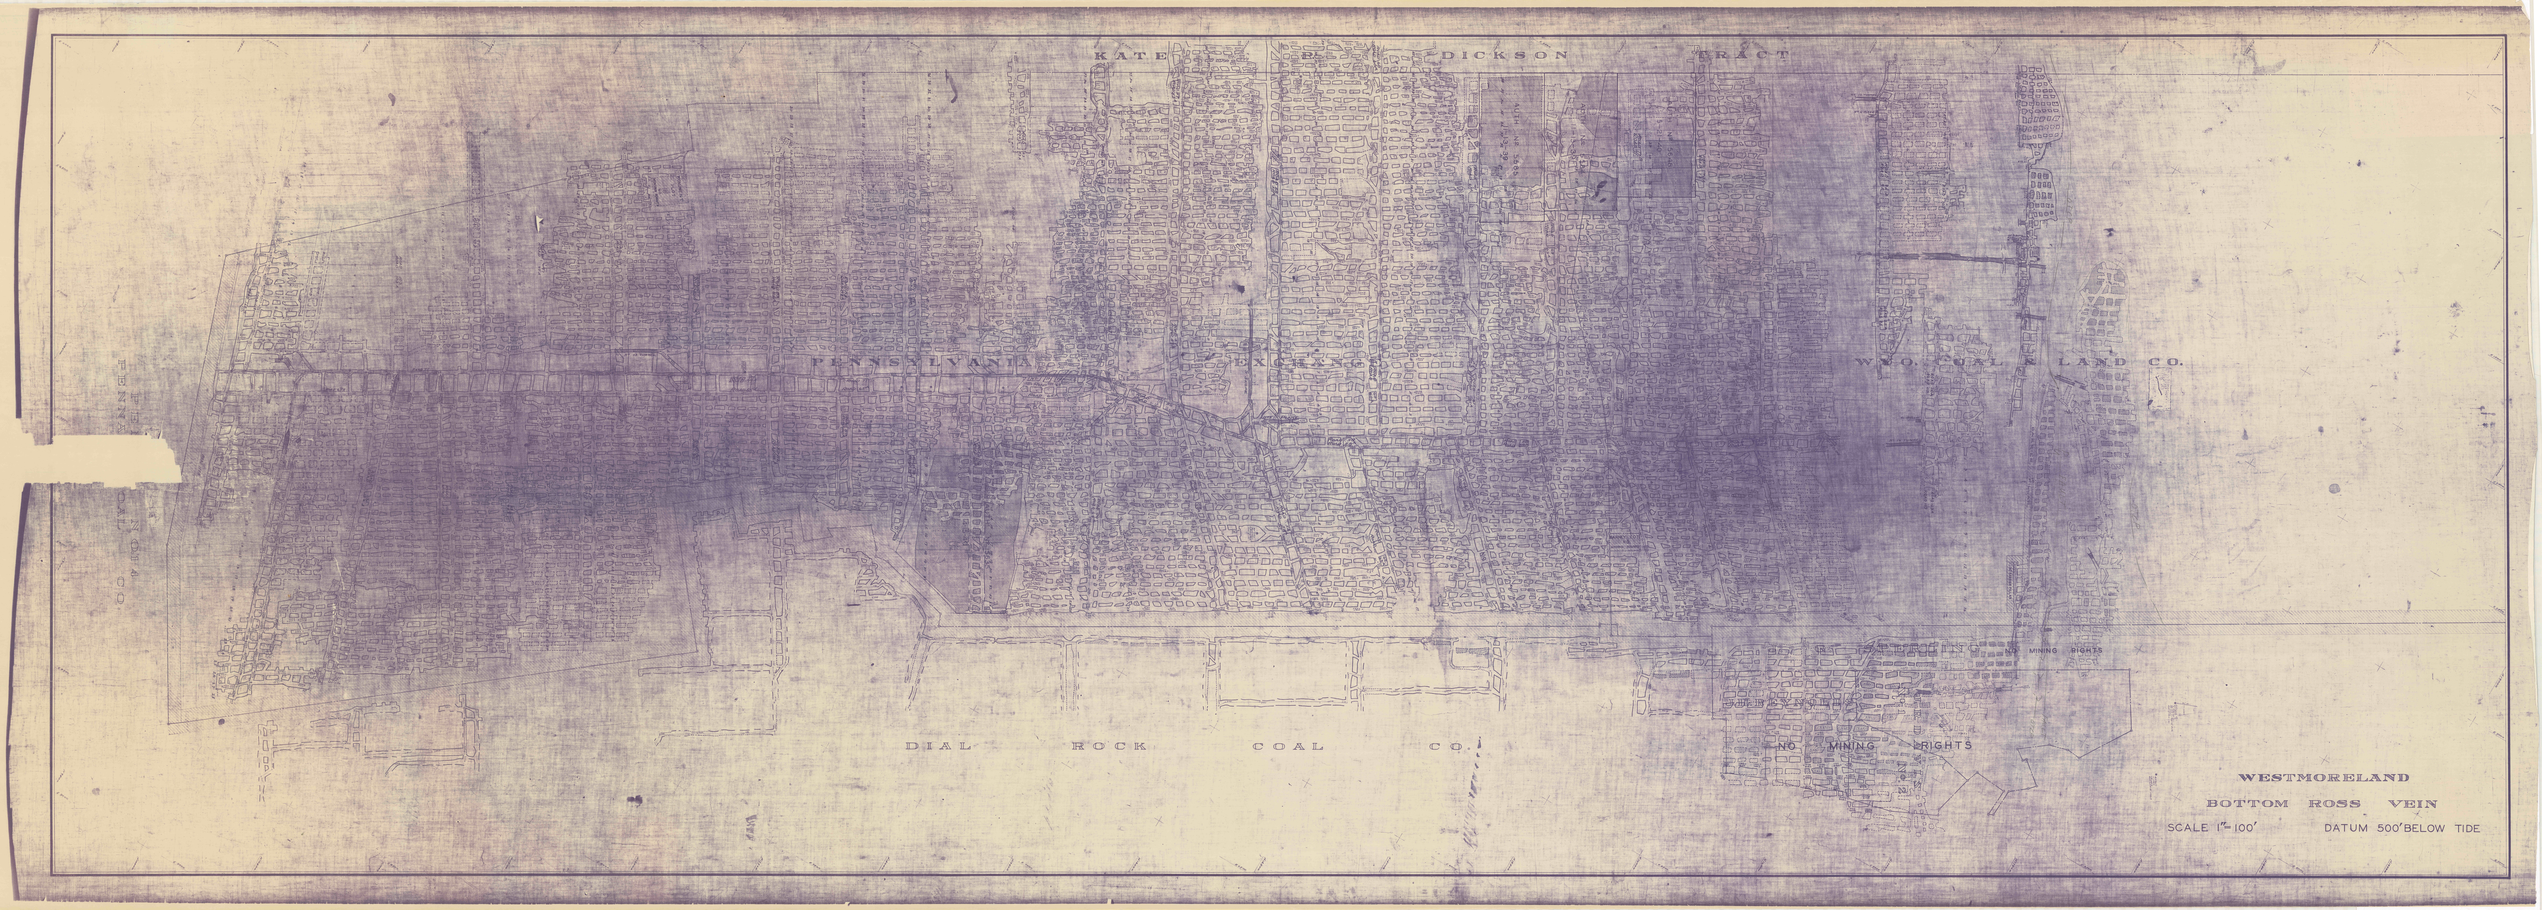

KATE
DICKSON
TRACT
PENNSYLVANIA
EXCHANGE
W.P.O. COAL & LAND CO.
DIAL ROCK COAL CO.
NO MINING RIGHTS
WESTMORELAND
BOTTOM ROSS VEIN
SCALE 1"=100'
DATUM 500' BELOW TIDE