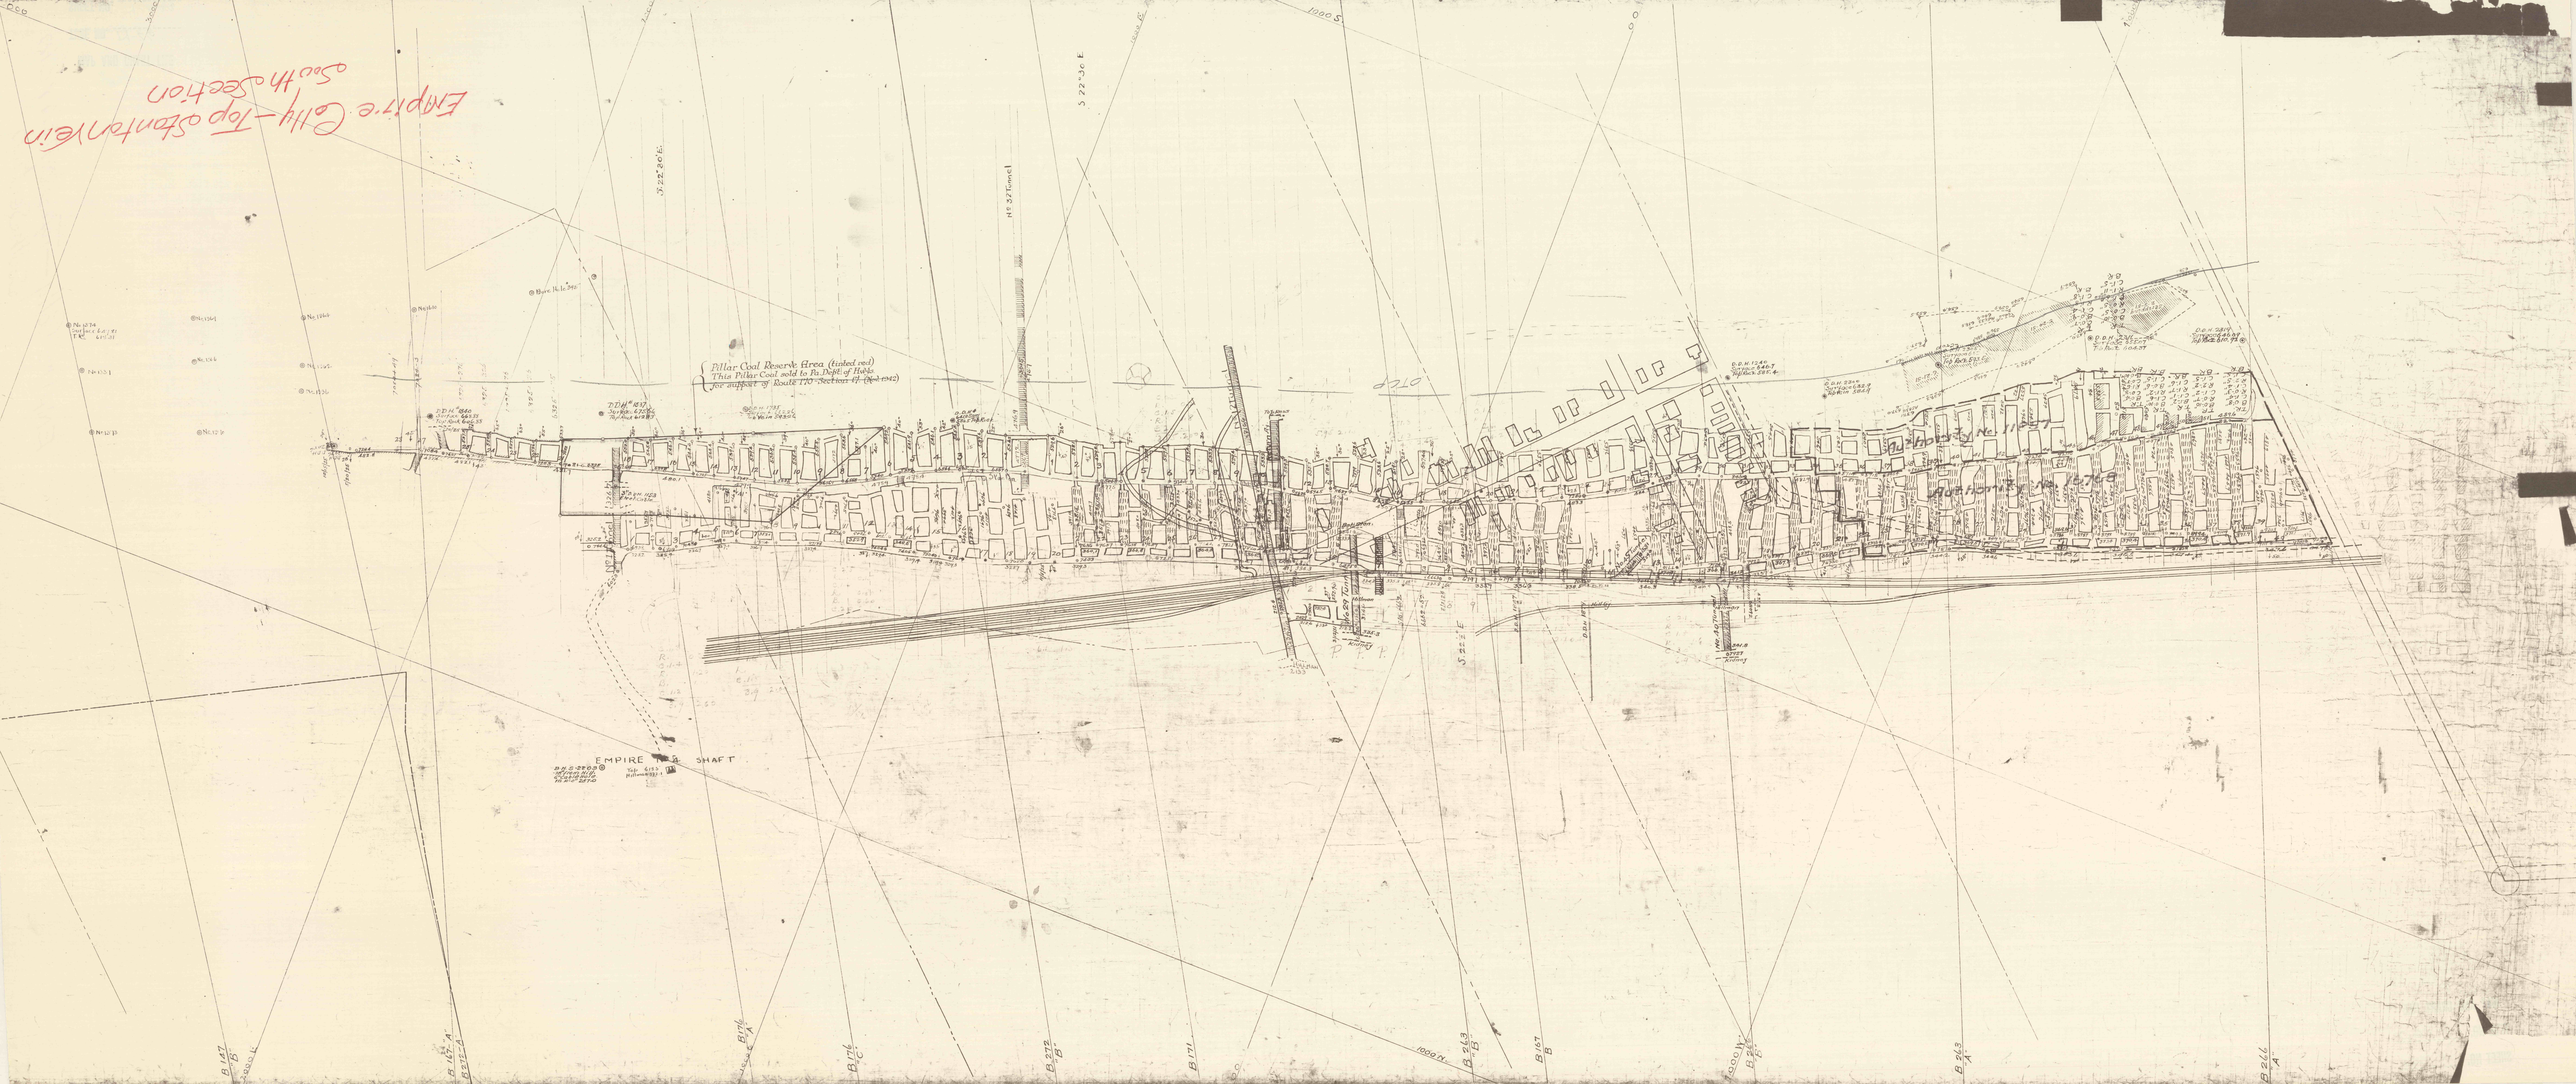South Section