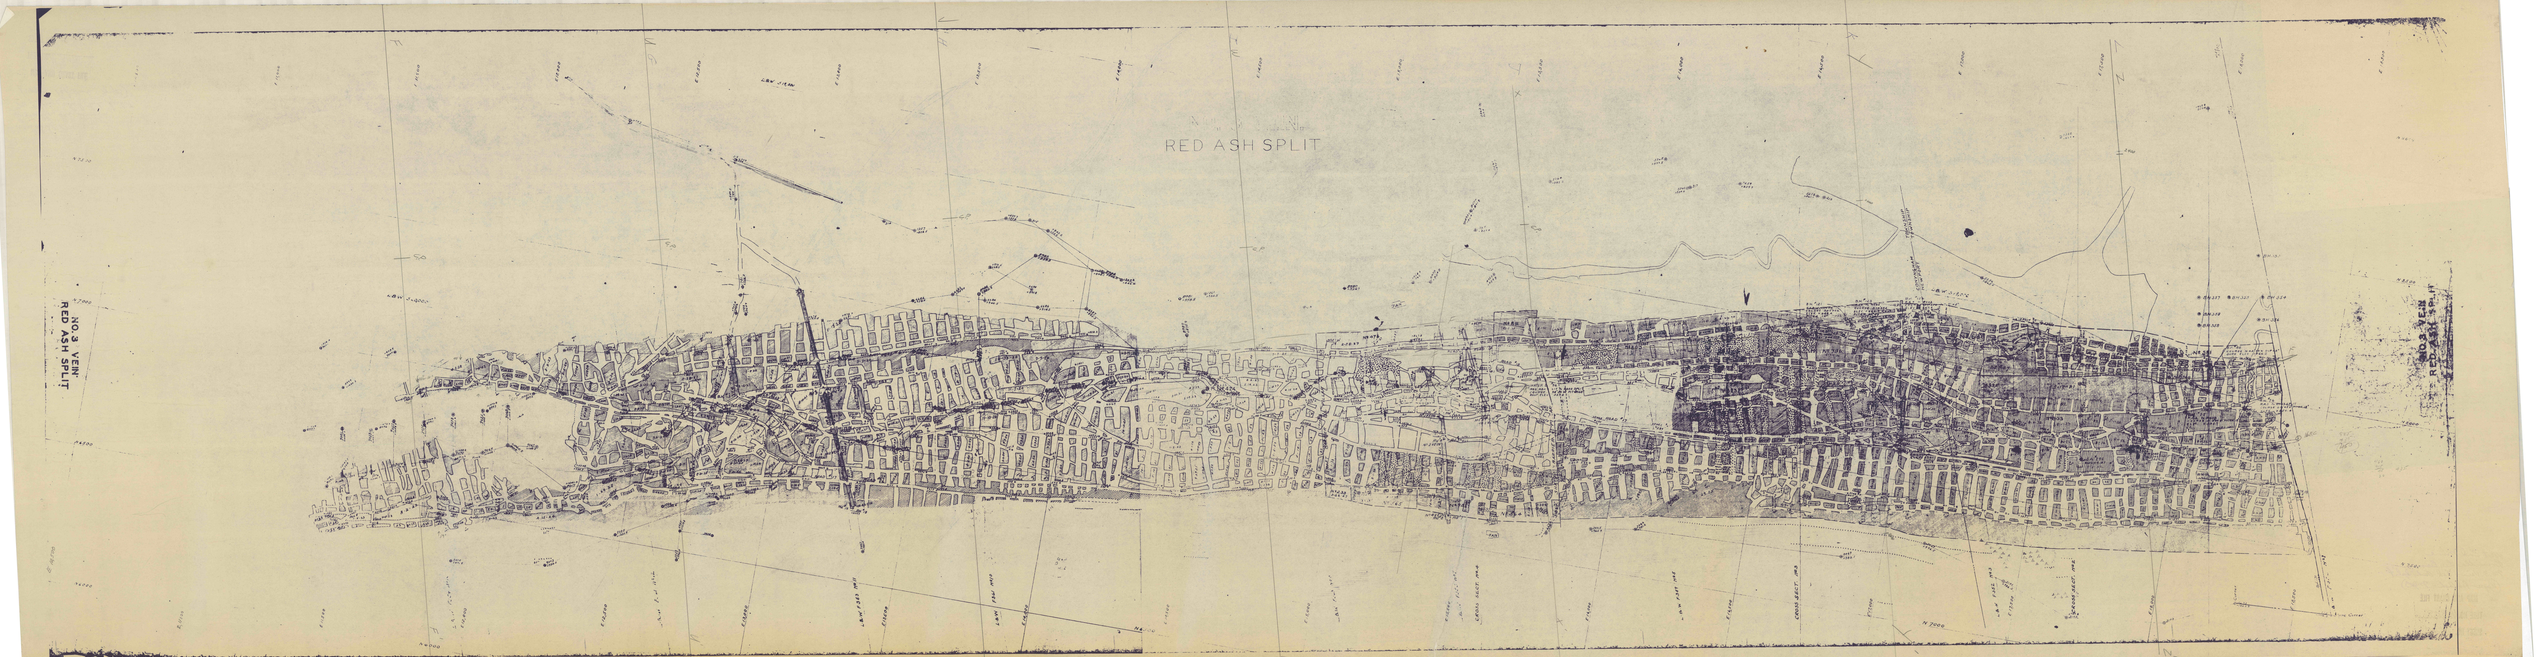
RED ASH SPLIT
NO.3 VEIN
RED ASH SPLIT
NO.3 VEIN
RED ASH SPLIT