


650004

64500M
50000

13.5005

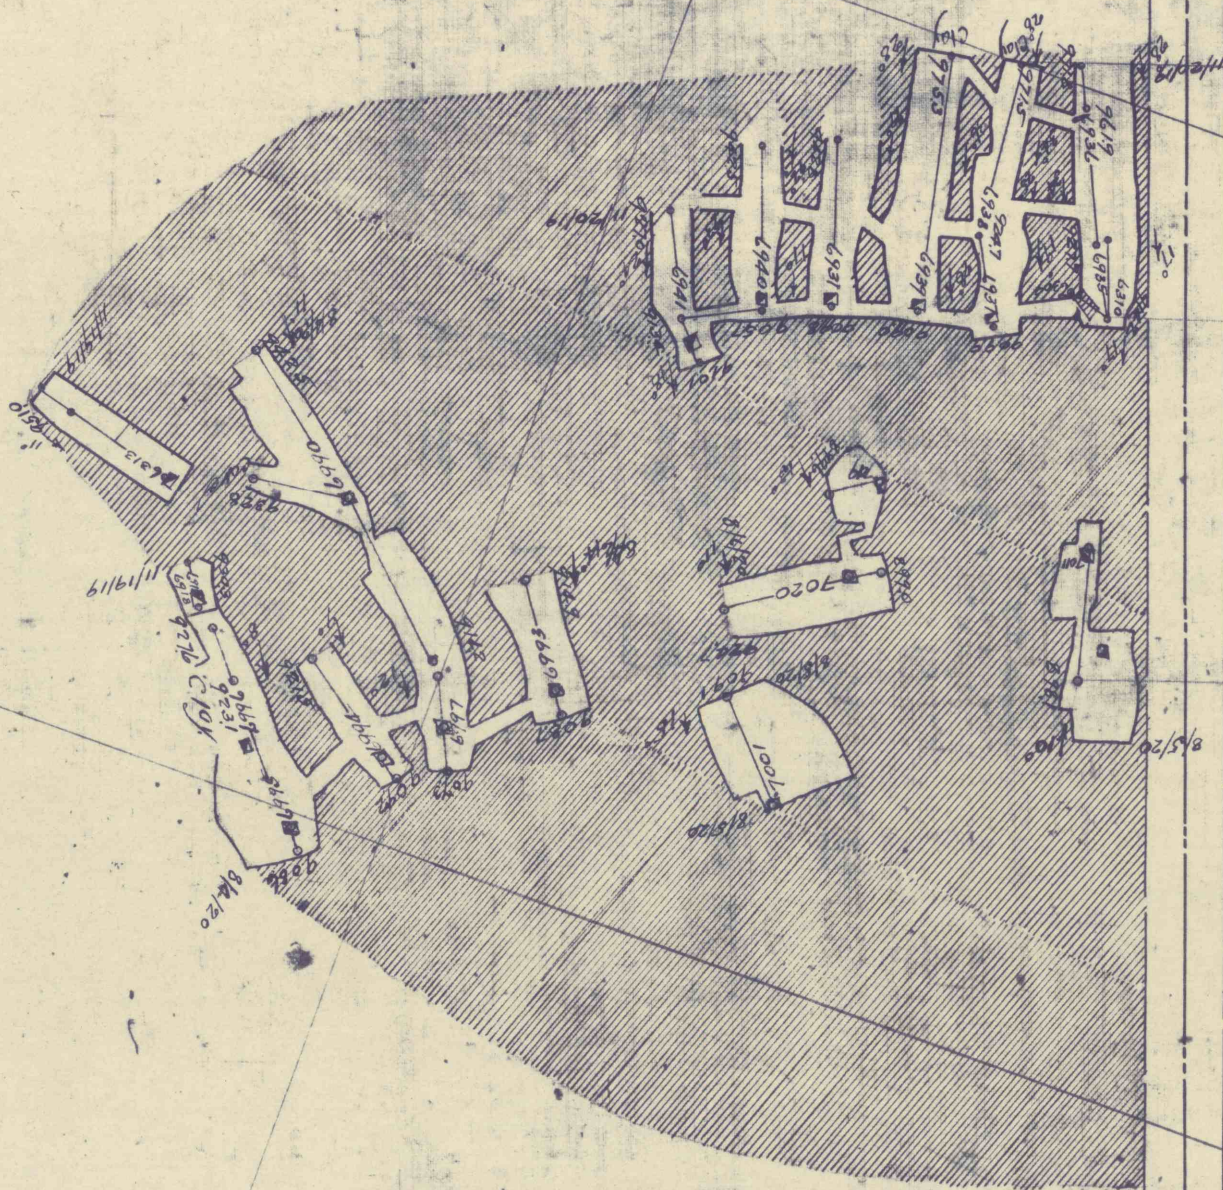

520001

- TOP ROSS -

F 291

145005

64,000 W