


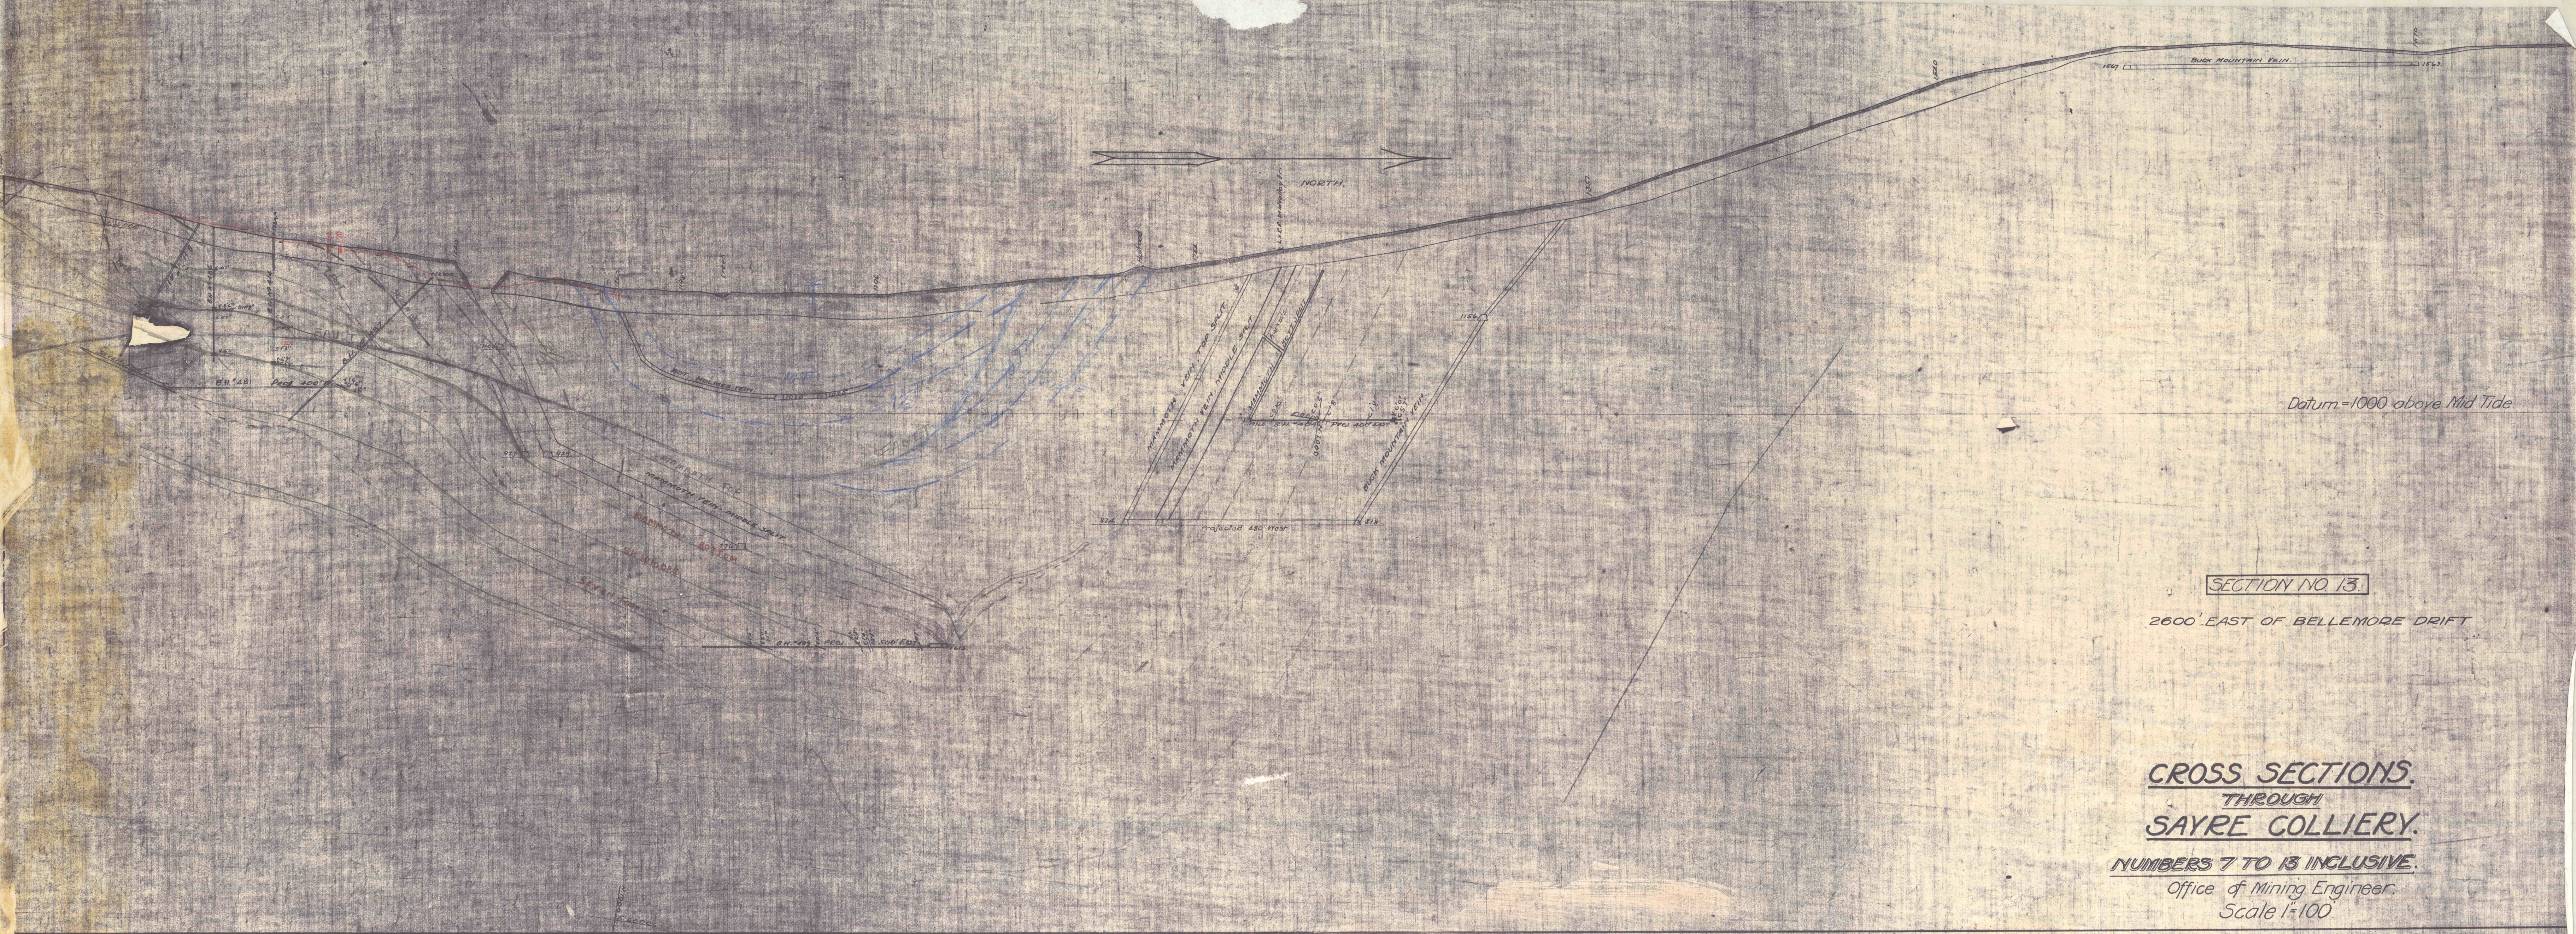

Datum = 1000 above Mid Tide

SECTION NO. 13.

2600' EAST OF BELLEMORE DRIFT

CROSS SECTIONS.
THROUGH
SAYRE COLLIERY.

NUMBERS 7 TO 13 INCLUSIVE.

Office of Mining Engineer.
Scale 1"=100'