


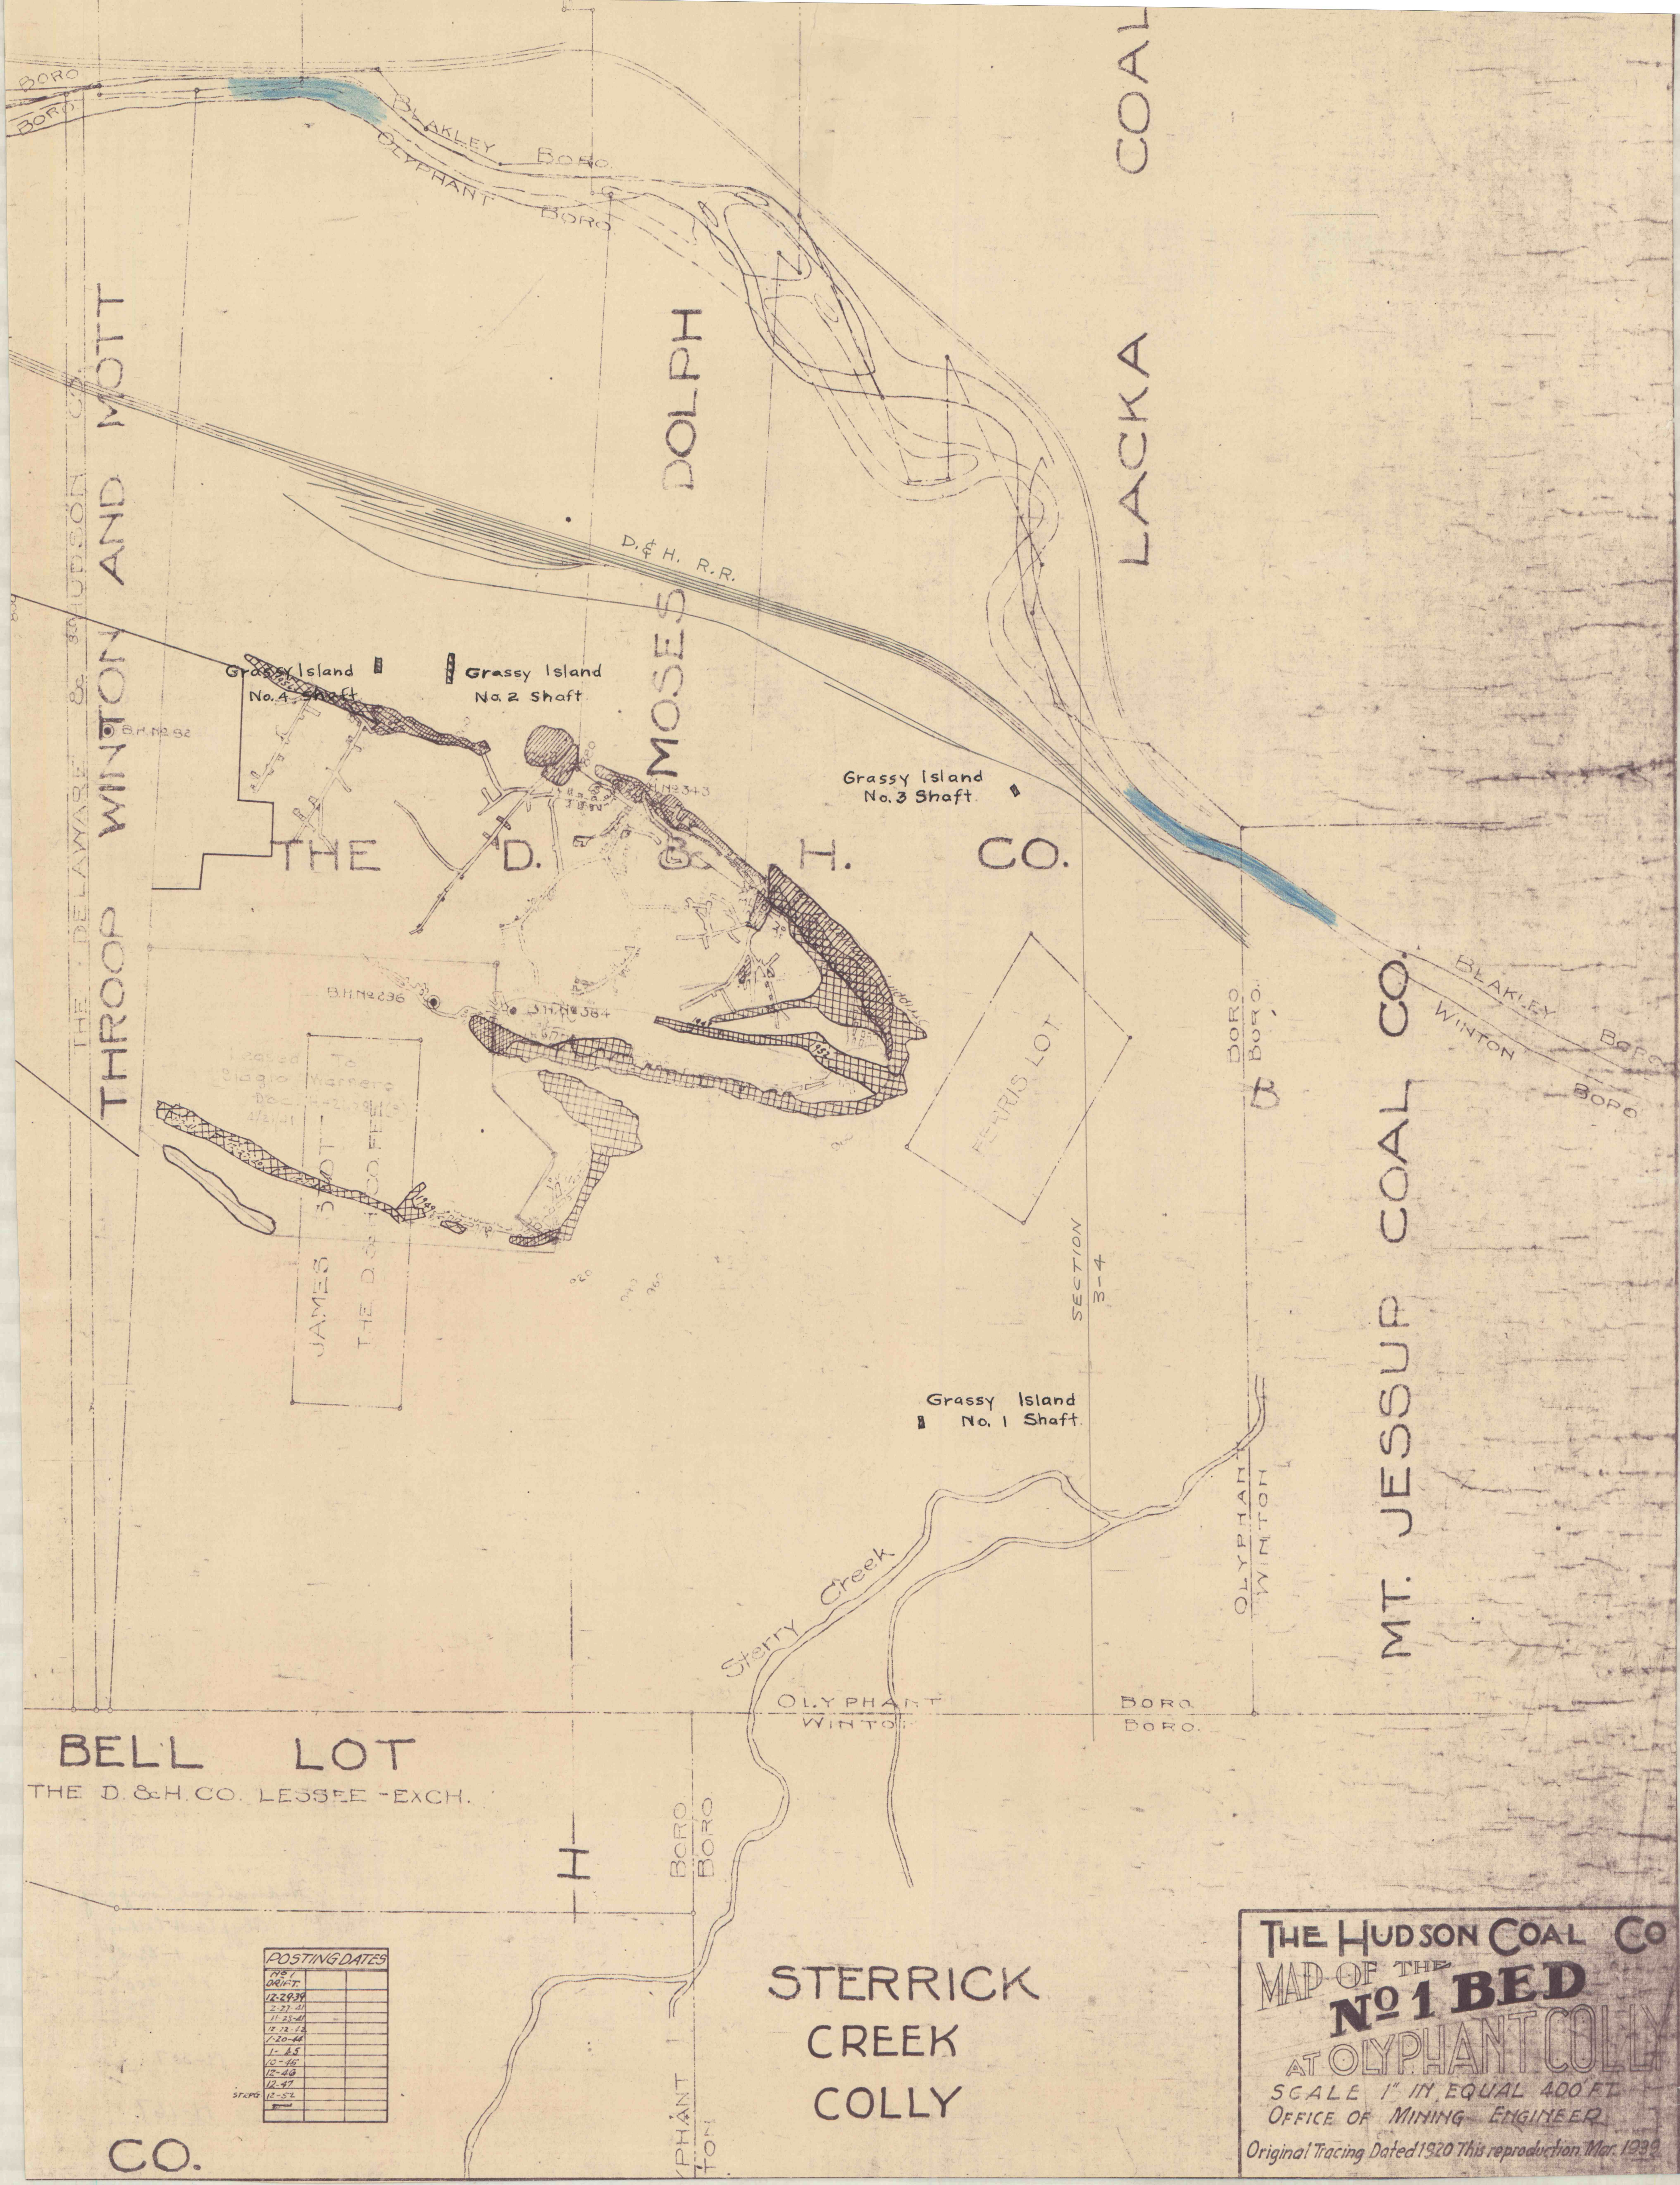

THE DELAWARE & HUDSON CO.
THROOP WINTON AND MOTT

DOLPH
MOSES

COAL
LACKA

MT. JESSUP COAL CO.

BELL LOT
THE D. & H. CO. LESSEE - EXCH.

STERRICK
CREEK
COLLY

THE HUDSON COAL CO
MAP OF THE
No. 1 BED
AT OLYPHANT COLLY
SCALE 1" IN. EQUAL 400 FT.
OFFICE OF MINING ENGINEER
Original Tracing Dated 1920 This reproduction Mar. 1930

POSTING DATES	
12-29-39	
2-27-41	
11-25-41	
12-22-42	
7-20-44	
1-25	
10-10	
12-46	
12-47	
12-52	